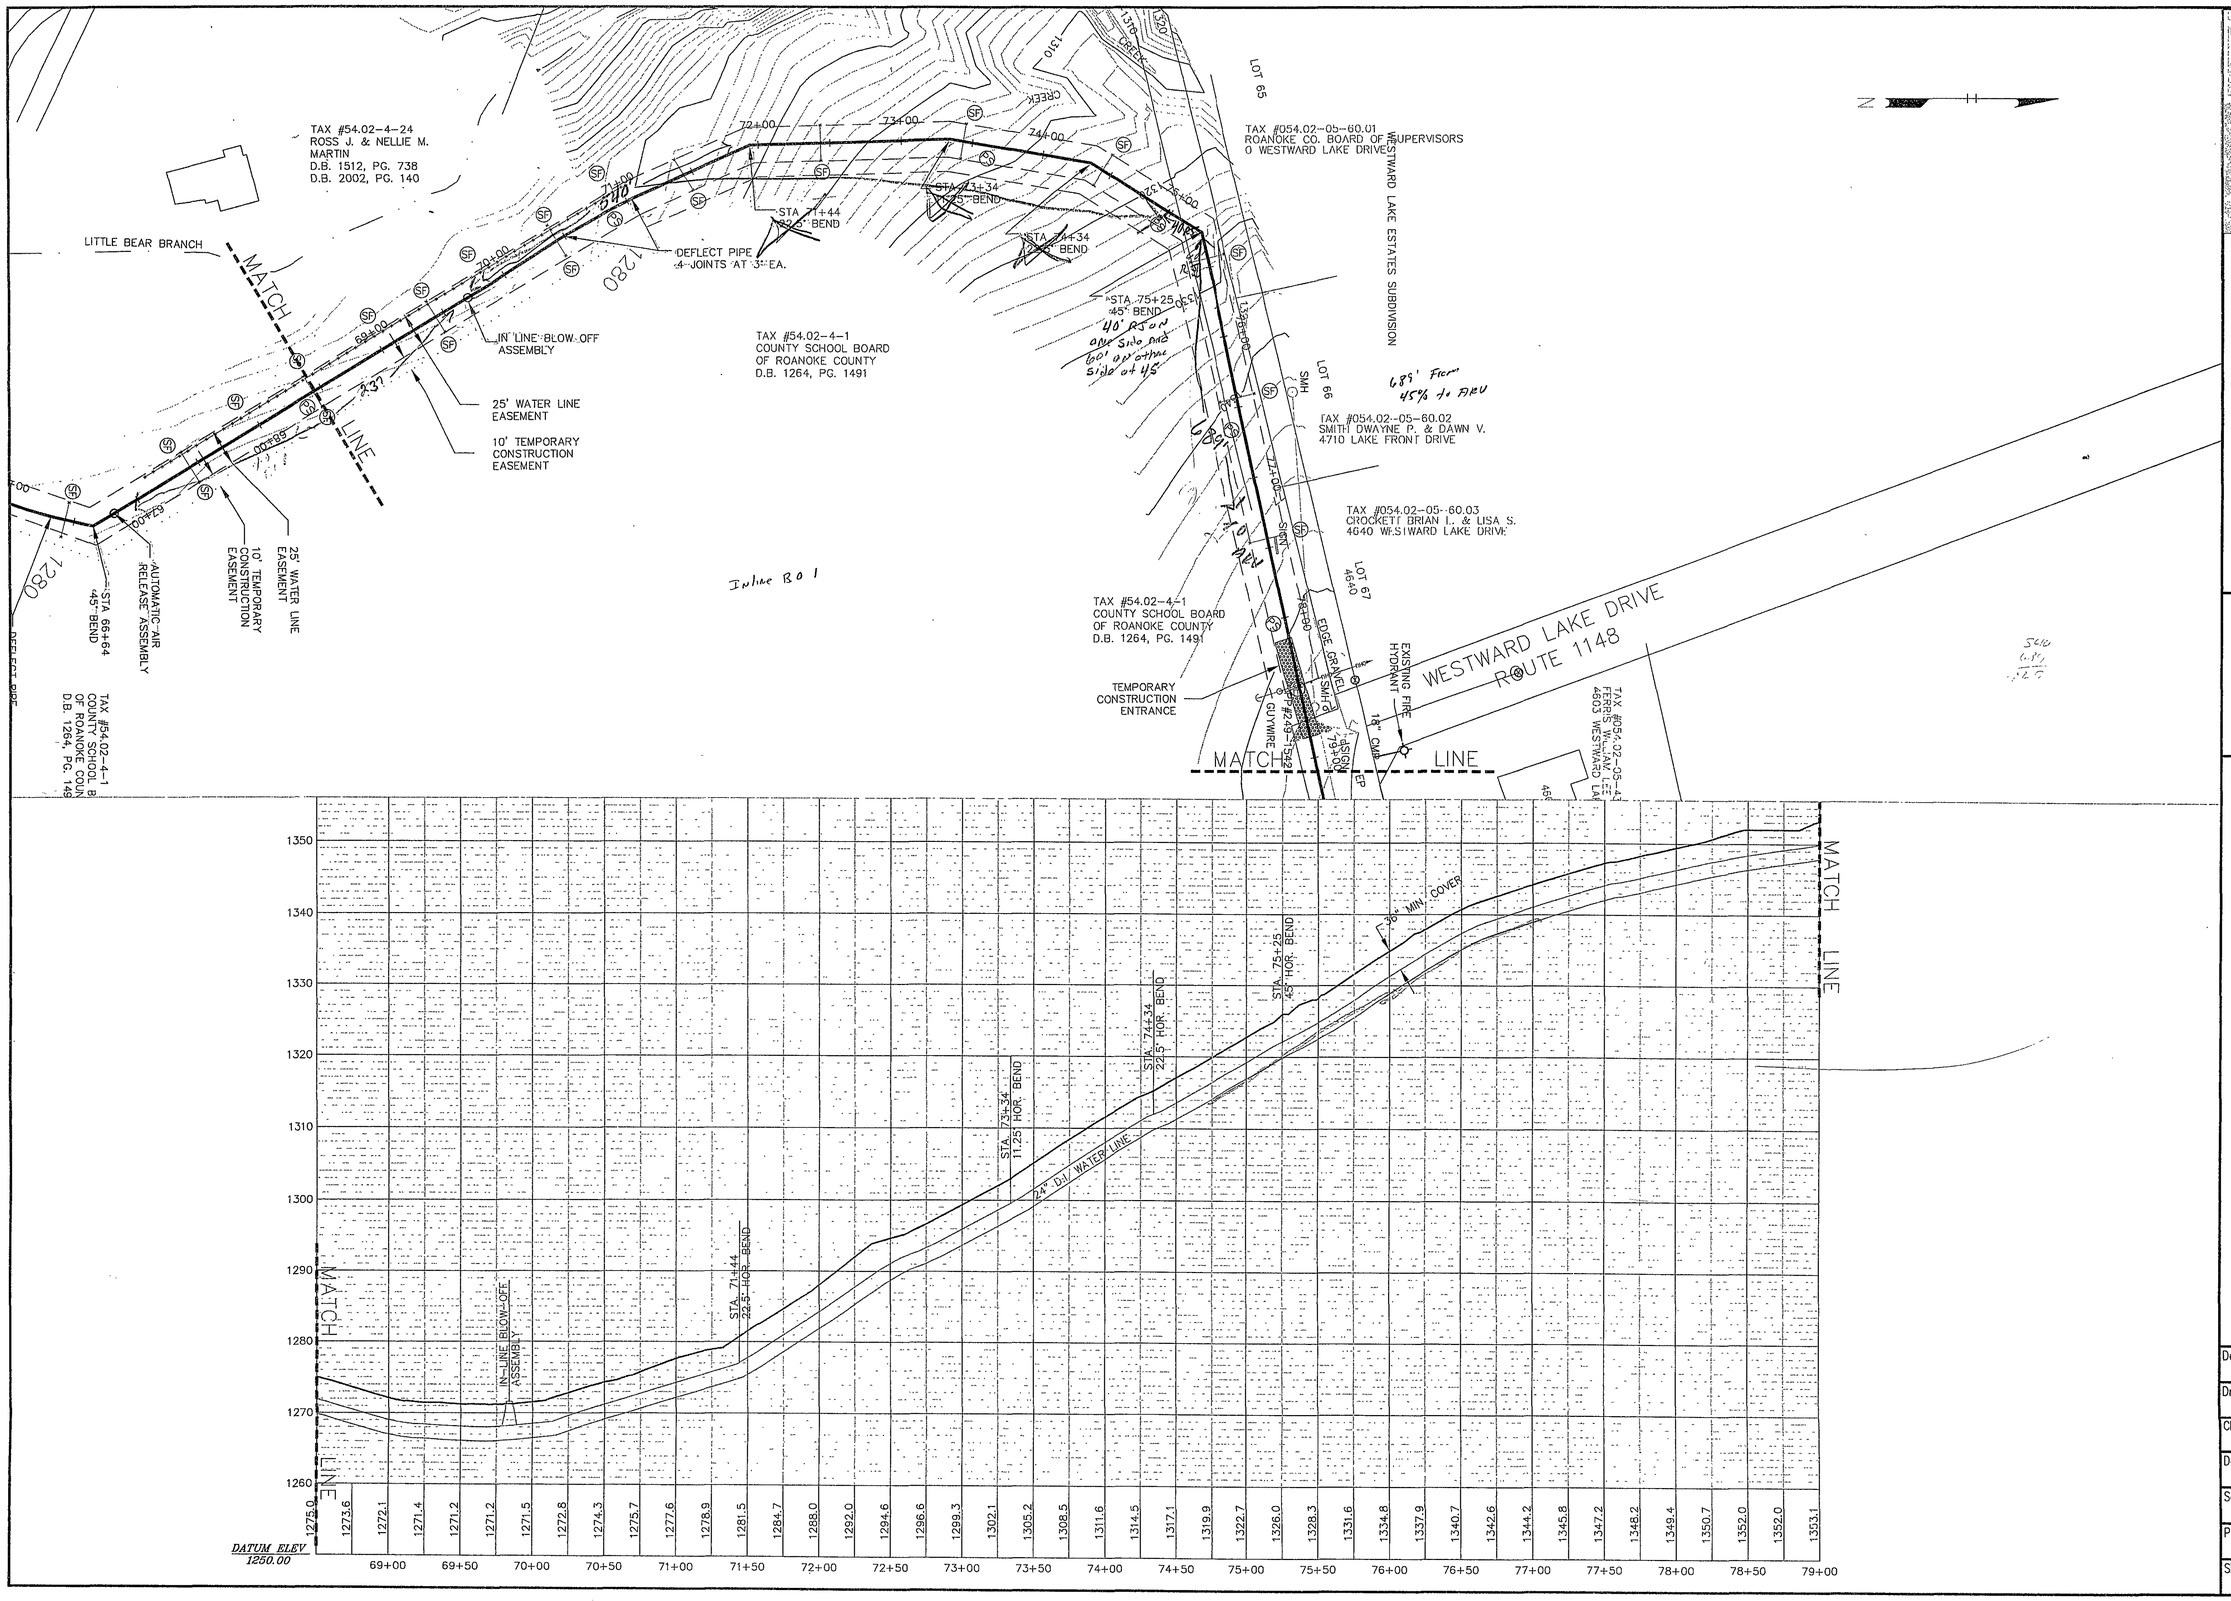

WESTERN VIRGINIA WATER AUTHORITY

ENGINEERING SERVICES
601 SOUTH JEFFERSON STREET
SUITE 300
ROANOKE, VIRGINIA 24011
PHONE: (540) 853-5641

COMMONWEALTH OF VIRGINIA
Roger R. Blankenship
040615
7-21-06
PROFESSIONAL ENGINEER

NORHT LOOP PHASE 5
PLAN & PROFILE

Designed By:	RRB
Drawn By:	RRB
Checked By:	JGR
Date:	06/02/06
Scale:	HOR. 1" = 50' VERT. 1" = 10'
Plan #:	00-00
Sheet:	9 OF 12