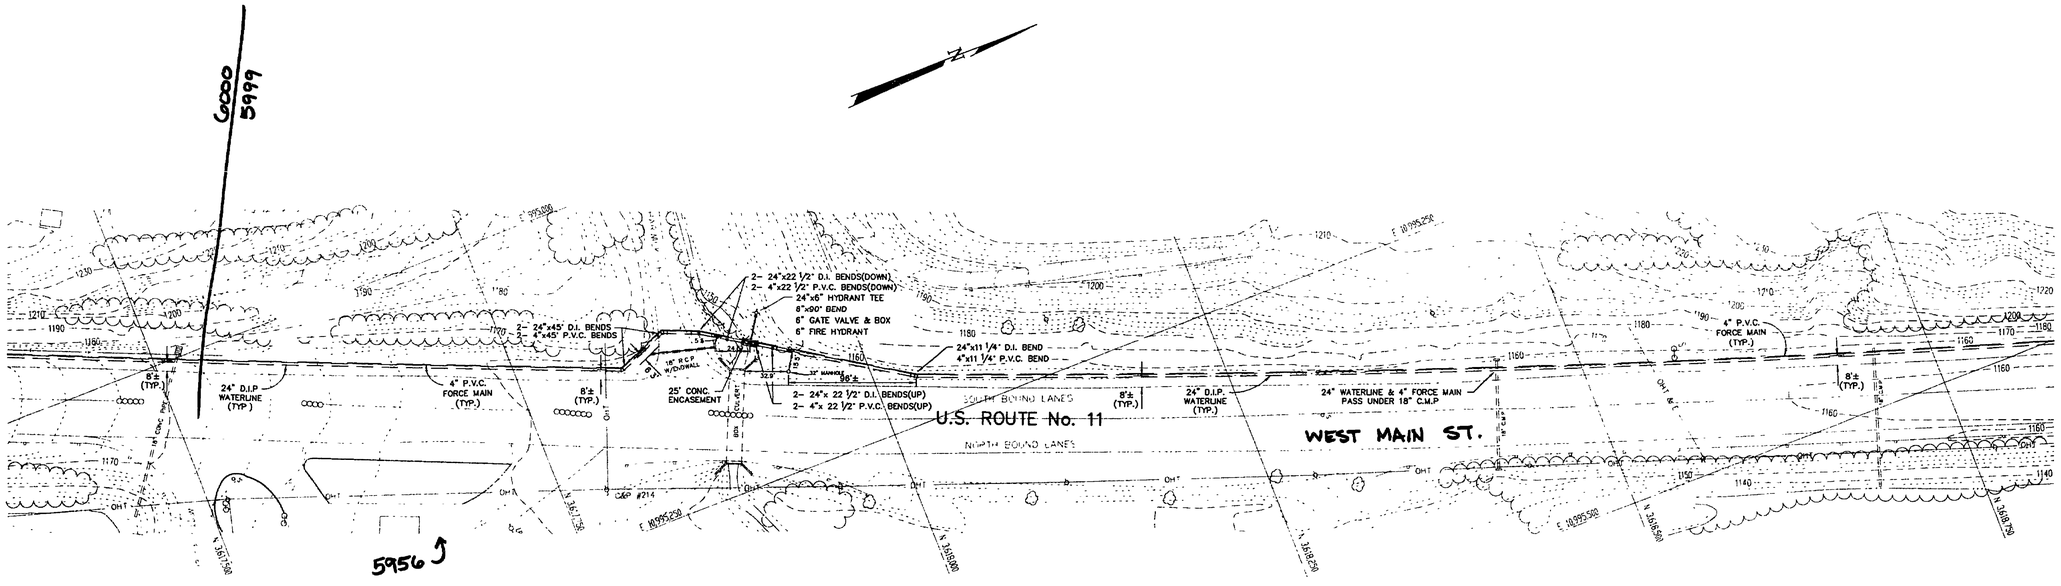

AS-BUILT
FEB. 3, 1995
WATERLINE & FORCEMAIN

50' 25' 0' 50' 100' 1" = 50'
GRAPHIC SCALE

PLAN FOR
COUNTY OF ROANOKE
WATERLINE AND
FORCE MAIN EXTENSION
CATAWBA MAGISTERIAL DISTRICT
ROANOKE COUNTY, VIRGINIA
SCALE: AS SHOWN

DESIGNED BY CLW
DRAWN BY JJB
CHECKED BY FBC
W.O. # 92-1077
N.B. - - -
TAX NO.

TPP&S
ENGINEERS
SURVEYORS
PLANNERS

T. P. PARKER & SON
816 Boulevard
Post Office Box 39
Salem, Virginia 24153
Telephone: 703-387-1153
FAX: 703-389-5767

SHEET 4 OF 6

WT-0427