


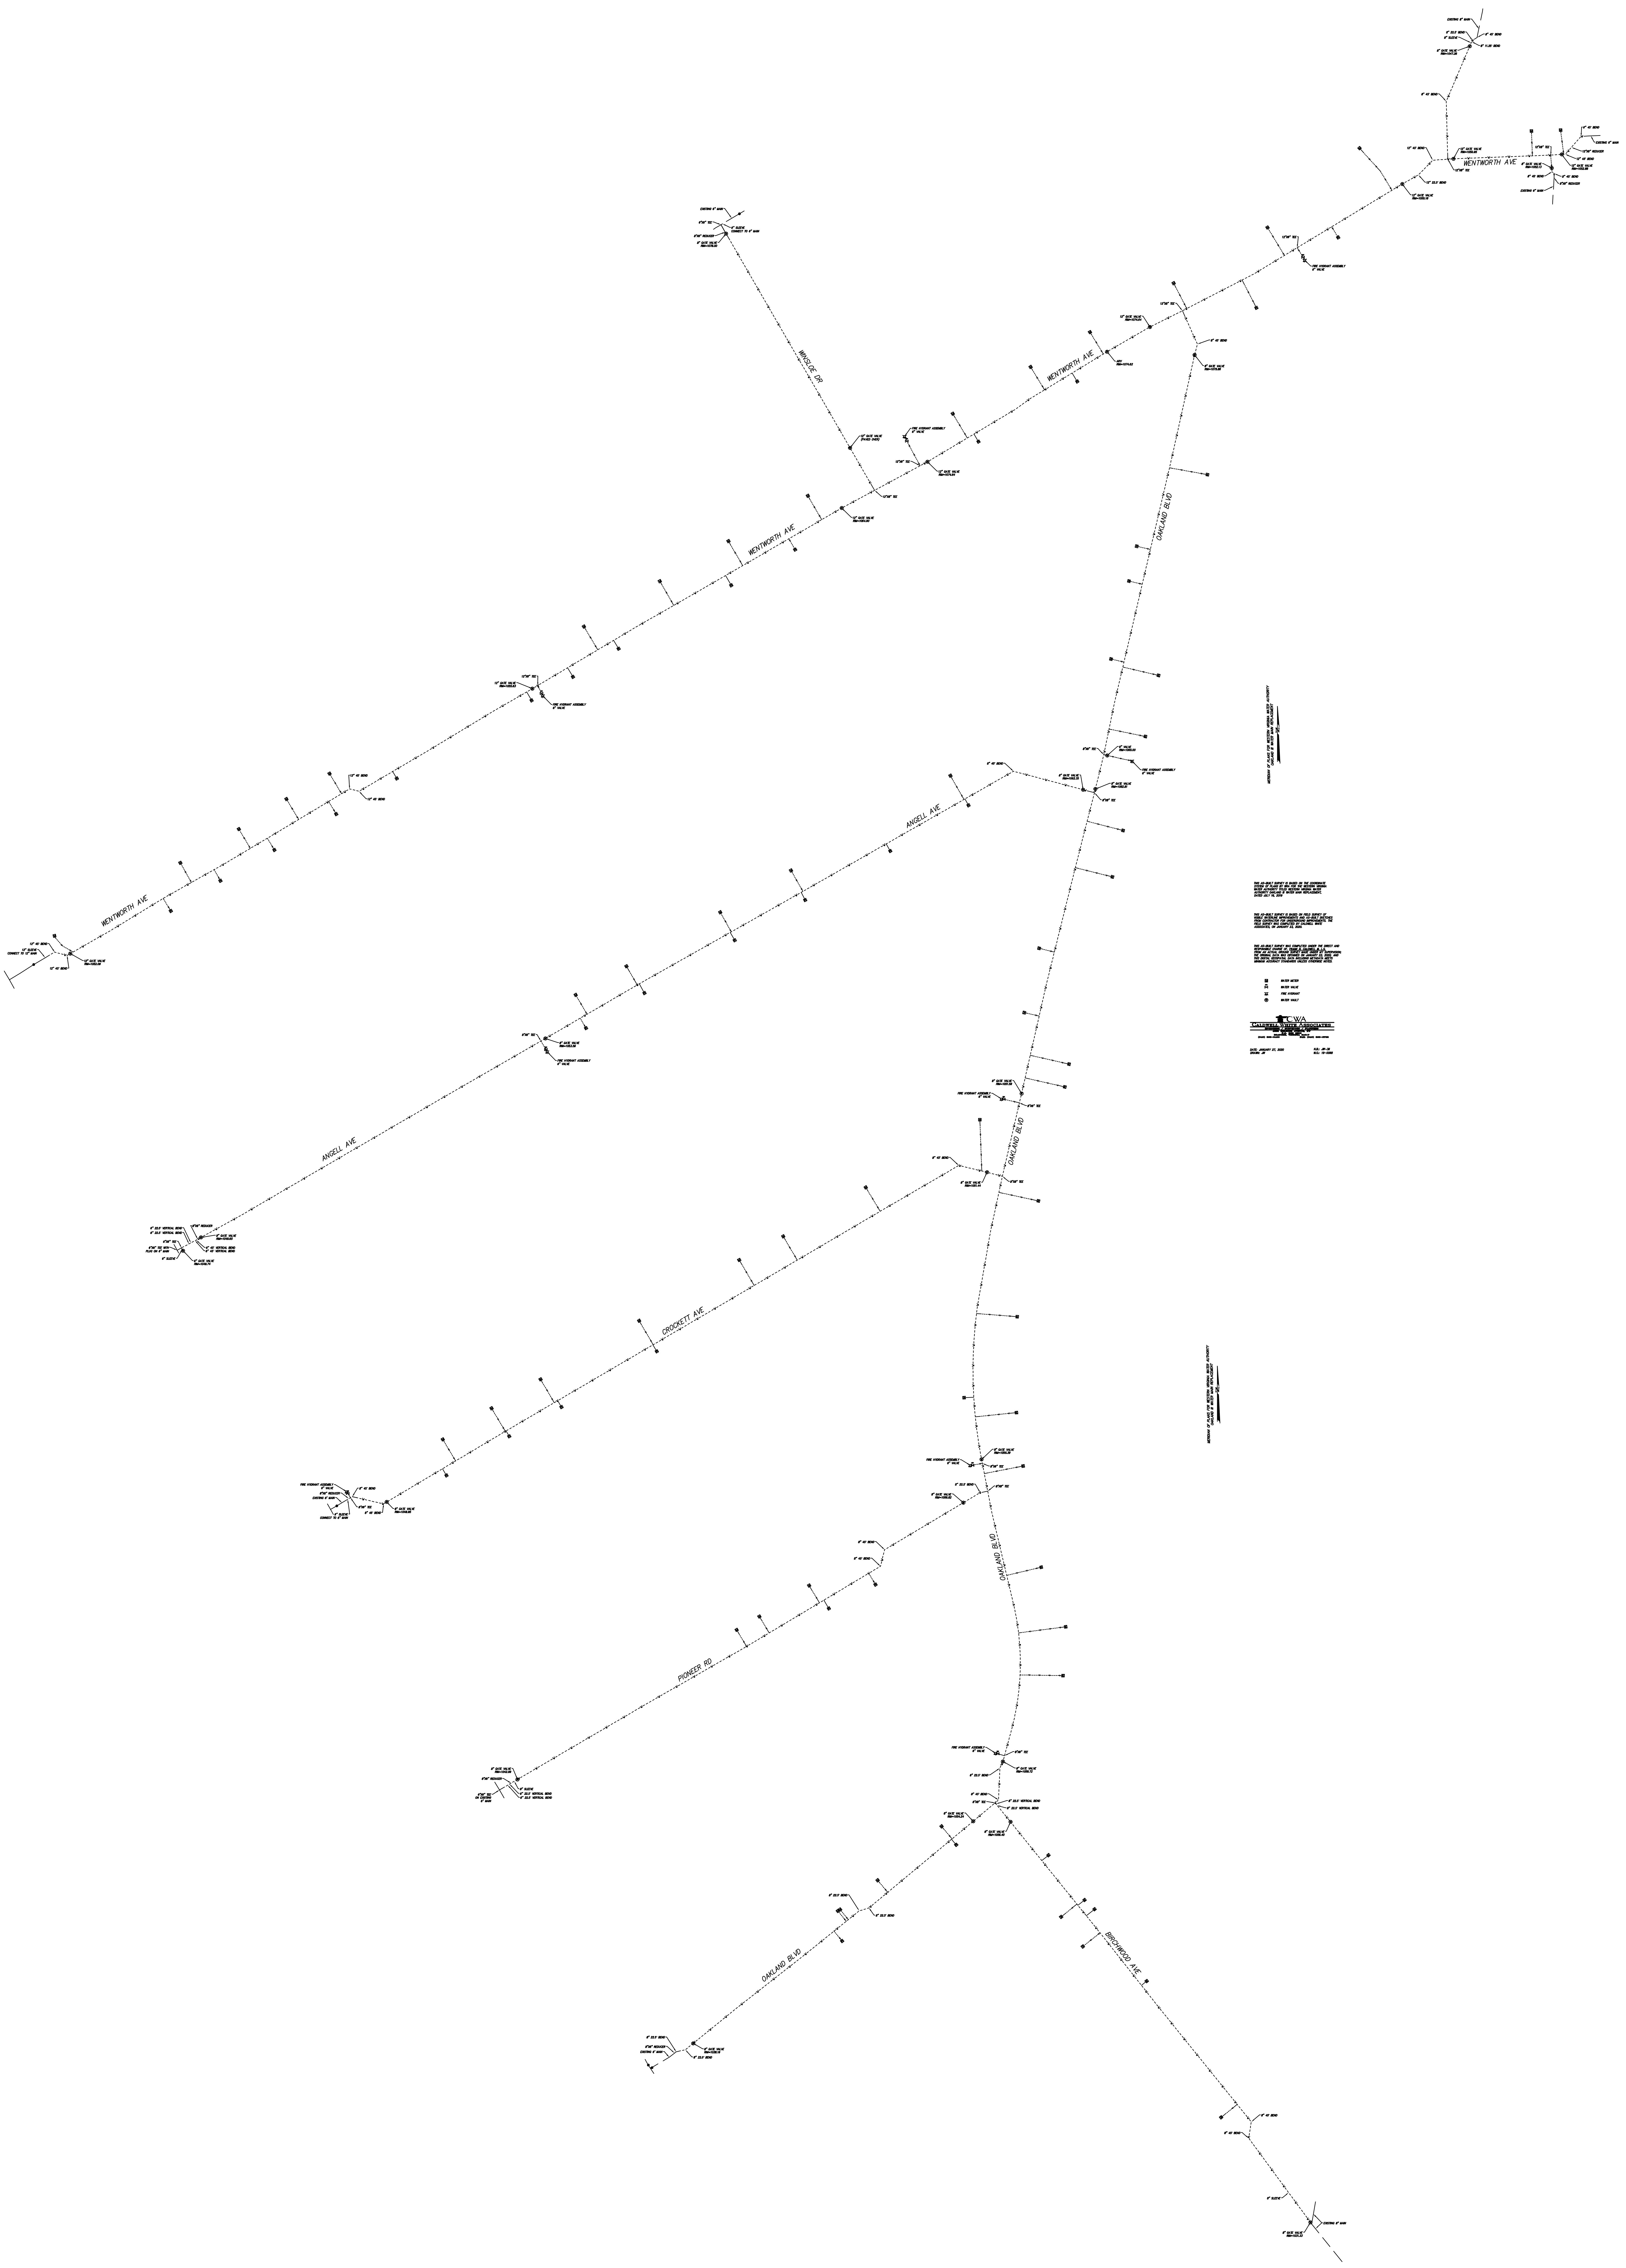

SECTION 1 OF 2 - SEE SHEET 2 FOR CONTINUATION

