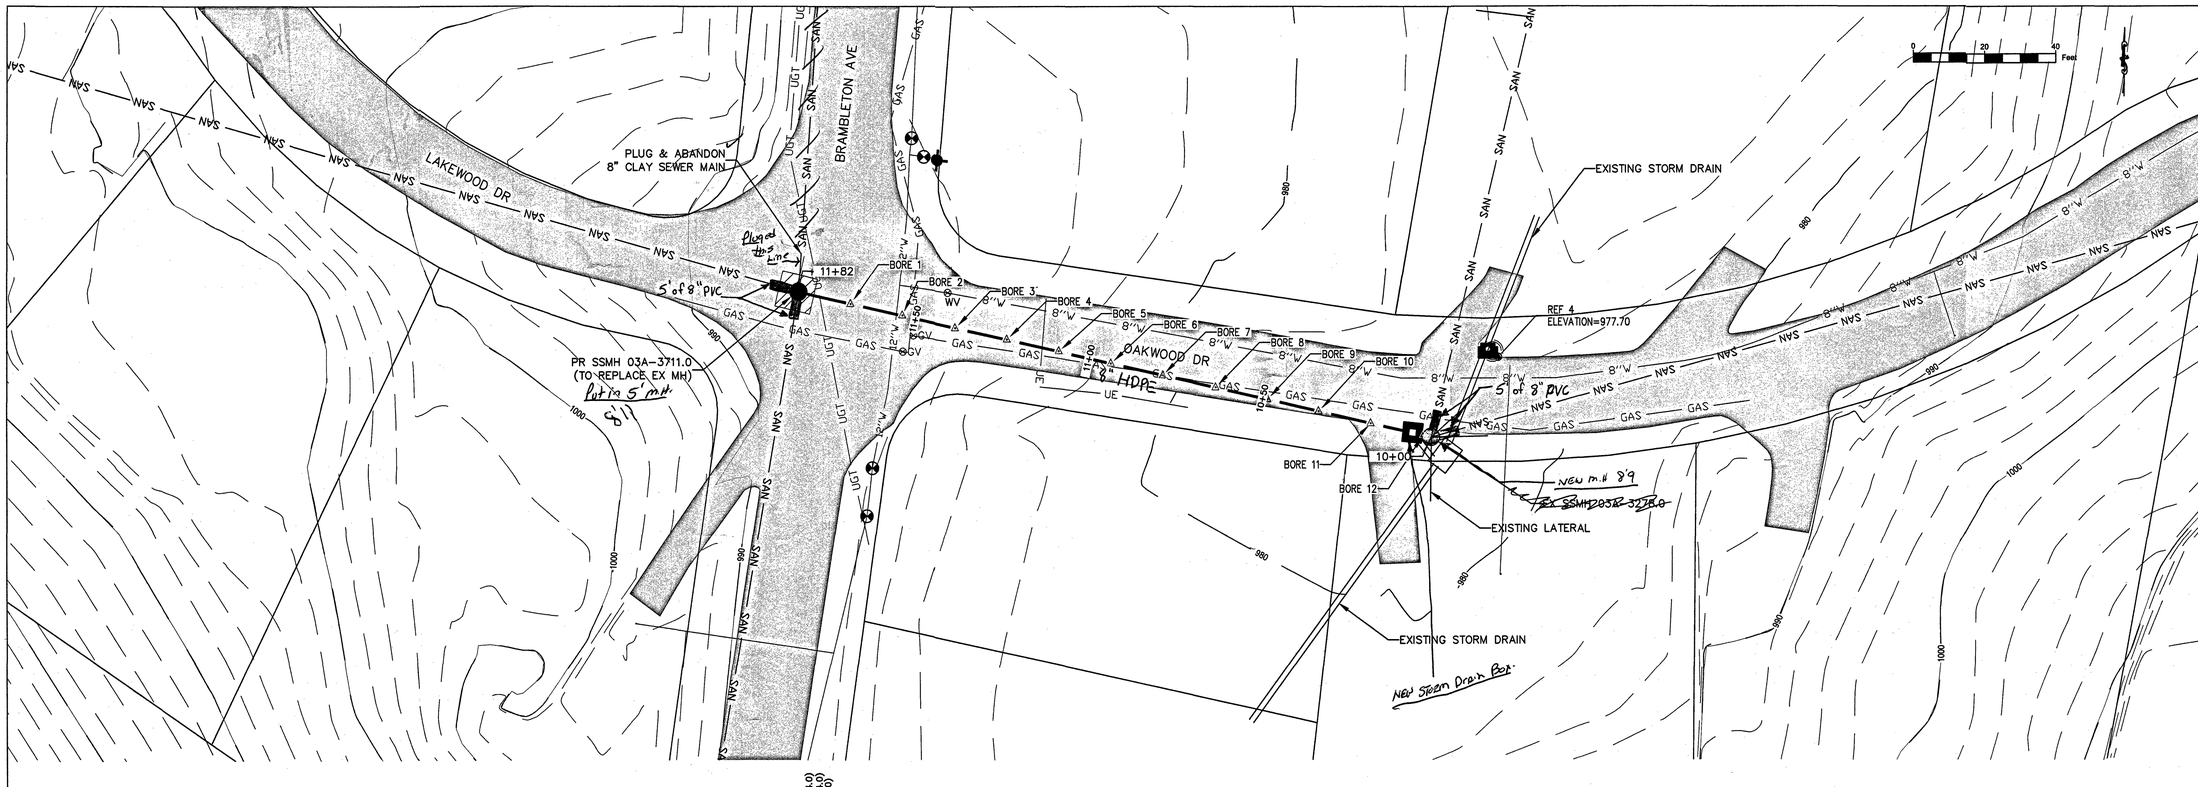

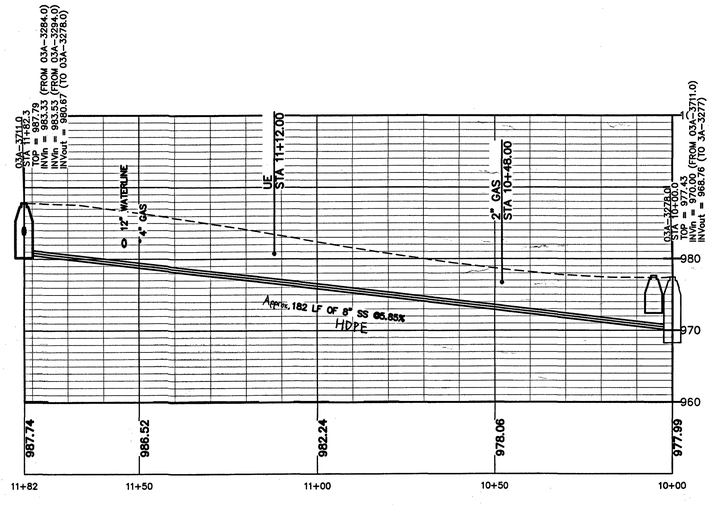

OAKLAND
SCALE
VERTICAL: 1" = 10'
HORIZONTAL: 1" = 20'

As-built
Dec.8,2016
Installed by Feild Operations

WESTERN VIRGINIA
WATER AUTHORITY
Engineering Services

Project:	Oakwood Sewer Bore
Date:	12/1/2016
By:	DRJ
Checked:	AAS

Drill Offset Data

Point #	Depth to Invert	Offset from CL (Left - , Right +)	Station	Surface Elevation	Invert Elevation
BORE 1	7.80	0.00	11+67.30	987.56	979.77
BORE 2	7.68	0.00	11+52.38	986.58	978.89
BORE 3	7.50	0.00	11+37.24	985.51	978.01
BORE 4	7.20	0.00	11+22.36	984.33	977.14
BORE 5	6.76	0.00	11+07.38	983.02	976.26
BORE 6	6.33	0.00	10+92.35	981.71	975.38
BORE 7	6.02	0.00	10+77.38	980.53	974.50
BORE 8	5.84	0.00	10+62.20	979.46	973.62
BORE 9	5.80	0.00	10+47.23	978.54	972.74
BORE 10	5.94	0.00	10+32.36	977.81	971.87
BORE 11	6.42	0.00	10+17.36	977.41	970.99
BORE 12	7.23	0.00	10+02.31	977.35	970.11

WESTERN VIRGINIA
WATER AUTHORITY
ENGINEERING SERVICES
601 S JEFFERSON ST, SUITE 300
ROANOKE, VA 24011
540-853-5641 or 540-853-5770

OAKWOOD SEWER REALIGNMENT

PLAN & PROFILE

Rev	Description	Date	By

Designed: AAS
Drawn: AAS
Checked: DJ
Approved: JE
Date: 6/23/15
Project:

1
Sheet 1 of 2