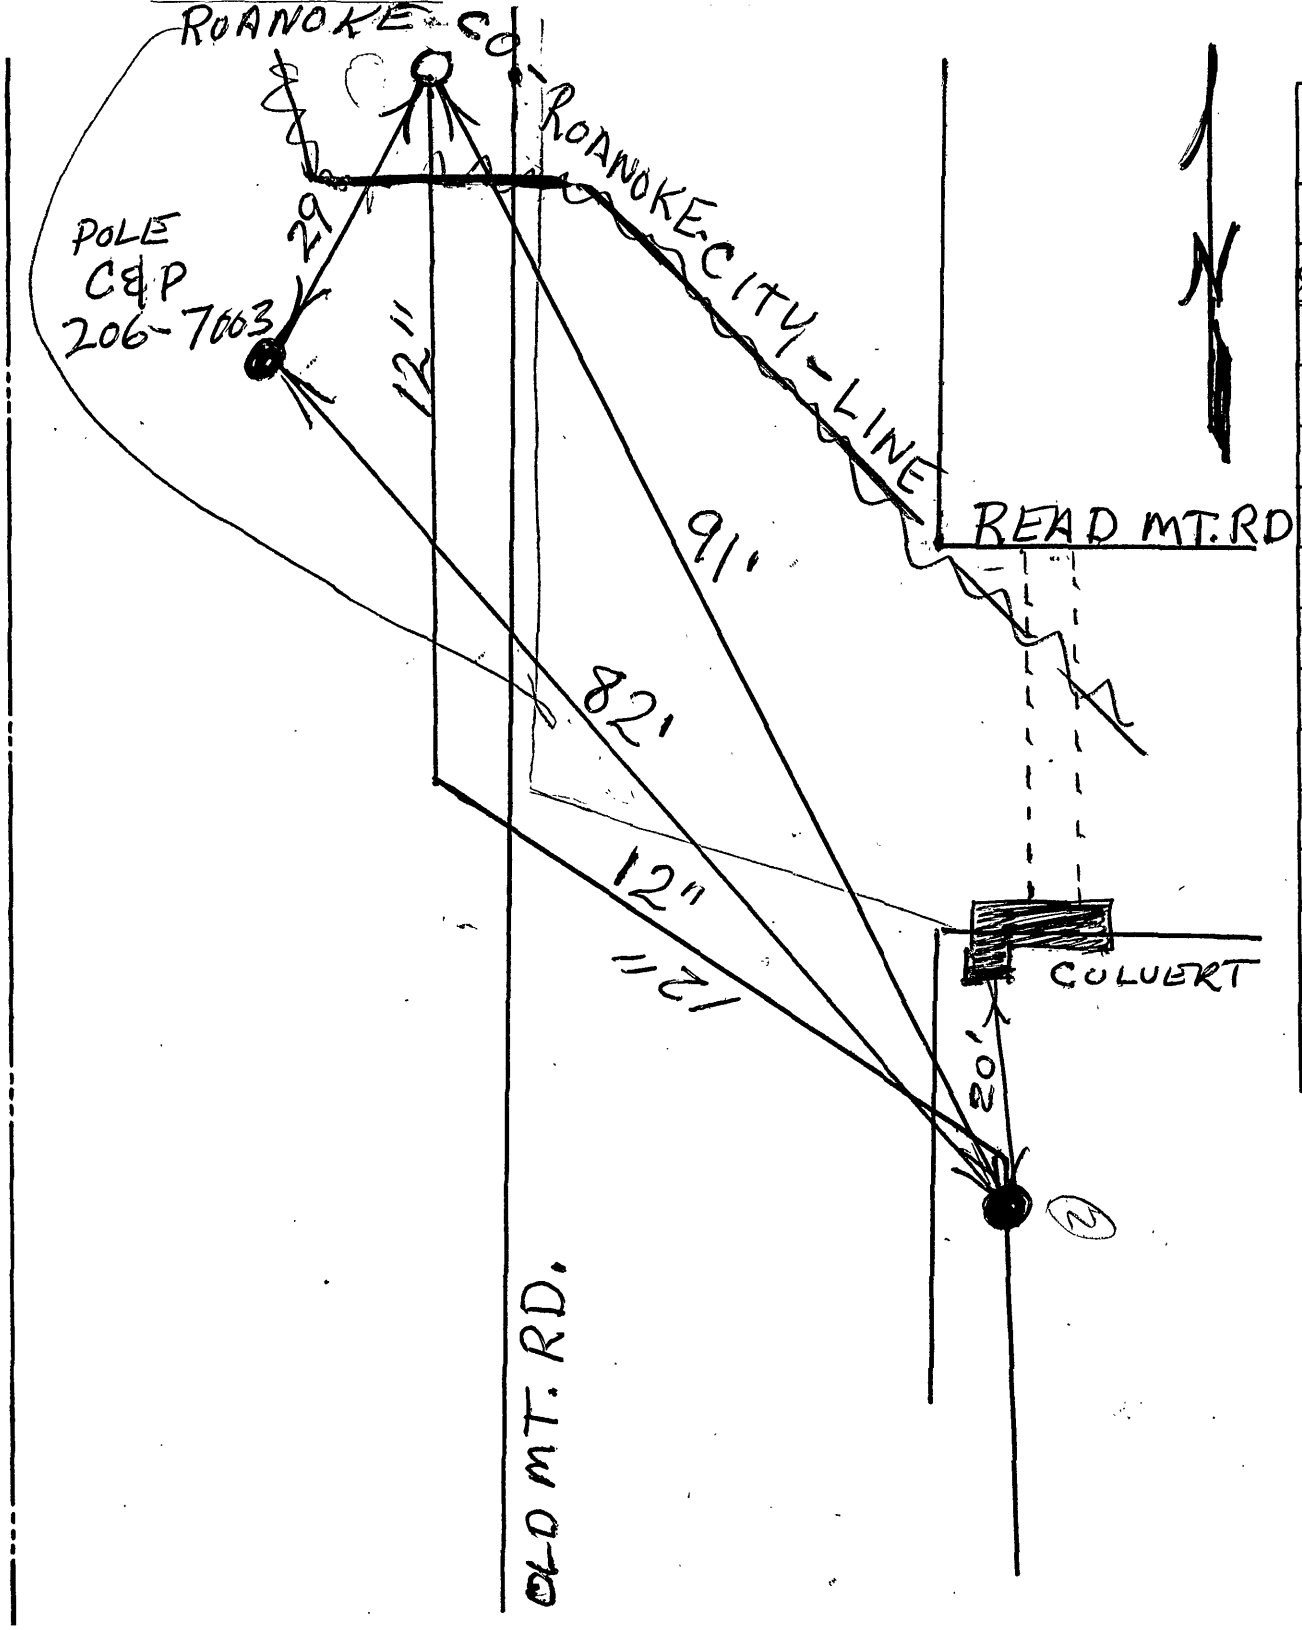

DATE	NO.	SIZE	MAKE	OPEN	TURNS
8-87	1	2"	MISC.	L	—
8-87	2	12	MUEL.	R	—

done

CITY OF ROANOKE—WATER DEP'T
VALVE DIAGRAM

OLD MT. RD. and
READ MT. RD.

SEC. MAP 741

DATE 8-6-87 PAGE NO.