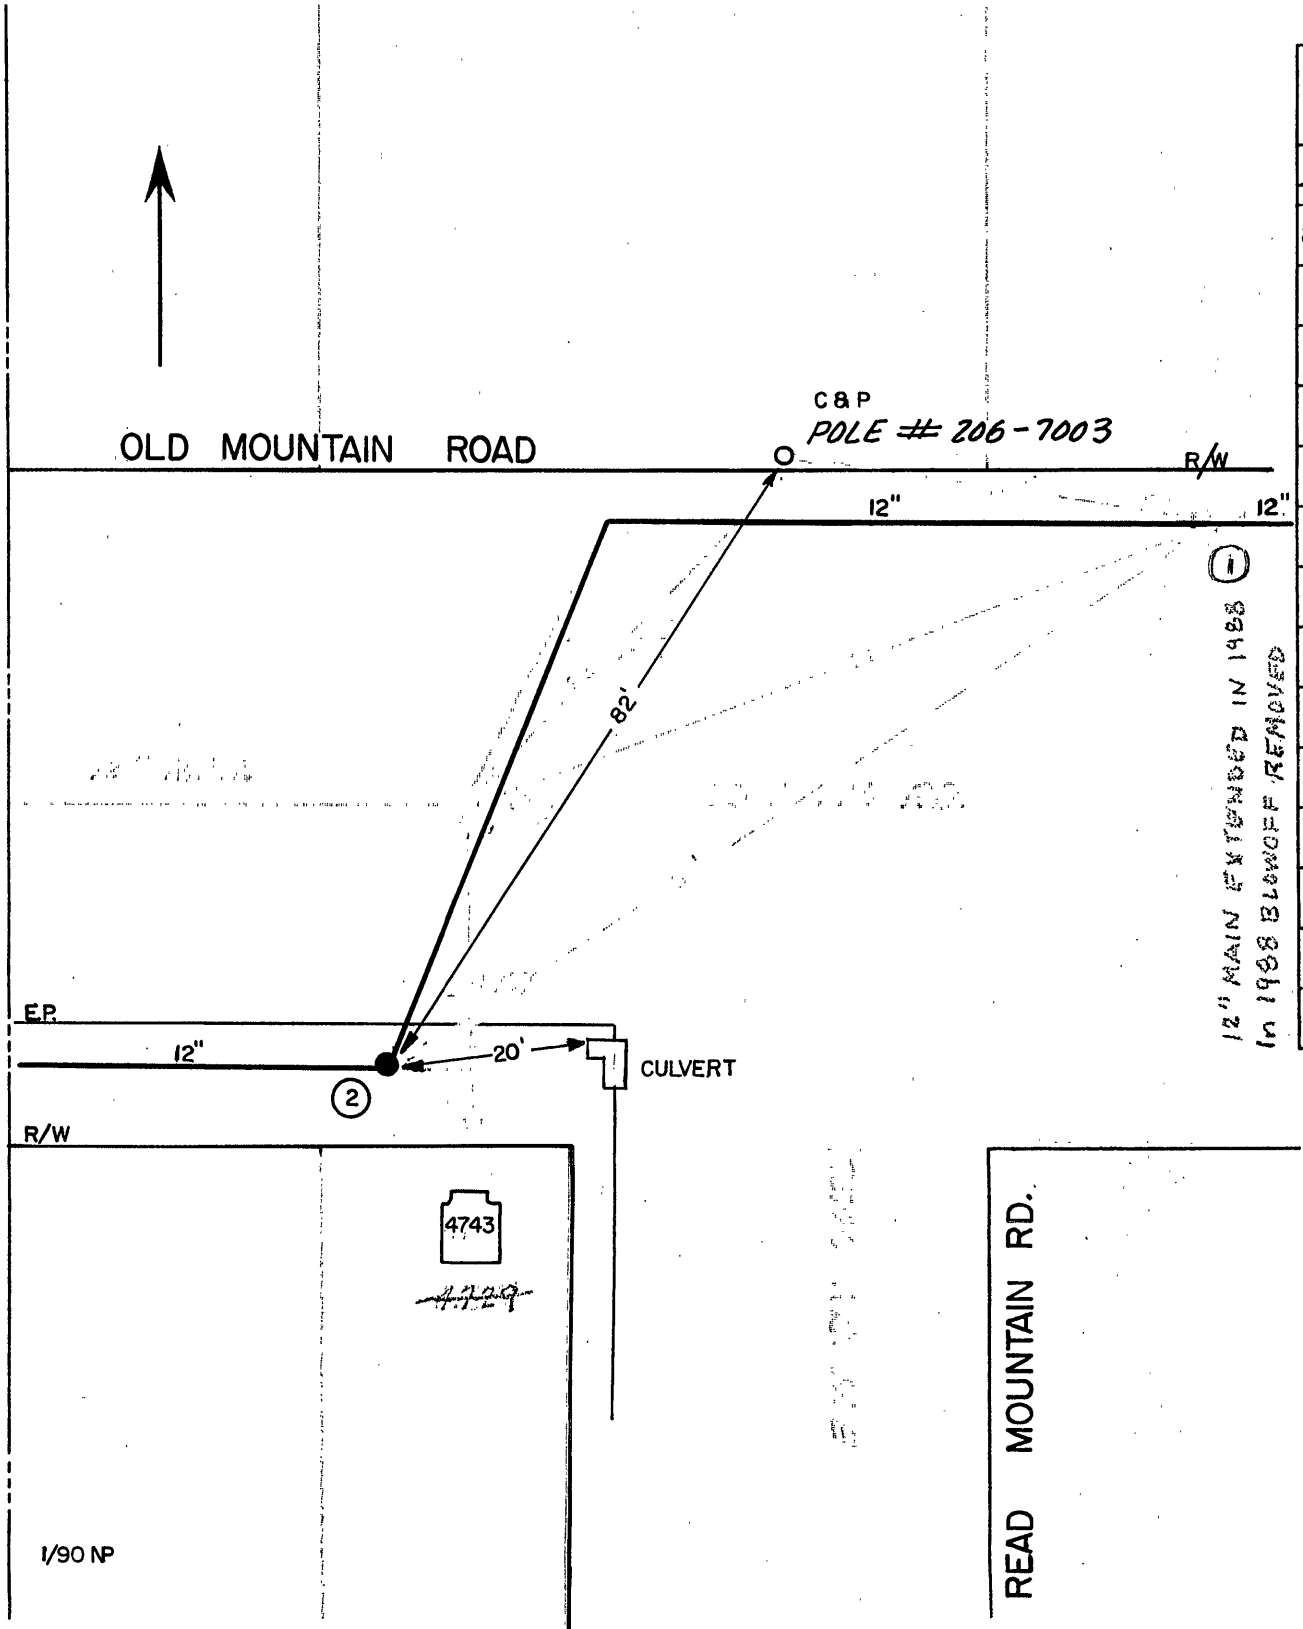

DATE	NO.	SIZE	MAKE	OPEN	TURNS
~~8-87~~	~~1~~	~~2"~~	~~MISC~~	~~L~~	~~BLOWOFF~~
8-87	2	12"	MUELLER	R	

CITY OF ROANOKE—WATER DEP'T

VALVE DIAGRAM

OLD MTN. RD. &

READ MTN. RD. N.E.

SEC. MAP 738,741

DATE PAGE NO.