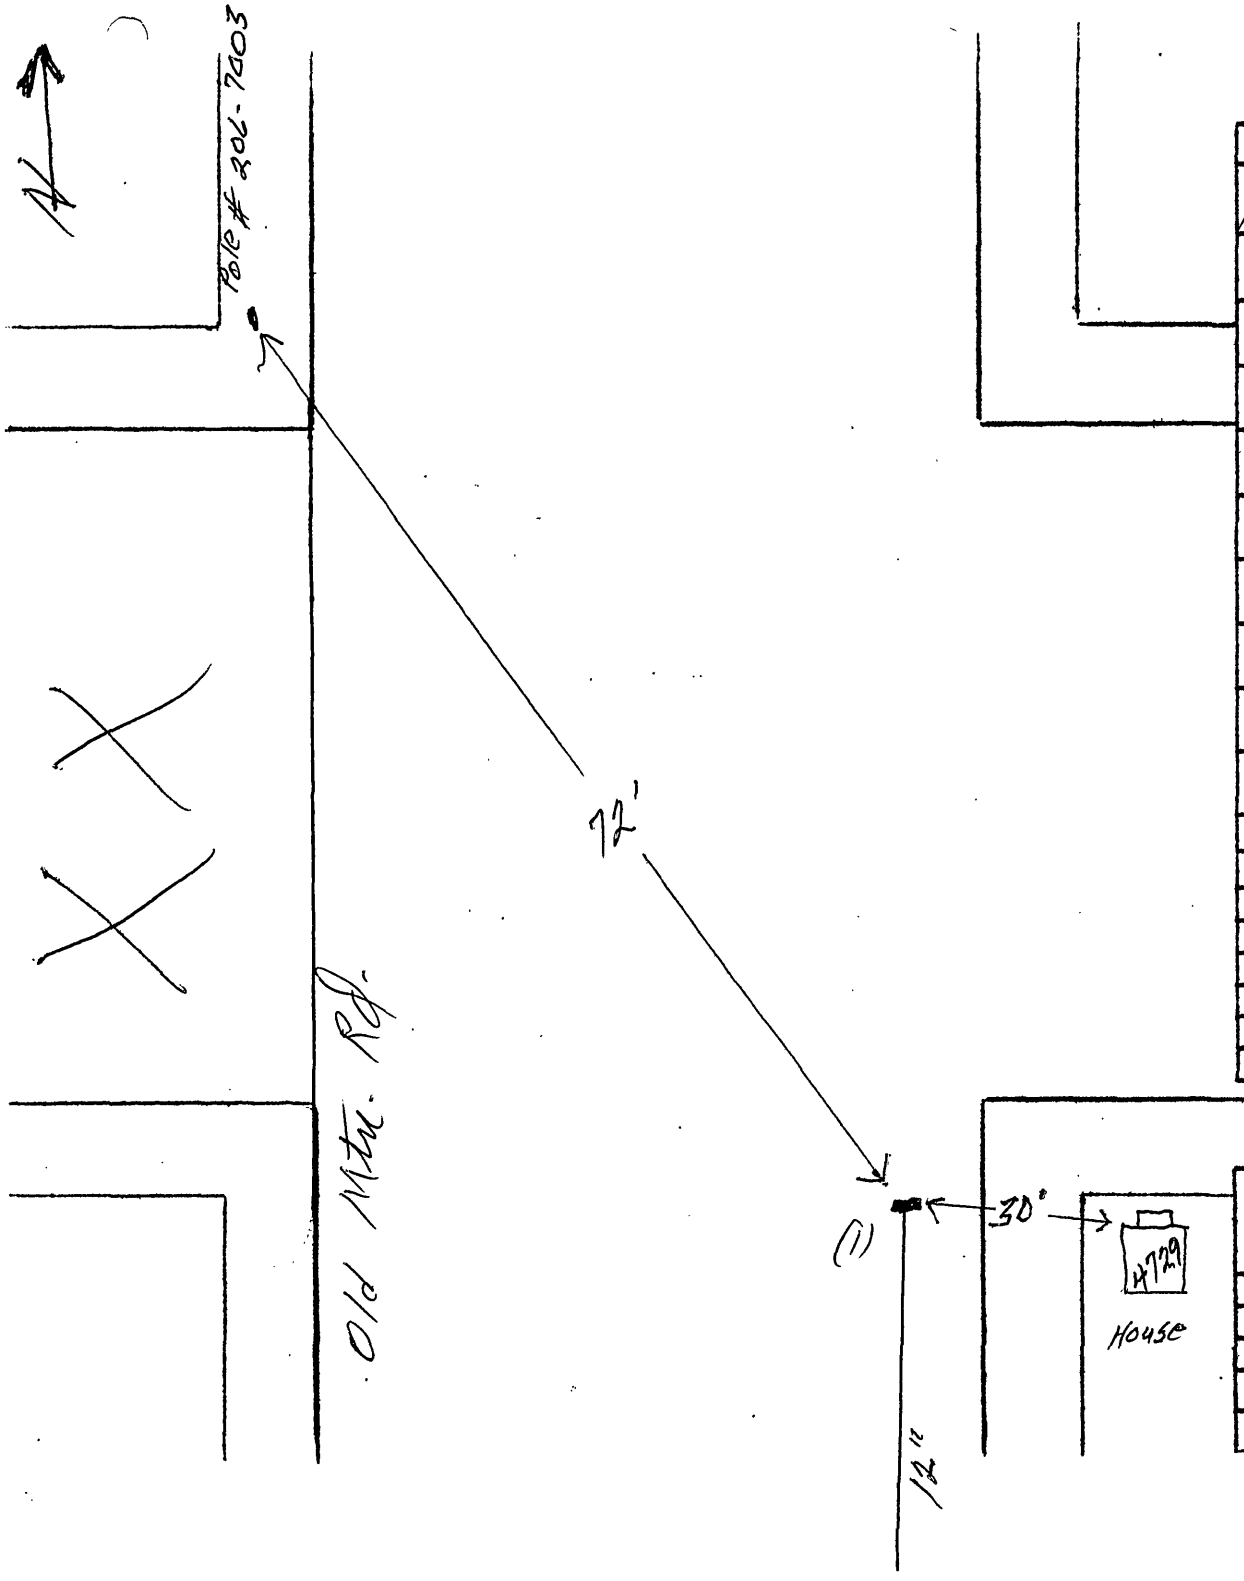

DATE	NO.	SIZE	MAKE	OPEN	TURNS
11-77	1	2"	Misc	L	Blow Off

P. L. Measurements		
No.	Distance	Direction

CITY OF ROANOKE - WATER DEPT.

VALVE DIAGRAM

Old MTN. Rd. & Read Mtn. Rd N.E.

Sec. Map

Date Page No.

JWM.

Done