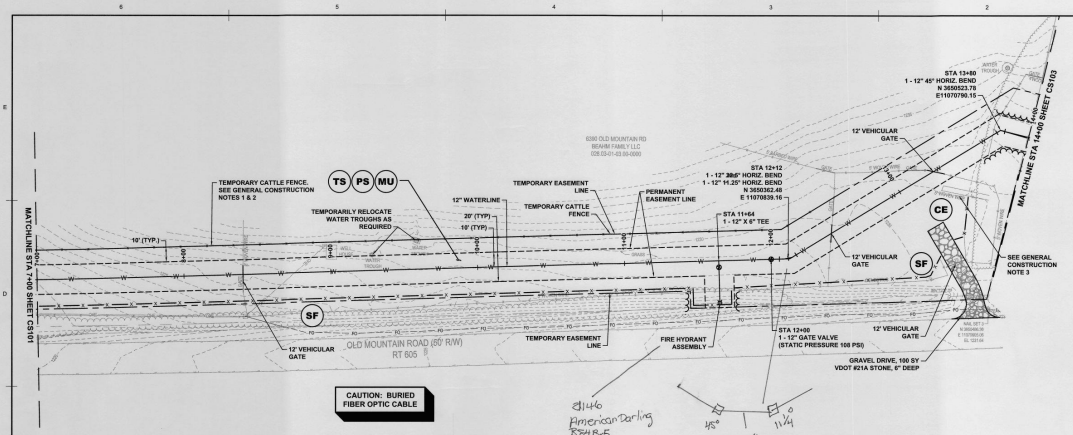

PLAN VIEW

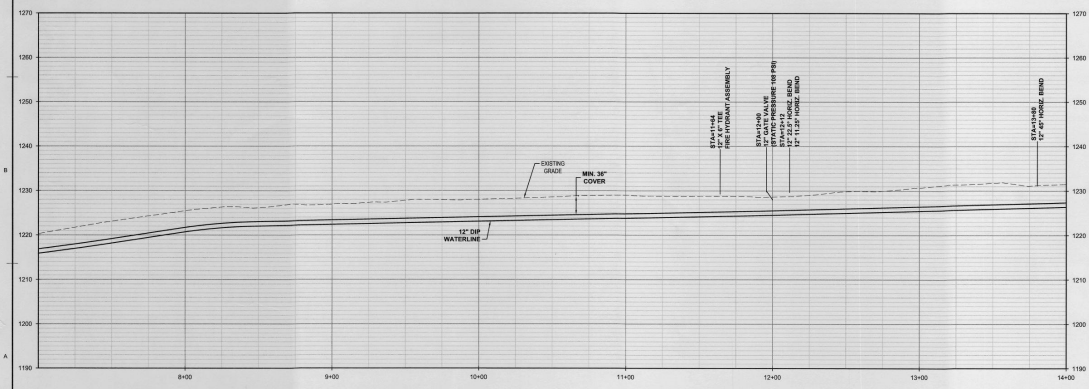

PROFILE VIEW

GENERAL PLAN NOTES

1. SEE SHEET C-001 FOR GENERAL NOTES
2. SEE SHEETS C-002 FOR EROSION AND SEDIMENT CONTROL NARRATIVE
3. SEE SHEET C-501 FOR EROSION AND SEDIMENT CONTROL DETAILS
4. SEE SHEET C-502 & C-503 FOR CIVIL DETAILS
5. SEE SHEET C-503 FOR RESTRAINED LENGTHS FOR PIPE FITTINGS

GENERAL CONSTRUCTION NOTES

1. CONTRACTOR SHALL COORDINATE LOCATION OF TEMPORARY CATTLE FENCES, ACCESS GATES AND RELOCATED WATER TROUGHS WITH LANDOWNERS BEFORE INSTALLATION.
2. MINIMUM REQUIREMENTS FOR TEMPORARY CATTLE FENCING ARE 6' STEEL T POSTS WITH WOVEN WIRE PANELS.
3. CONTRACTOR SHALL PROTECT EXISTING LOADING SHOOT TO PREVENT DAMAGE DURING CONSTRUCTION IN THAT AREA.
4. CONTRACTOR SHALL REPLACE ANY DAMAGED FENCES OR GATES IN KIND.
5. CONTRACTOR SHALL RECONSTRUCT ALL DRIVEWAY ENTRANCES IMMEDIATELY UPON COMPLETION OF CONSTRUCTION IN DRIVEWAY AREA.

EROSION AND SEDIMENT CONTROL LEGEND

3.02	TEMPORARY STONE CONSTRUCTION ENTRANCE	CE	
3.05	SILT FENCE	SF	X—X—X
3.31	TEMPORARY SEEDING	TS	
3.32	PERMANENT SEEDING	PS	
3.35	MULCHING	MU	

NOTE:
CONTRACTOR MAY USE FILTER SOCK IN PLACE OF SILT FENCE PENDING APPROVAL OF E&S INSPECTOR.

IF THIS DRAWING IS REDUCED, GRAPHIC SCALE MUST BE USED.
VERT: 1" = 10'
0 10' 20'
HORIZ: 1" = 30'
0 30' 60'

KEY PLAN

Wiley|Wilson®
Constant Progress
127 Nationwide Drive | Lynchburg, VA 24502
434.847.0811 | wileywilson.com | 100% Employee-Owned

WESTERN VIRGINIA WATER AUTHORITY
OLD MOUNTAIN ROAD WATER LINE EXTENSION
ROANOKE, VIRGINIA

REV.	DATE	REVISION DESCRIPTION

COMM NO: 222173
DATE: 08/10/2023
DRAWN: CAT DESIGN: WRM
CHECK: GKT
SHEET TITLE
PLAN AND PROFILE
STA. 7+00 TO 14+00

SHT. NO. CS102 REV. NO. 0

X:\2022\222173 WVWA Old Mtn Rd Water\700 Drawings\702 Civil\Sheets\222173A19_CS102.dwg