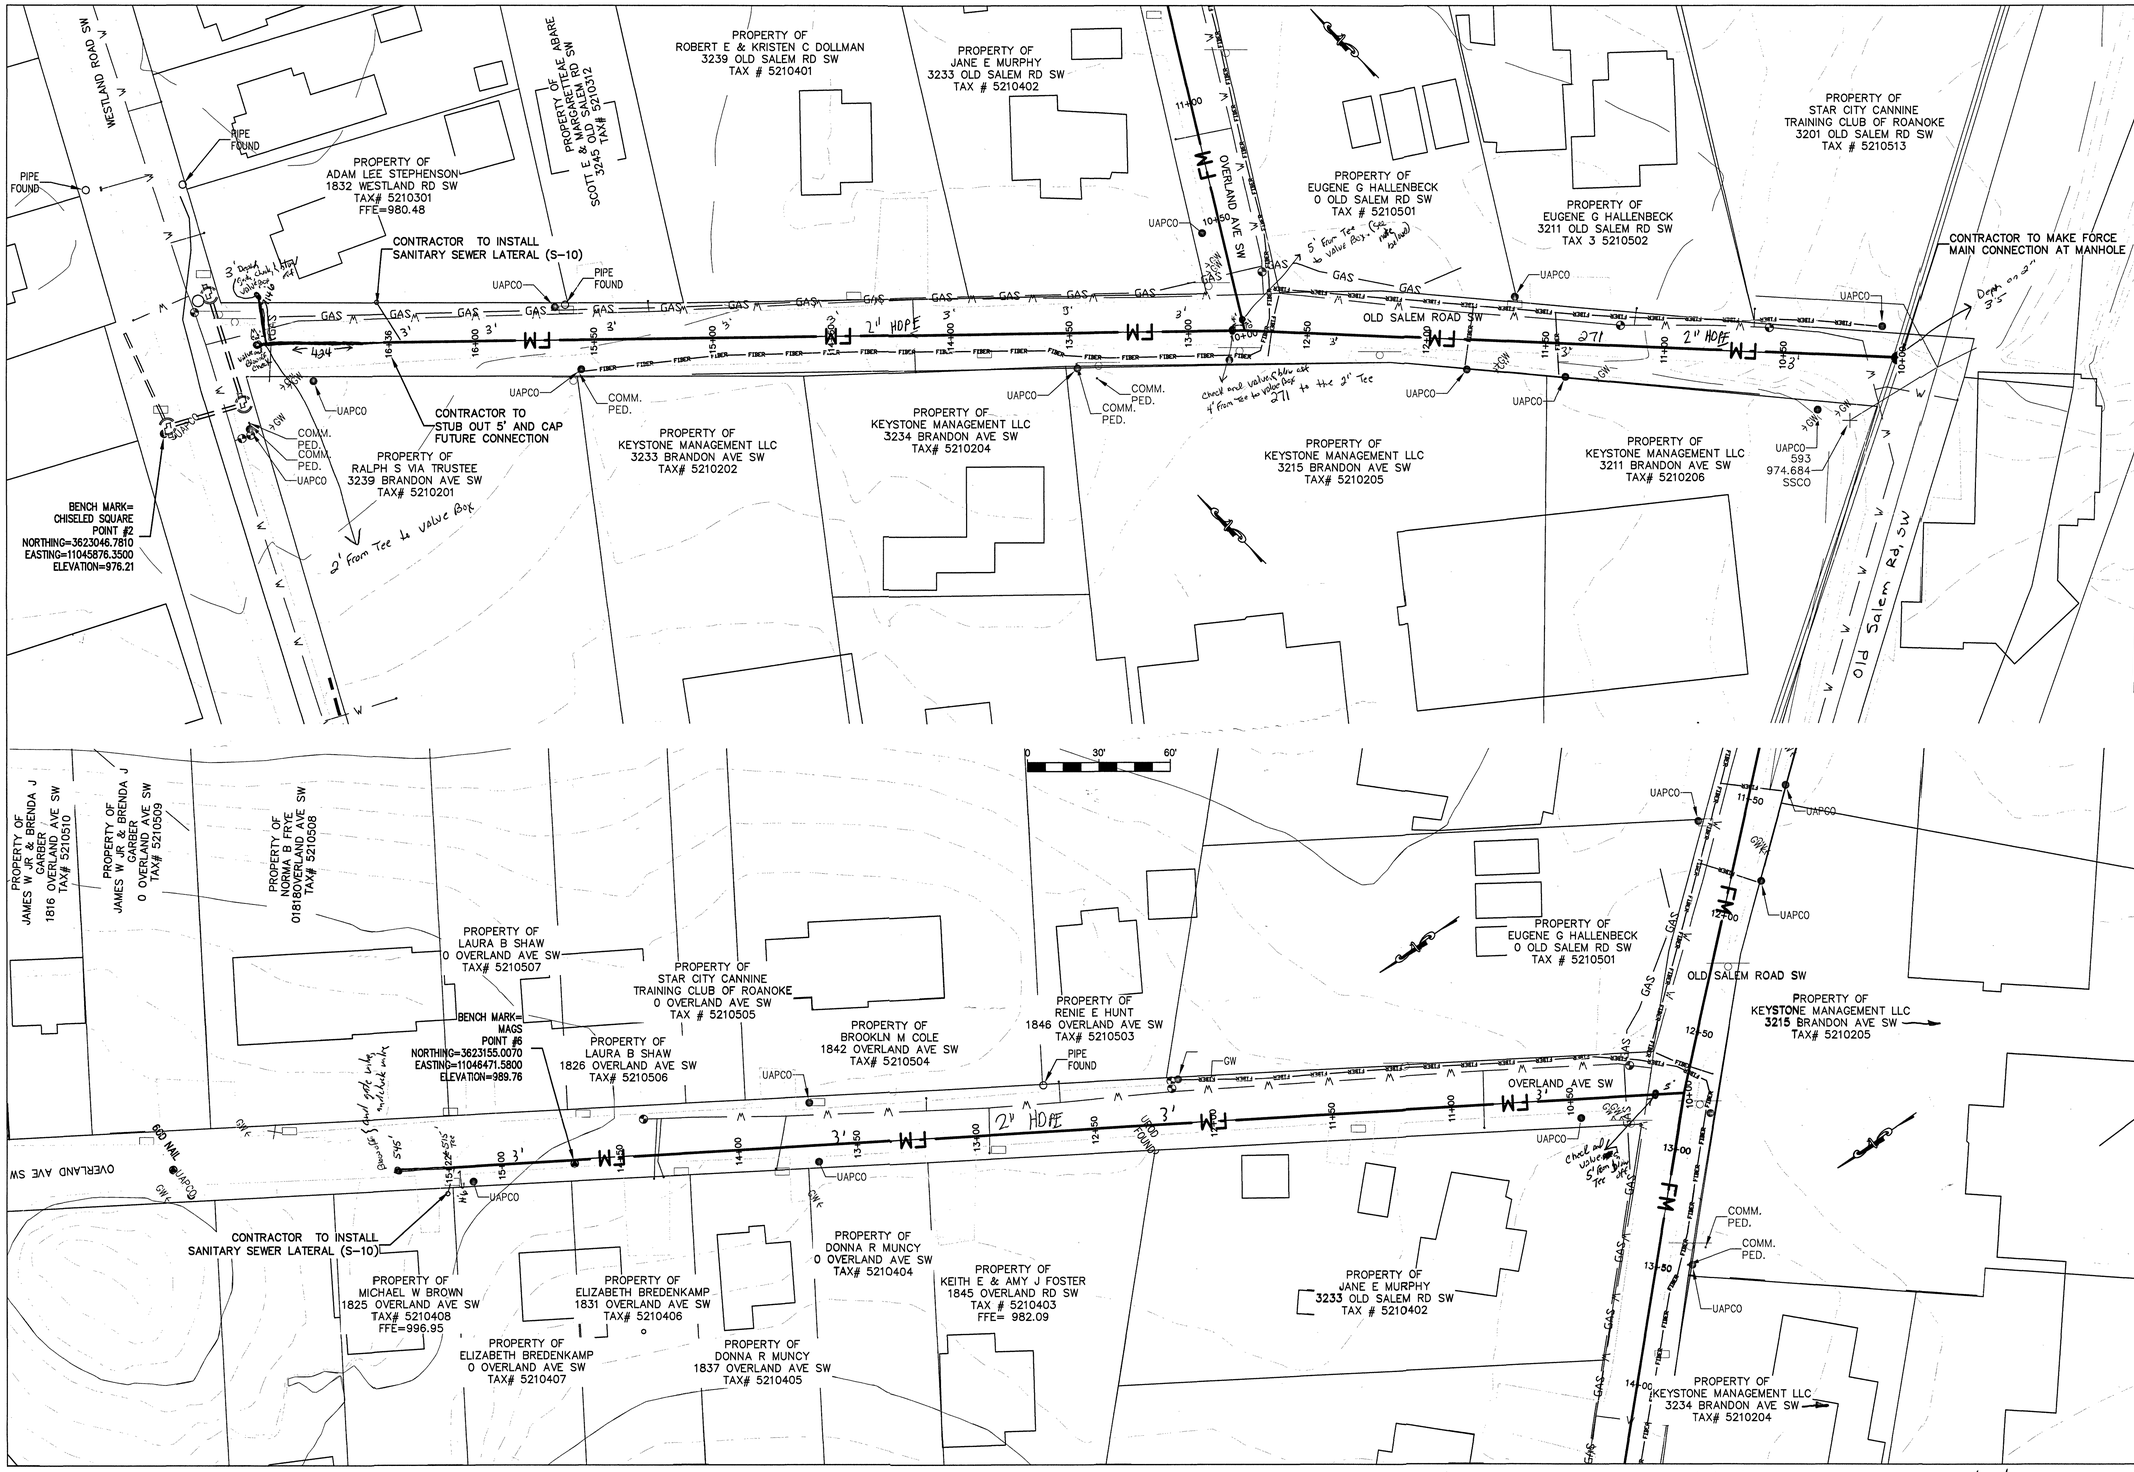

WESTERN VIRGINIA WATER AUTHORITY
ENGINEERING SERVICES
601 S JEFFERSON ST, SUITE 300
ROANOKE, VA 24011
540-853-5700

OLD SALEM SEWER
FORCE MAIN AS BUILT

Rev	Description	Date	By
ASBUILT			

Designed: AAS
Drawn: AAS
Checked:
Approved:
Date: 12/18/17
Project:

1
Sheet 1 of 1

Installed by FOP - Completed 1/5/18
Note: All 5 valve boxes include a gate valve, check valve, & blow off valve