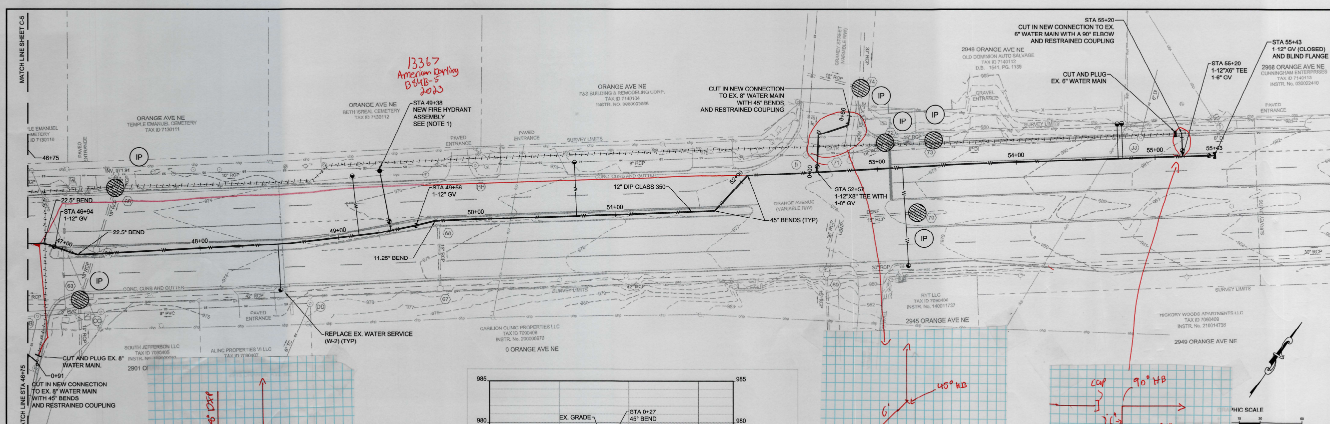

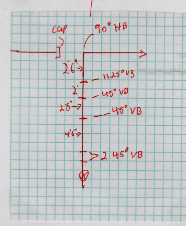

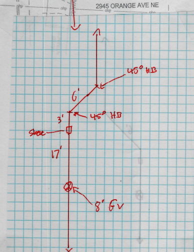

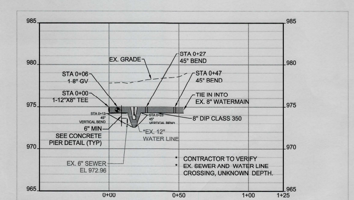

PROFILE GRANBY STREET - SCALE: H: 1"=30', V: 1"=5'

NOTES:

1. INSTALL NEW FIRE HYDRANT (… E NEW WATER MAIN IS ACTIVE, ABANDON THE EXISTI… E HYDRANT, ABANDON FIRE HYDRANT LEAD BY REMO… D, BACKFILL HOLE, AND PATCH ROAD OR TOPSOIL, SE… ORITY OPERATIONS CENTER.
2. ALL WATERLINE TRENCHES W… OKE DETAIL UTR-1 ON SHEET D-2.
3. CONTRACTOR SHALL ADJUST … N THE BRANCH CONNECTIONS WHERE THEY C… ONTRACTOR SHALL ENSURE THE ADJUSTED ELEVA… ATION WITH CROSSING UTILITIES.
4. ALL EXISTING WATER SERVICE… NEW 12" WATER LINE FOR ALL EXISTING CUSTOMER…
5. CONCRETE PIERS ARE TO BE U… M OTHER UTILITIES CANNOT BE OBTAINED. DETAIL…
6. A 2" CASING PIPE SHALL BE USED FOR WATER SERVICES PASSING UNDER TRAFFIC LANES.
7. EXISTING WATER VALVES ON THE ABANDONED WATER LINES SHOULD BE CLOSED, REMOVE VALVE BOX LID AND UPPER PORTION OF VALVE BOX, THEN PAVE PER UTR-1 DETAIL ON SHEET D-2.

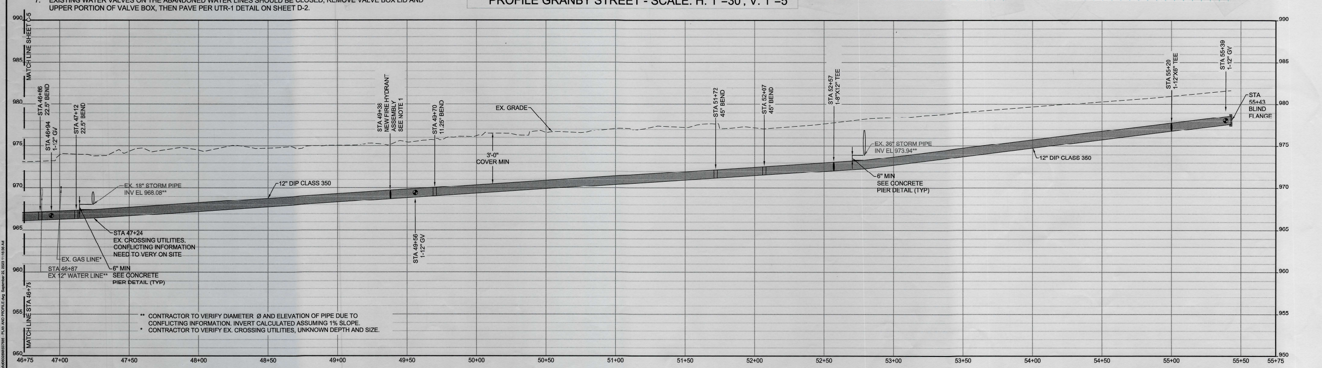

PROPOSED WL - SCALE: H:1"30, V: 1"=5' STA 46+75 TO 55+75

5543
800
6,343
1500
5,843

COMMONWEALTH OF VIRGINIA
WILLIAM OTIS RANDALL
Lic. No. 26054
9/22/23
PROFESSIONAL ENGINEER

Draper Aden Associates
Engineering • Surveying • Environmental Services

2206 South Main Street, Suite A
Blacksburg, VA 24060
540-552-0444 Fax: 540-552-0291
www.daa.com

• Richmond, VA • Charlottesville, VA • Hampton Roads, VA
• Raleigh, NC • Fayetteville, NC • Northern Virginia • Virginia Beach, VA

WATERLINE PLAN AND PROFILE (5 OF 6)

ORANGE AVE & GUS NICKS WATER MAIN REPLACEMENT

ROANOKE, VIRGINIA

REVISIONS
9/22/23
RFI 1 Realignment

DESIGNED BY:	WOR
DRAWN BY:	YCA / YM / ASZ
CHECKED BY:	SRG
SCALE:	1"=30'
DATE:	9/22/2023
PROJECT NUMBER:	507666

C-6
11 OF 20