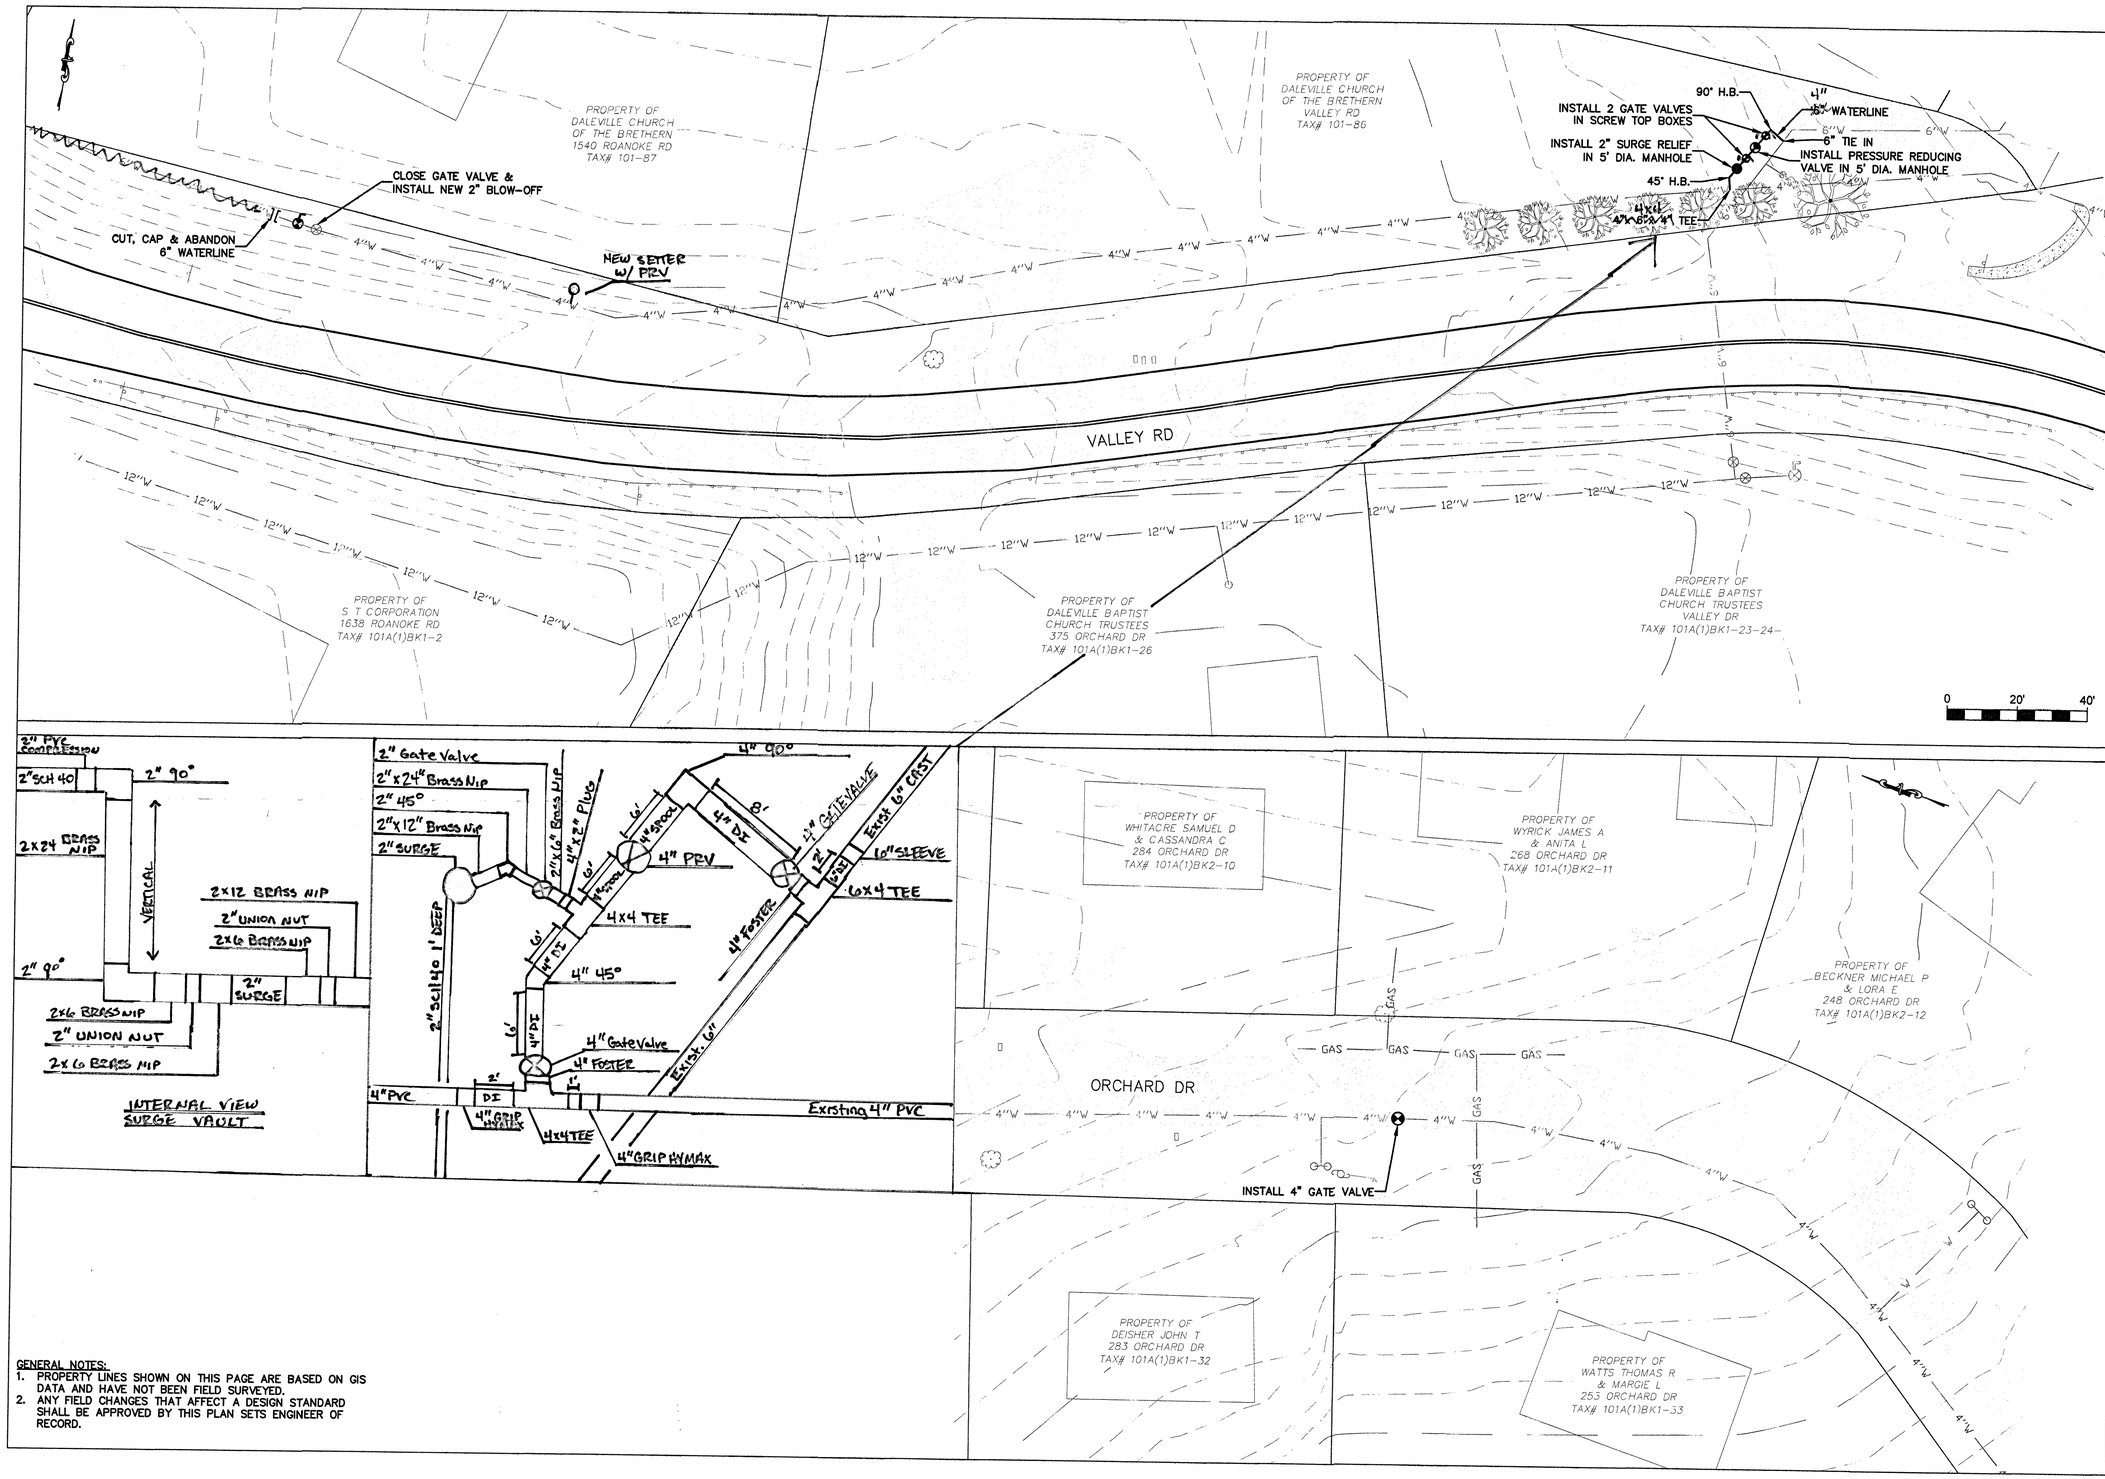

GENERAL NOTES:
1. PROPERTY LINES SHOWN ON THIS PAGE ARE BASED ON GIS DATA AND HAVE NOT BEEN FIELD SURVEYED.
2. ANY FIELD CHANGES THAT AFFECT A DESIGN STANDARD SHALL BE APPROVED BY THIS PLAN SETS ENGINEER OF RECORD.

WESTERN VIRGINIA WATER AUTHORITY
ENGINEERING SERVICES
601 S JEFFERSON ST. SUITE 300
ROANOKE, VA 24011
540-853-5700

ROANOKE RD 6" WATERLINE ABANDONMENT

BASEMAP

Rev	Description	Date	By

Designed:
Drawn: AJC
Checked: NSS
Approved:
Date: DEC 2023
Project:

2
Sheet 2 of 2