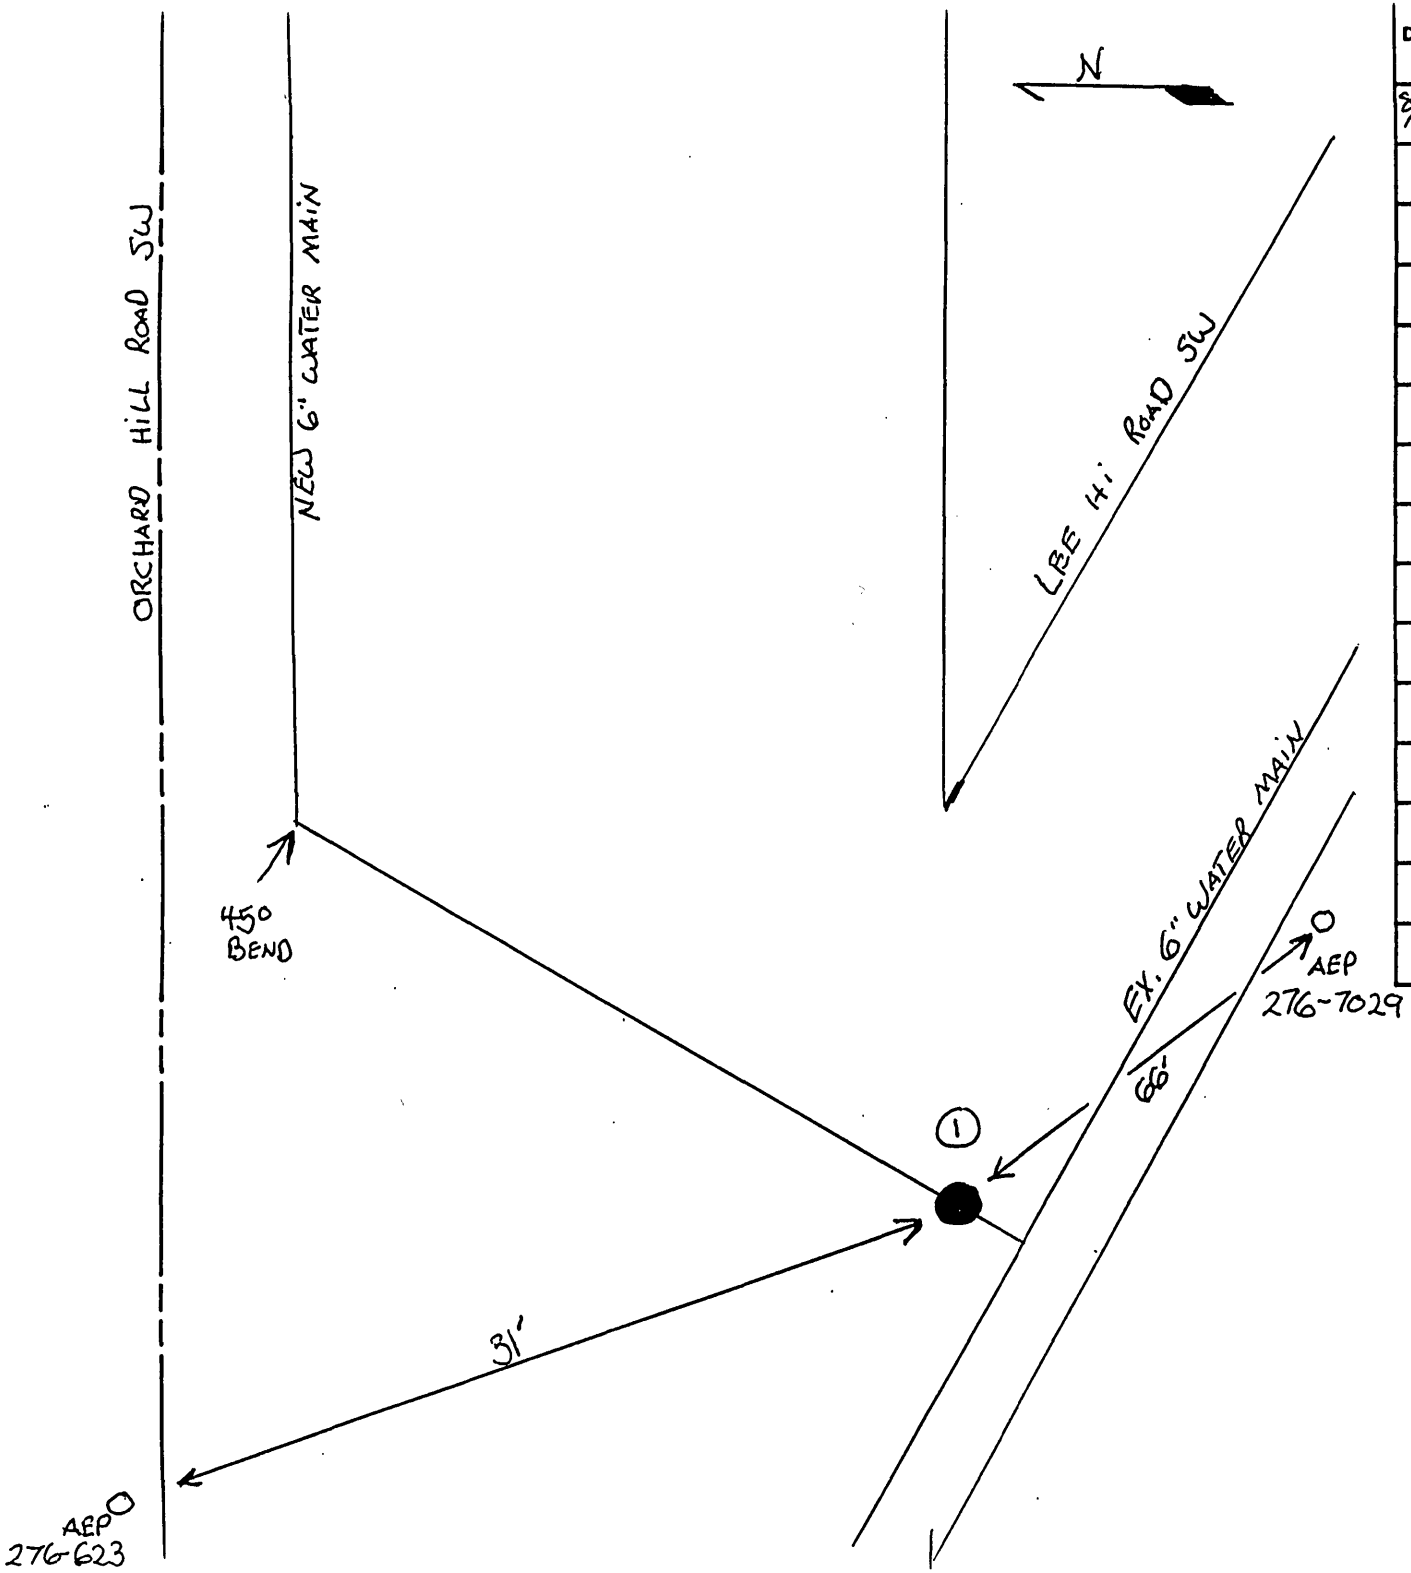

DATE	NO.	SIZE	MAKE	OPEN	TURNS
8/6/99	1	6"	MUELLER	R	21

CITY OF ROANOKE - WATER DEP'T.

VALVE DIAGRAM

LEE HI ROAD SW AND ORCHARD HILLS SW

SEC. MAP 505

DATE: 8-6-99 PAGE NO.