PLAN
SURVEYED
PLOTTED
ALIGNMENT CHECKED
RT. OF WAY CHECKED.
NOTE BOOK
NO.
DATE
BY

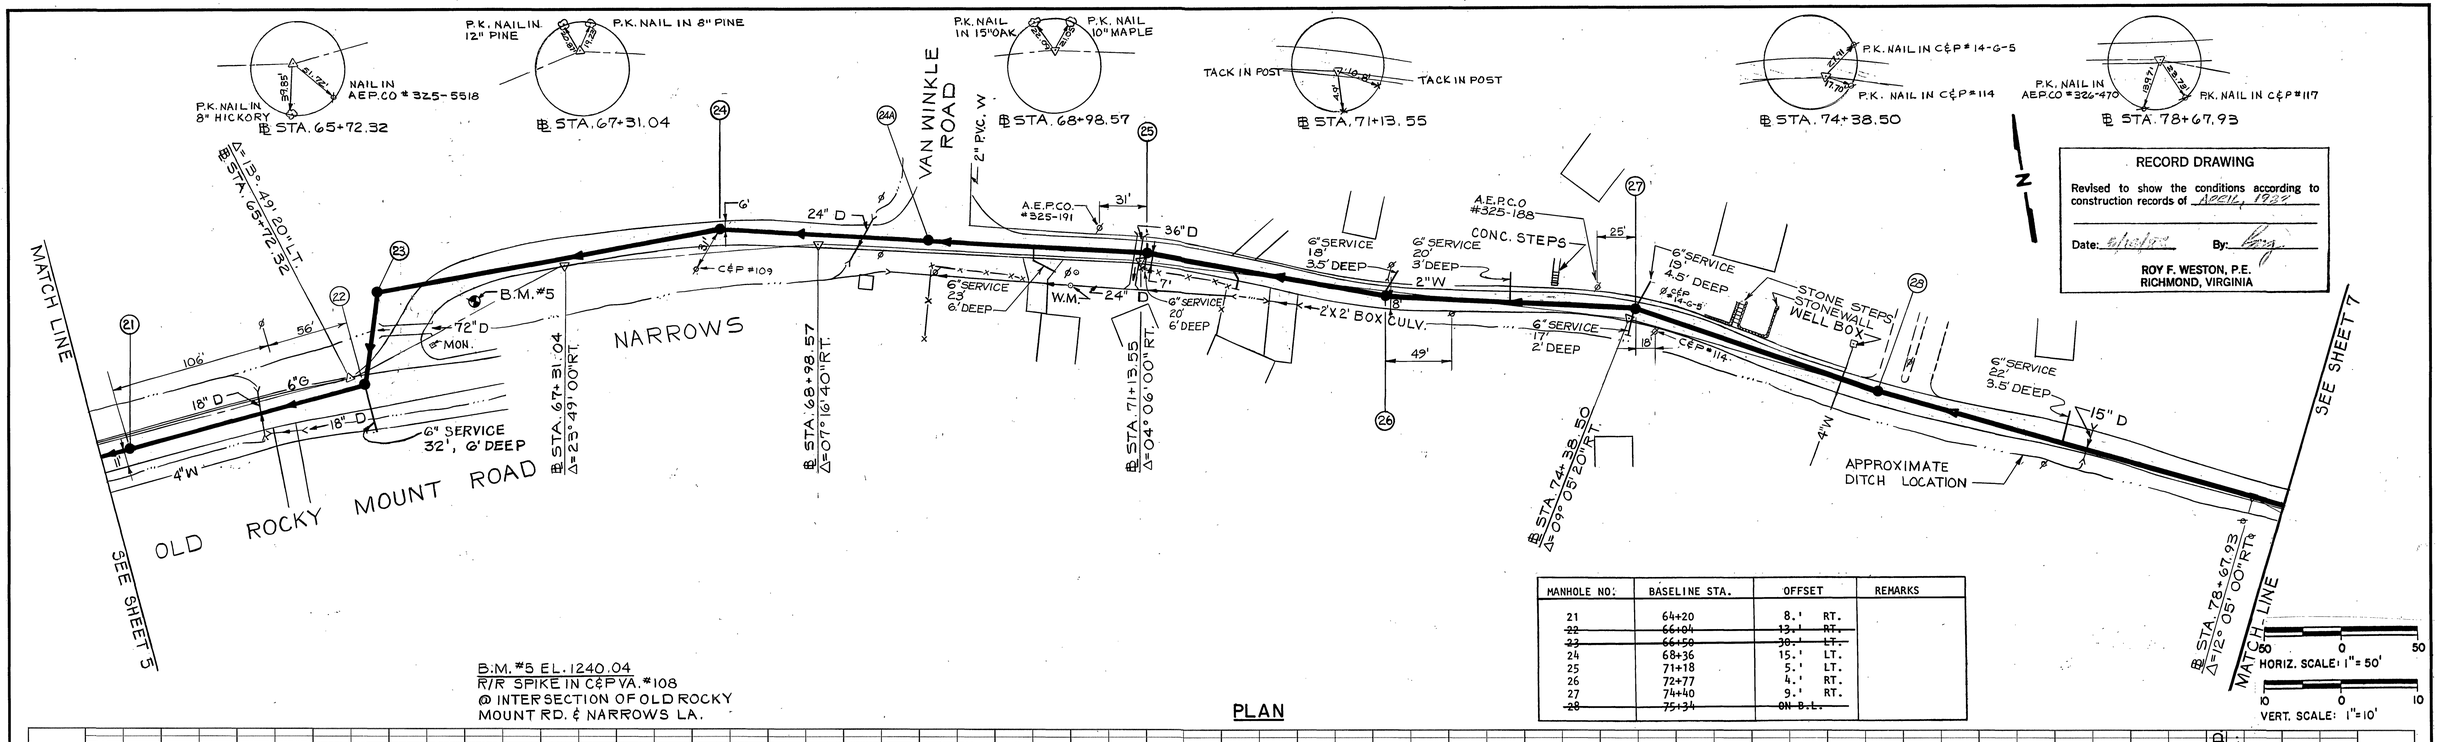

MANHOLE NO:	BASELINE STA.	OFFSET	REMARKS
21	64+20	8.' RT.	
~~22~~	~~66+04~~	~~13.' RT.~~	
~~23~~	~~66+58~~	~~38.' LT.~~	
24	68+36	15.' LT.	
25	71+18	5.' LT.	
26	72+77	4.' RT.	
27	74+40	9.' RT.	
~~28~~	~~75+34~~	~~ON B.L.~~	

PLAN

PROFILE
SURVEYED
PLOTTED
GRADES CHECKED.
B. M.'s NOTED.
STRUCTURE NOTATIONS CHKD
NOTE BOOK
NO.
DATE
BY

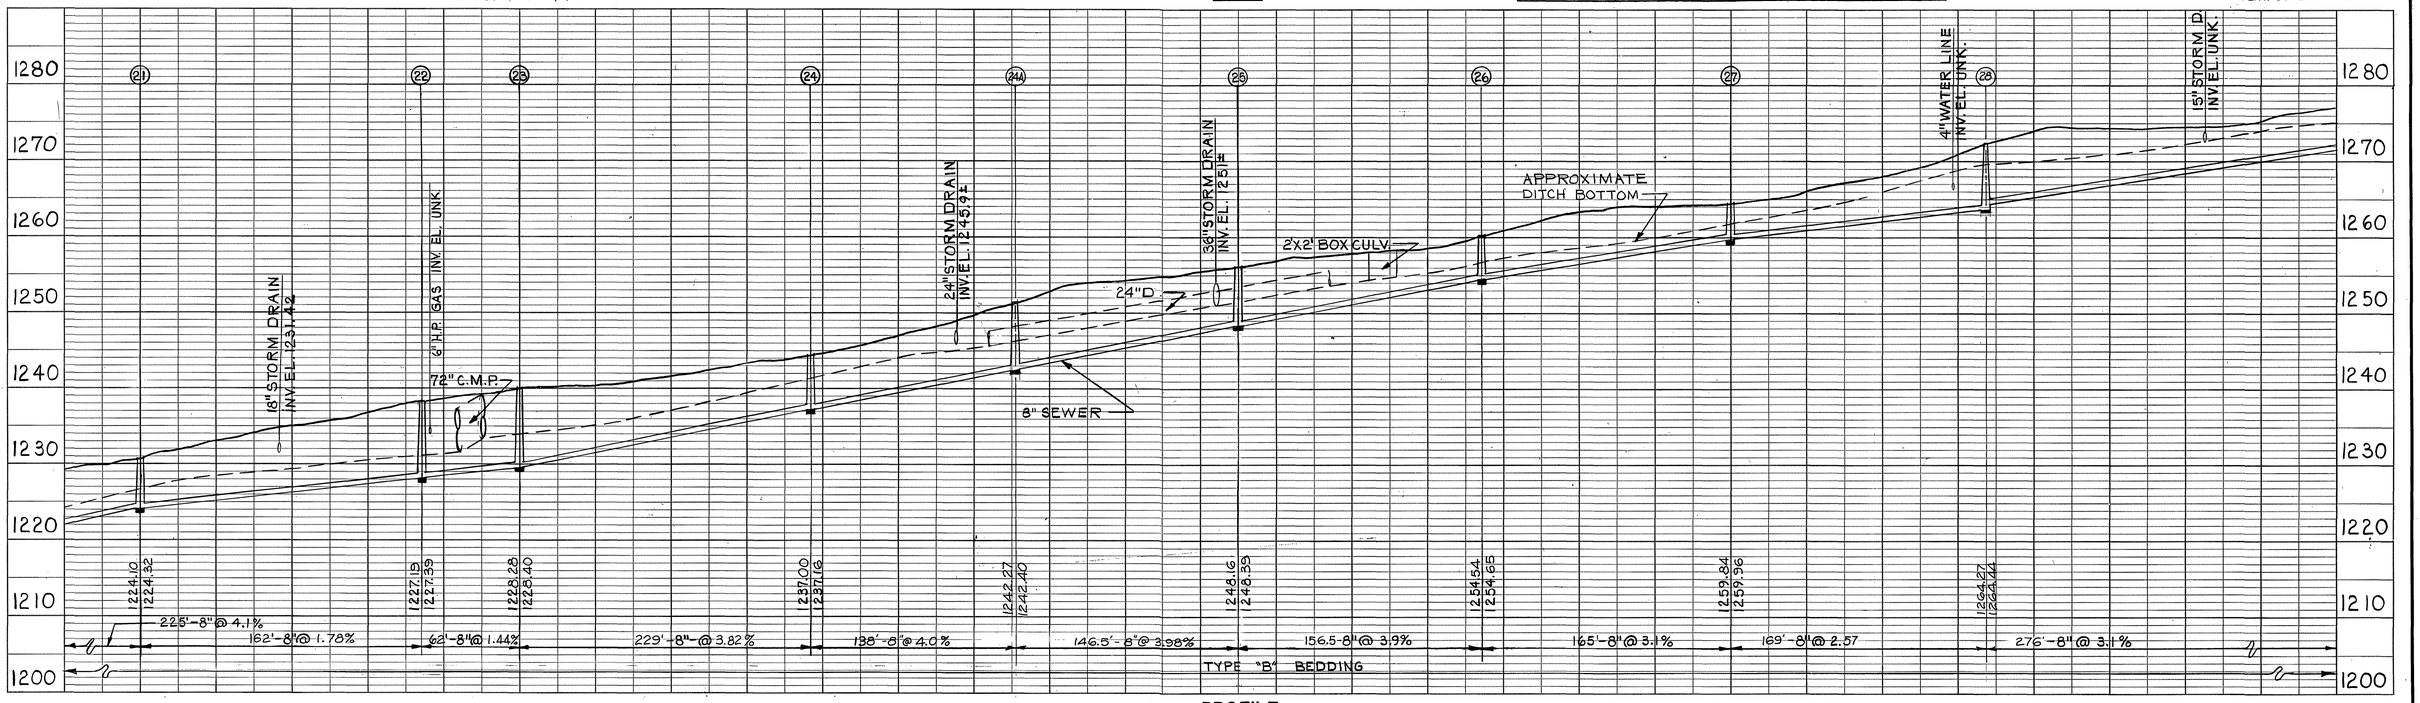

PROFILE

RECORD DRAWING
Revised to show the conditions according to construction records of APRIL, 1982
Date: 6/16/82 By: [illegible]
ROY F. WESTON, P.E.
RICHMOND, VIRGINIA

NO.	DATE	APPR.	REVISION

ORE BRANCH SANITARY SEWER
CITY OF ROANOKE, VIRGINIA

WESTON DESIGNERS CONSULTANTS
RICHMOND VIRGINIA

	DATE
CHECKED	
DES. ENG.	
PROJ. ENG. [illegible]	11/26/80
PROJ. MGR. WRS	11/26/80
APPROVED	
APPROVED	

CLIENT APPROVALS	DATE
ISSUED FOR CONSTRUCTION	DATE 2/9/81

COMMONWEALTH OF VIRGINIA
WENDLE P. SNAPP
CERTIFICATE No. 2525
CERTIFIED PROFESSIONAL ENGINEER

UPPER SEGMENT PLAN AND PROFILE

DRAWN	DATE	PLAN NO.	REV. NO.
C.L. GIBSON	SEPT. 1980	5772	
SCALE	W.O. NO.	SHT. 6 OF 10	
AS NOTED	0384-05-01		

BRUNING 44-132 43361