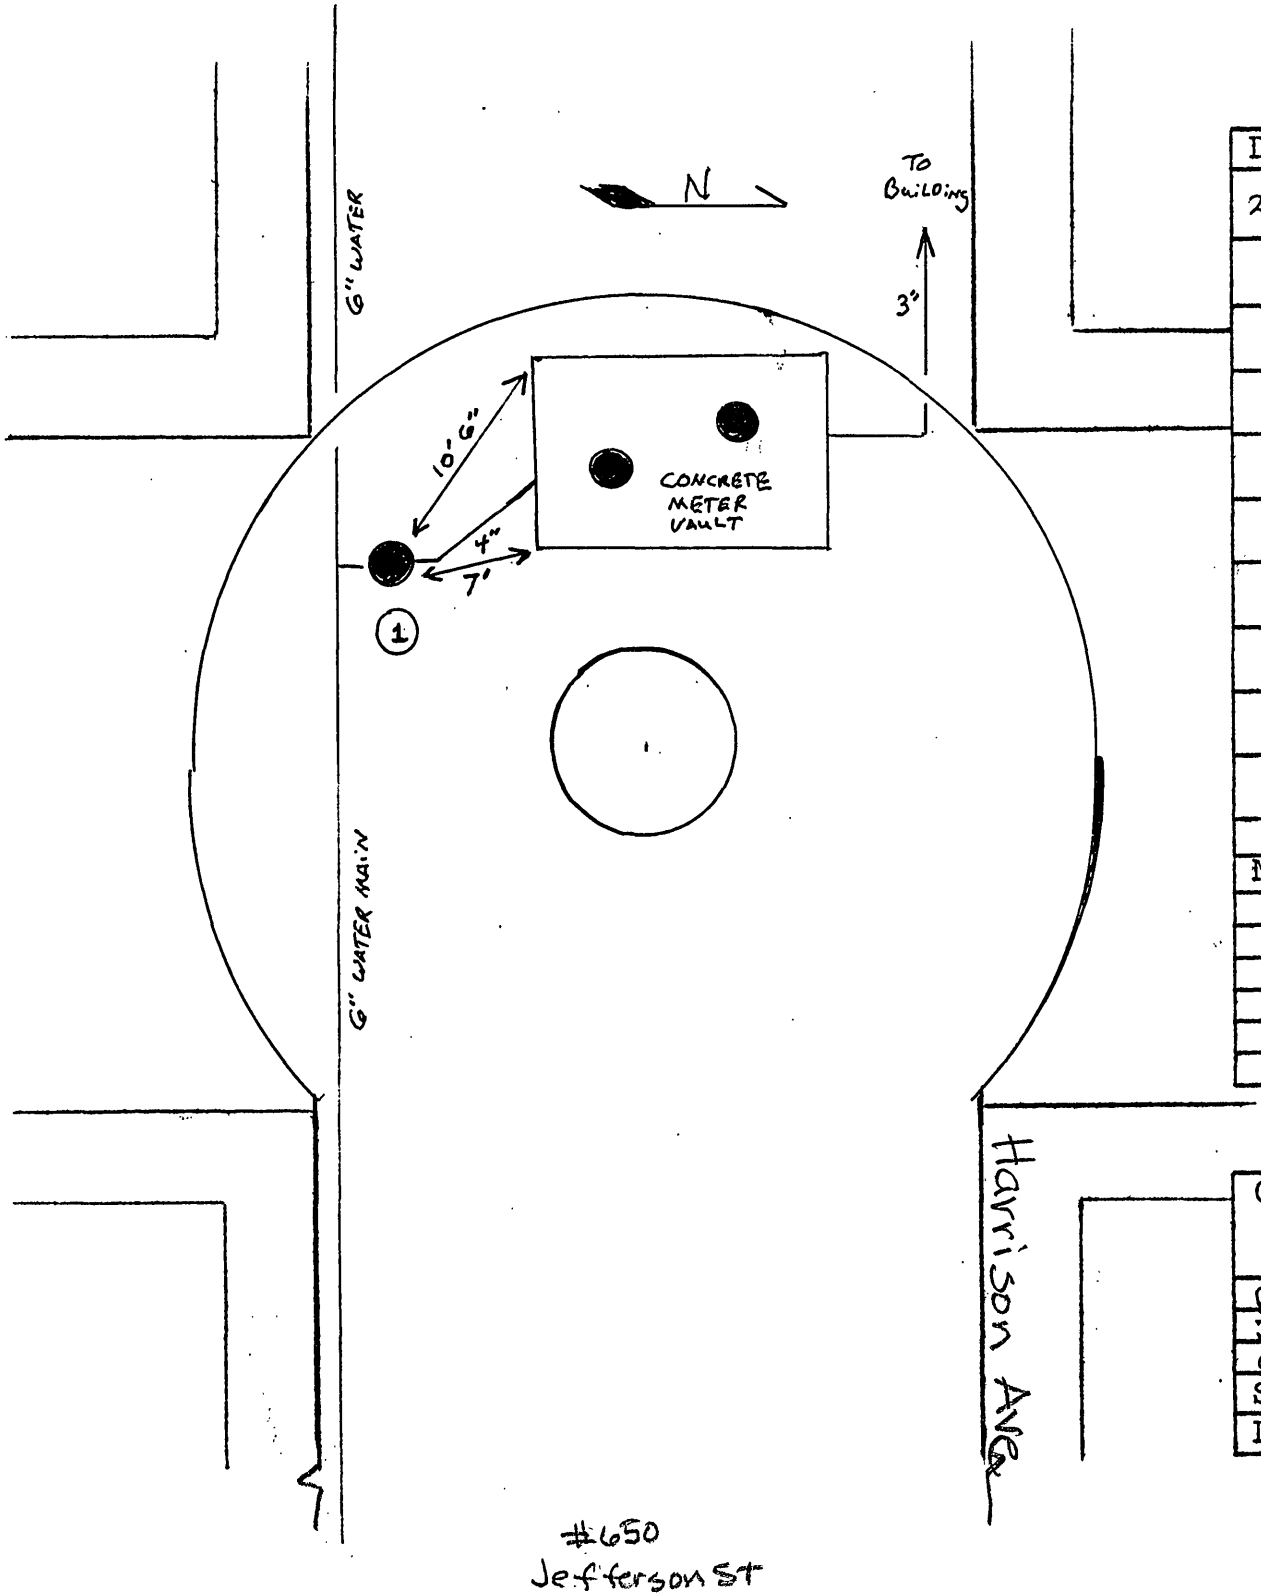

#650
Jefferson St

DATE	NO.	SIZE	MAKE	OPEN	TURNS
2001	1	6"	MUELLER	R	21

P. L. Measurements		
No.	Distance	Direction

CITY OF ROANOKE - WATER DEPT.

VALVE DIAGRAM

DRIVEWAY CIRCLE AT 650 NORTH
JEFFERSON ST NW
OUR LADY OF THE VALLEY
Sec. Map 201
Date 4-18-01 Page No.