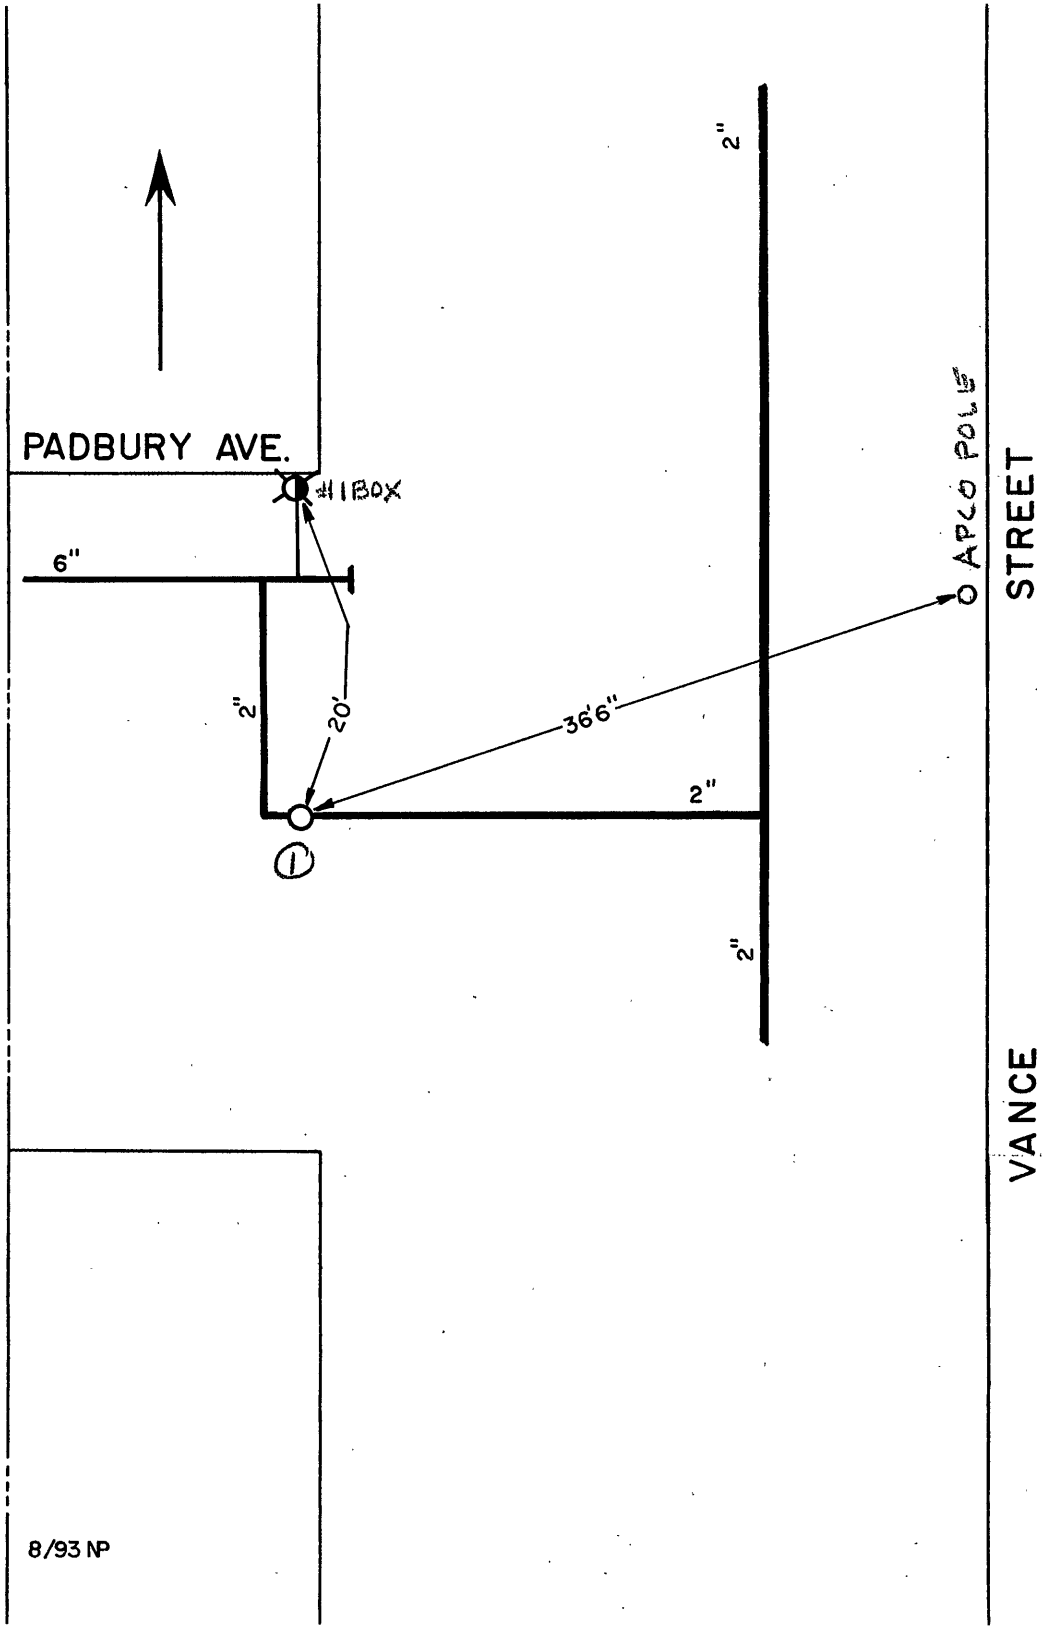

DATE	NO.	SIZE	MAKE	OPEN	TURNS
6-92	1	2"	MISC.	L	

CITY OF ROANOKE—WATER DEP'T

VALVE DIAGRAM

PADBURY AVENUE

VANCE STREET

SEC. MAP 444 S.E.

DATE PAGE NO.