DATE	NO.	SIZE	MAKE	OPEN	TURNS
7-71	1	8"	MUELLER	R	

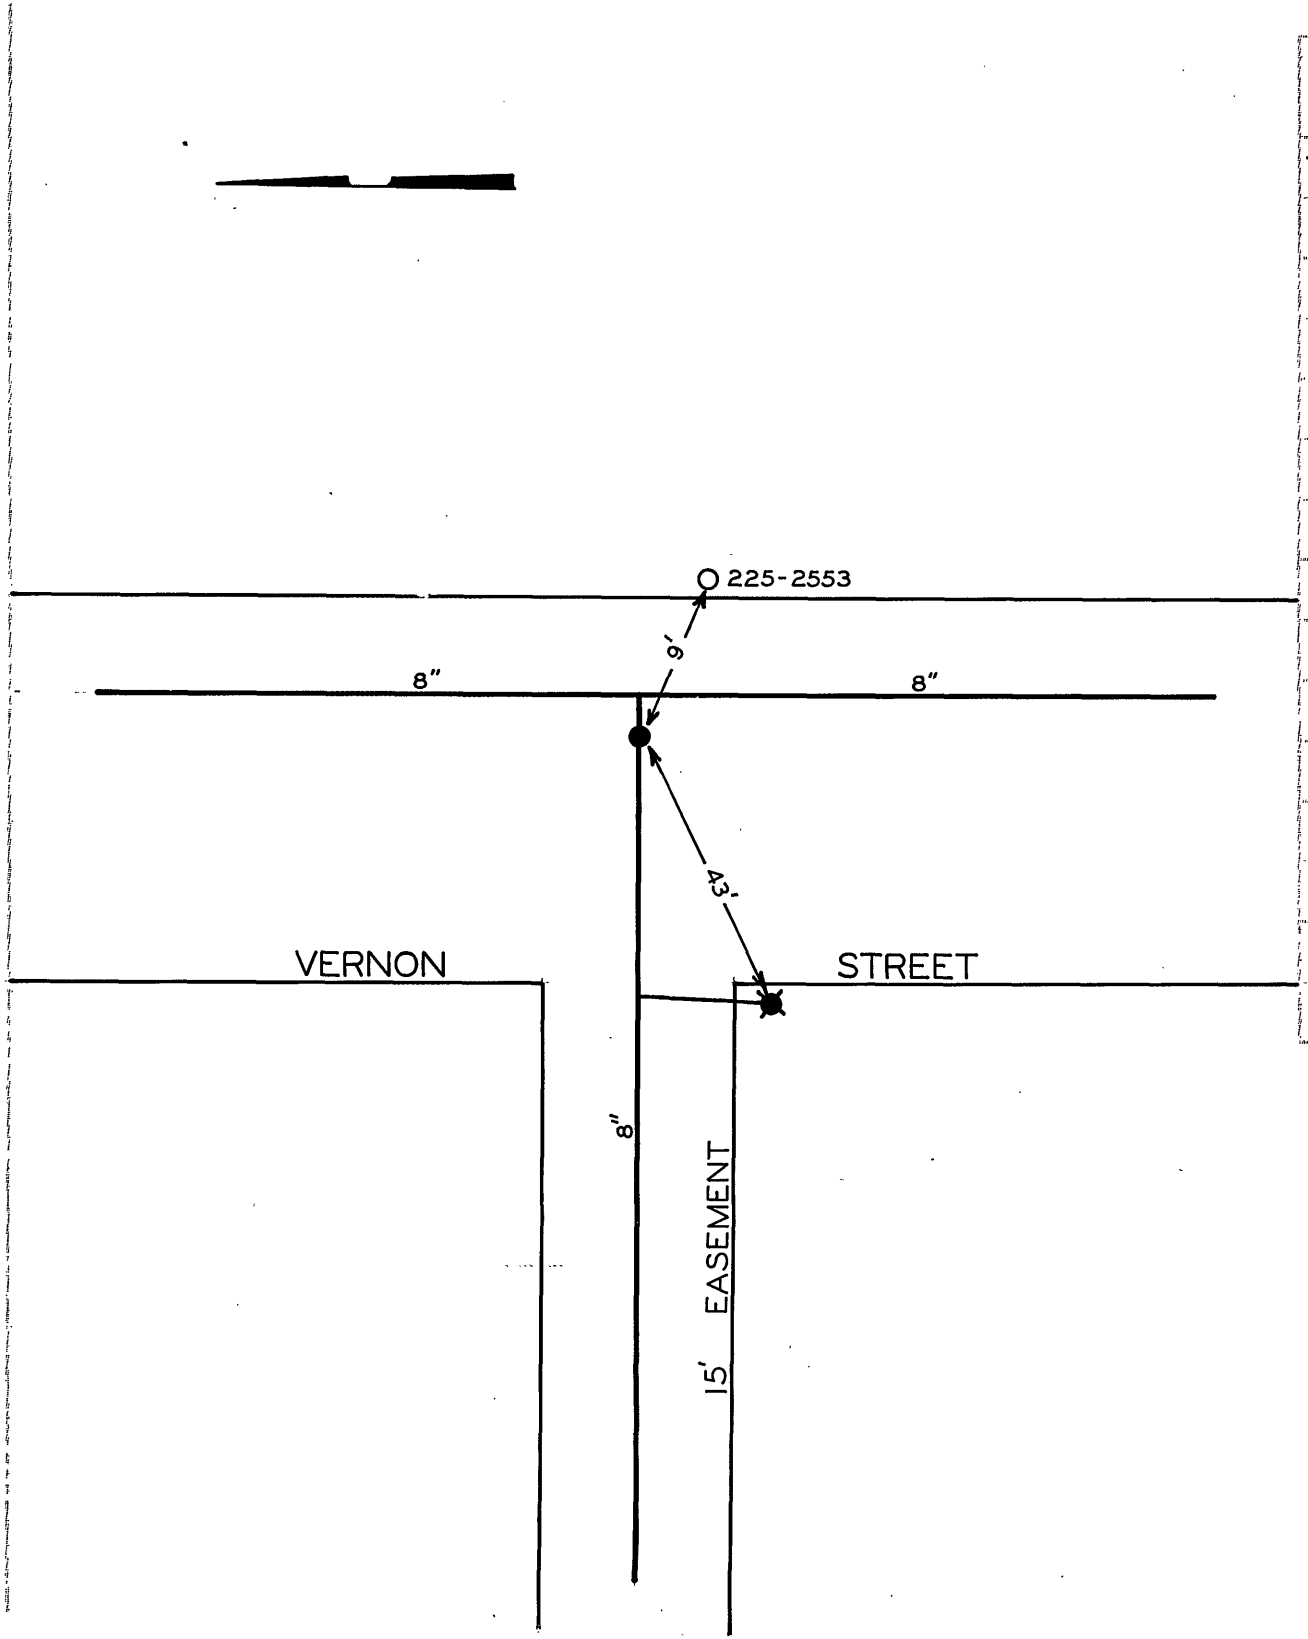

CITY OF ROCHESTER—WATER DEPT.

VALVE DIAGRAM

VERNON STREET S.E. - 630'

SOUTH OF DALE AVENUE - AT

PARKSIDE PLAZA

SEC. MAP 431

DATE PAGE NO.