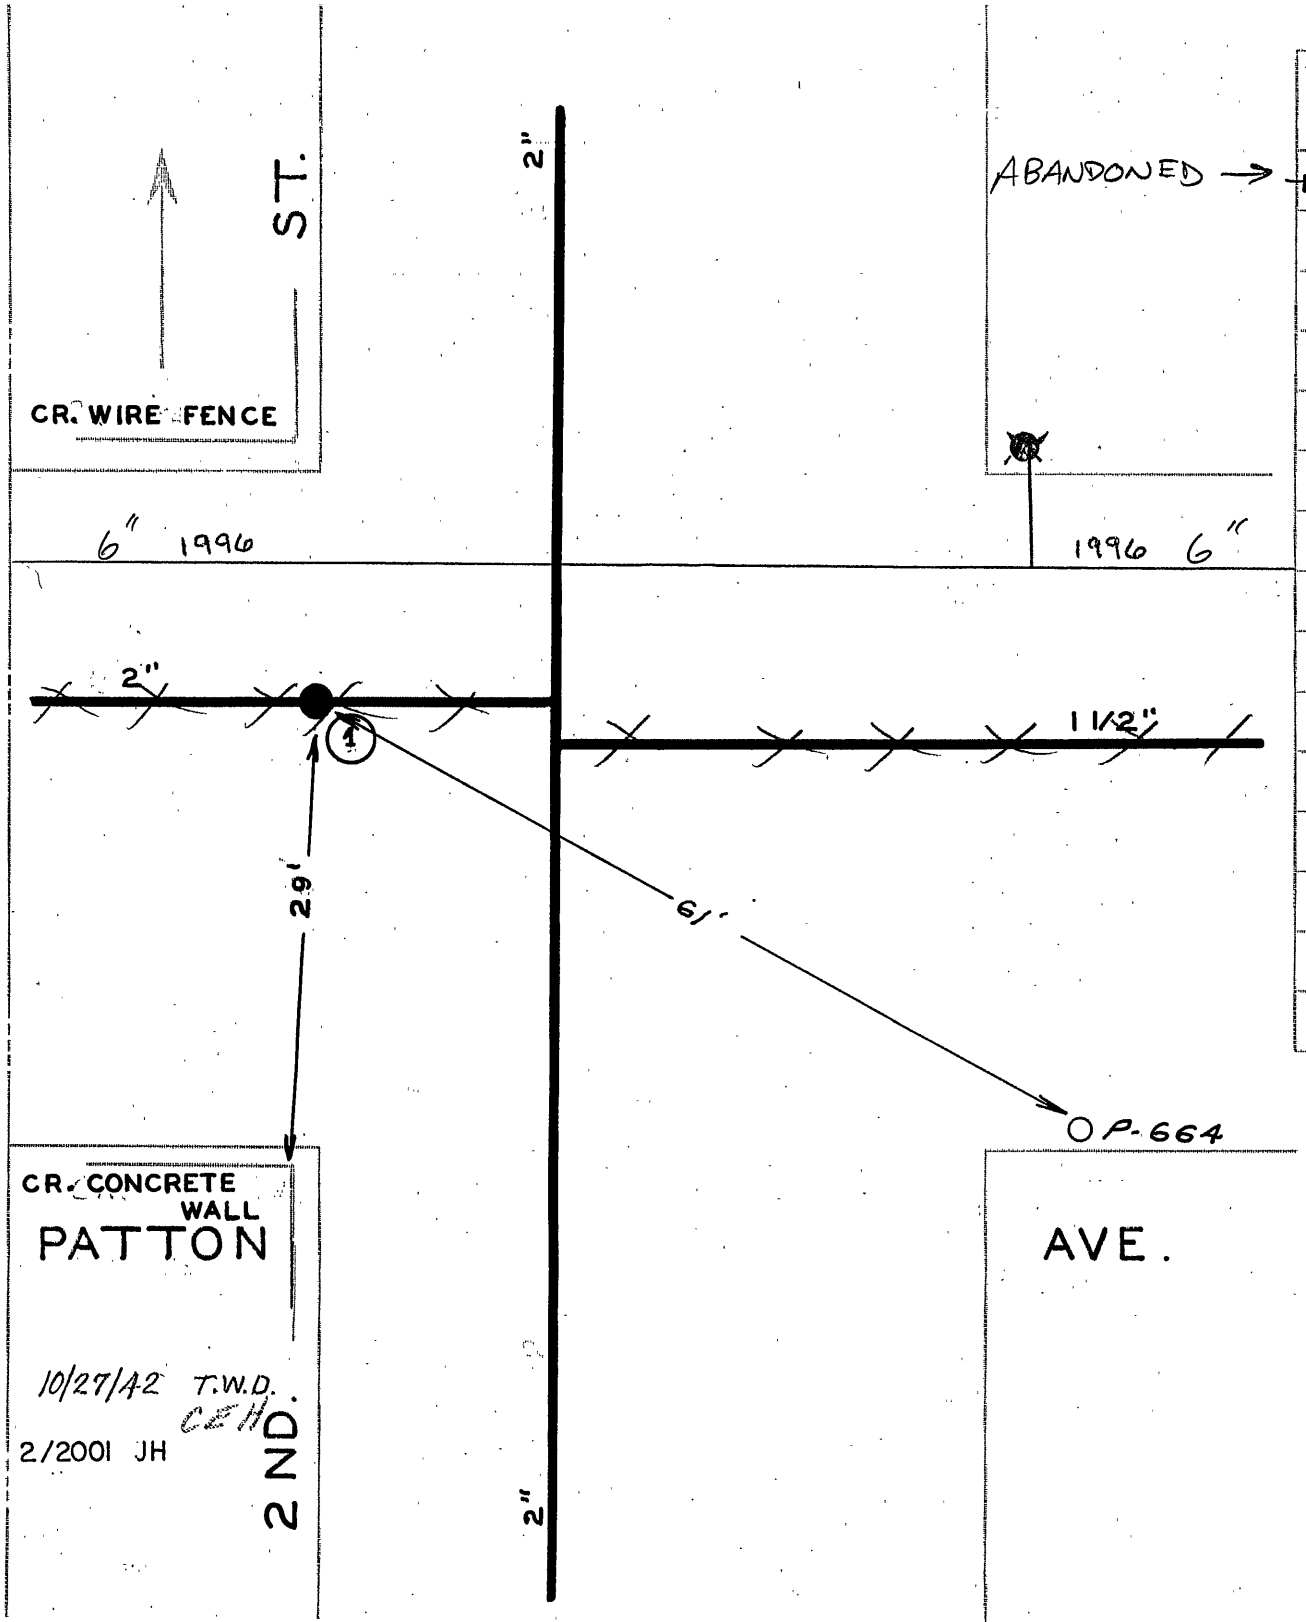

ABANDONED →

DATE	NO.	SIZE	MAKE	OPEN	TURNS
~~1911~~	~~1~~	~~2"~~		~~L~~	~~6~~
	1	0	WPL		

CITY OF ROANOKE—WATER DEP'T

VALVE DIAGRAM

PATTON AVE. & 2ND. ST. N.W.

SEC. MAP 201

DATE PAGE NO. NW 25