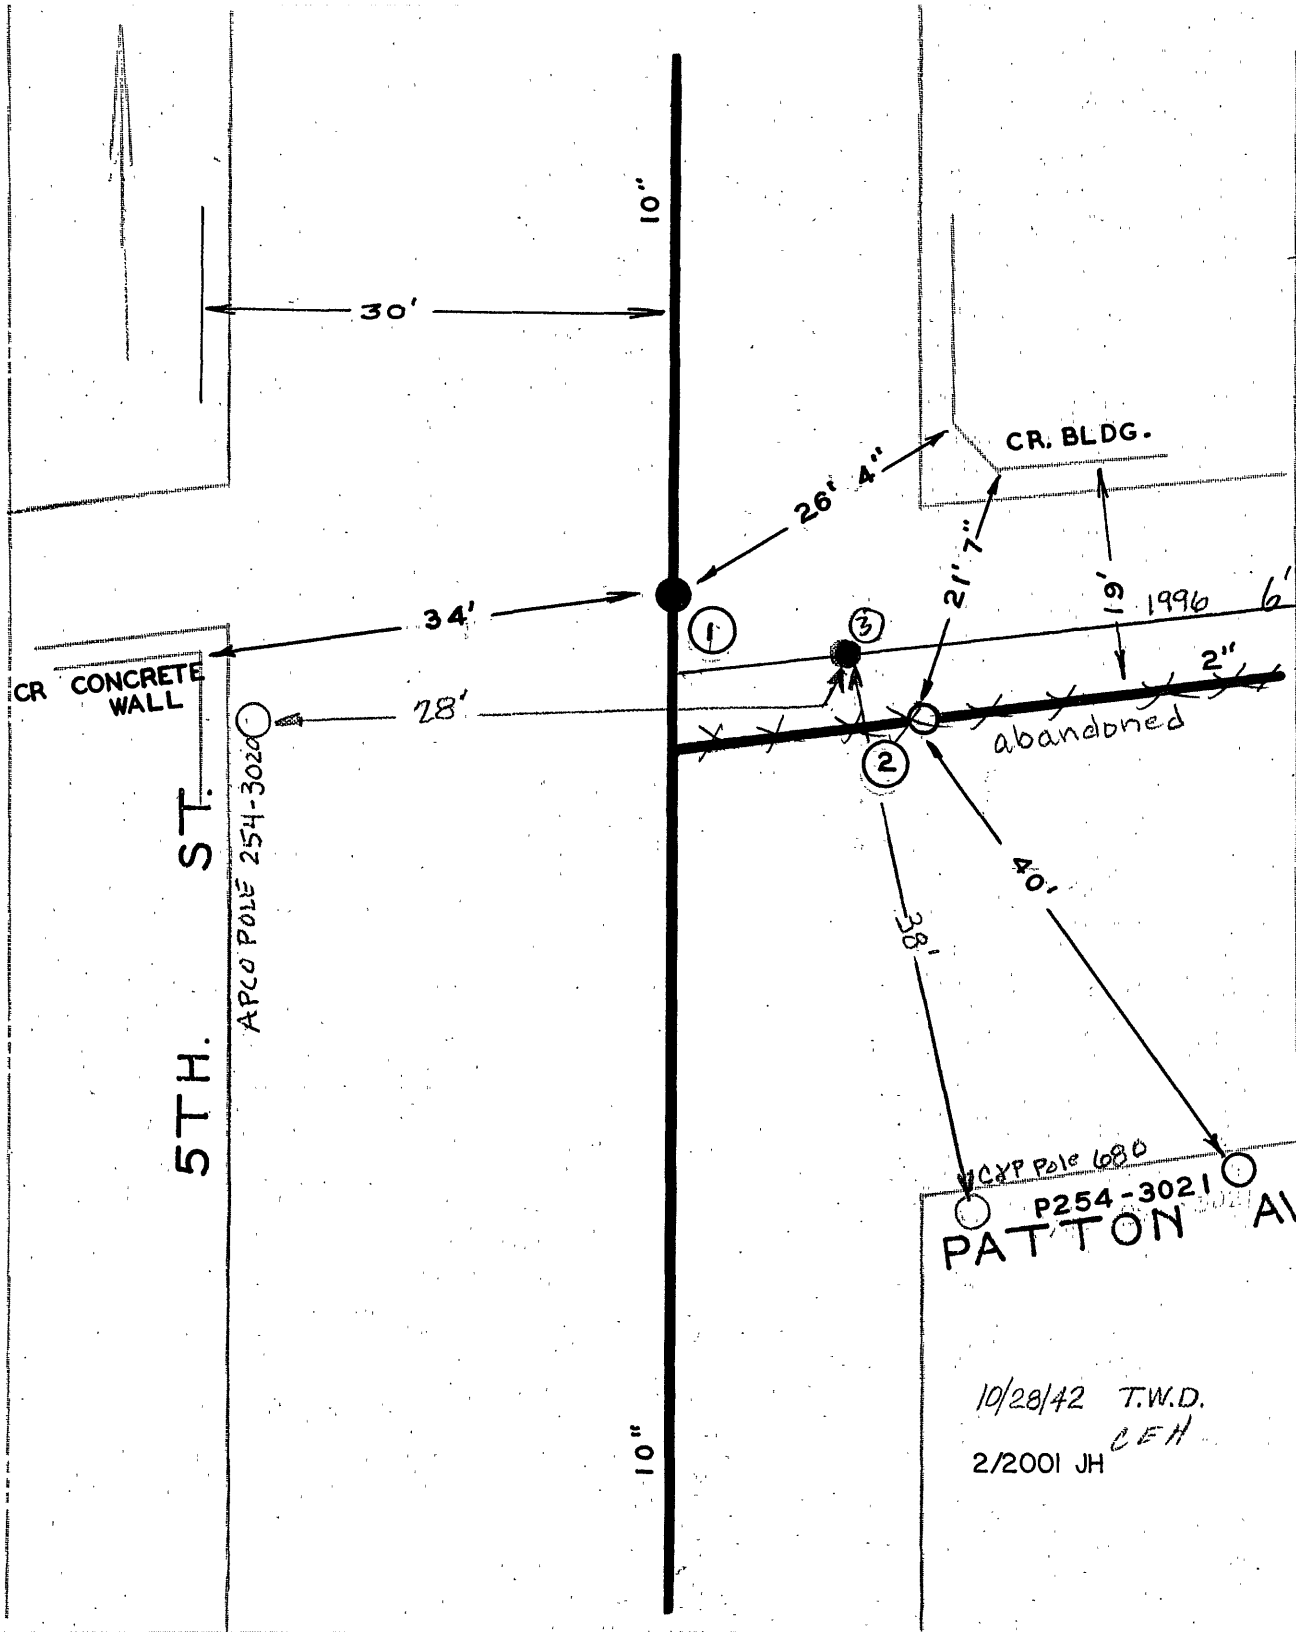

DATE	NO.	SIZE	MAKE	OPEN	TURNS
1891	1	10"		R	34 1/2
~~1899~~	~~2~~	~~2"~~		~~R~~	~~7~~
6/24 1996	3	6"			
	1	4"-S	NPL		
	2	0	EPL		

CCM

CITY OF ROANOKE—WATER DEP'T

VALVE DIAGRAM

PATTON AVE. &

5 TH STREET

NORTH INTERSECTION

SEC. MAP 201 NW

DATE PAGE NO. NW.28