w:\drawings\2021\2021-278\01-cad\01-engineering\02-design\21278-comp_pr-1.dwg

21278-comp_pr-1-15-pp12.plt

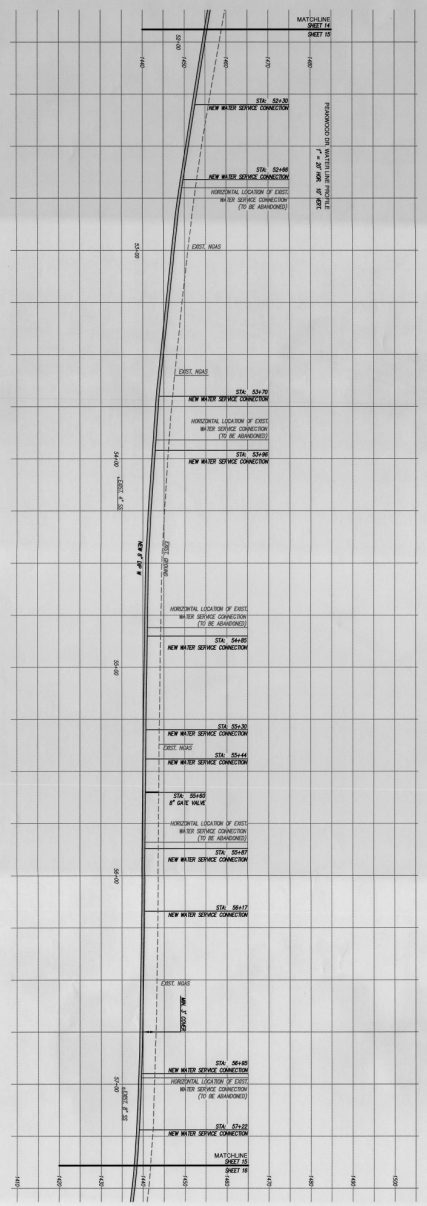

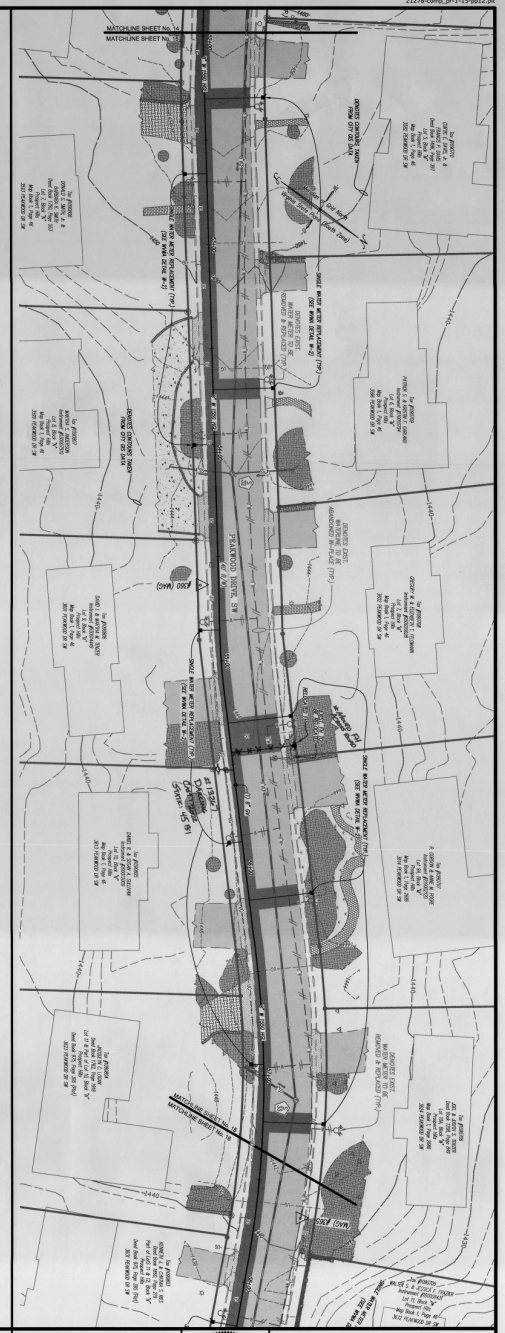

REVISIONS		
NO.	DATE	DESCRIPTION
1	3-9-2022	REVISED PAVEMENT RESTORATION AREA
2		
3		
4		
5		

DATE: February 2, 2022

SCALE: 1" = 20'

COMMISSION NO.: 21-278

SHEET 15 OF 20

PEAKWOOD DRIVE WATERLINE REPLACEMENTS

PREPARED FOR

WESTERN VIRGINIA WATER AUTHORITY

SITUATED IN

THE CITY OF ROANOKE, VIRGINIA

PLAN & PROFILE PEAKWOOD DRIVE (STA. 52+00 - 57+50)

ANDREW R. LUMSDEN LIC. NO. 2705 STATE OF VIRGINIA PROFESSIONAL ENGINEER 4-4-22

Lumsden Associates, P.C.
ENGINEERS | SURVEYORS | PLANNERS

4664 BRAMBLETON AVENUE
P.O. BOX 20569
ROANOKE, VIRGINIA 24018

PHONE: (540) 774-6411
FAX: (540) 772-9445
WWW.LUMSDENPC.COM