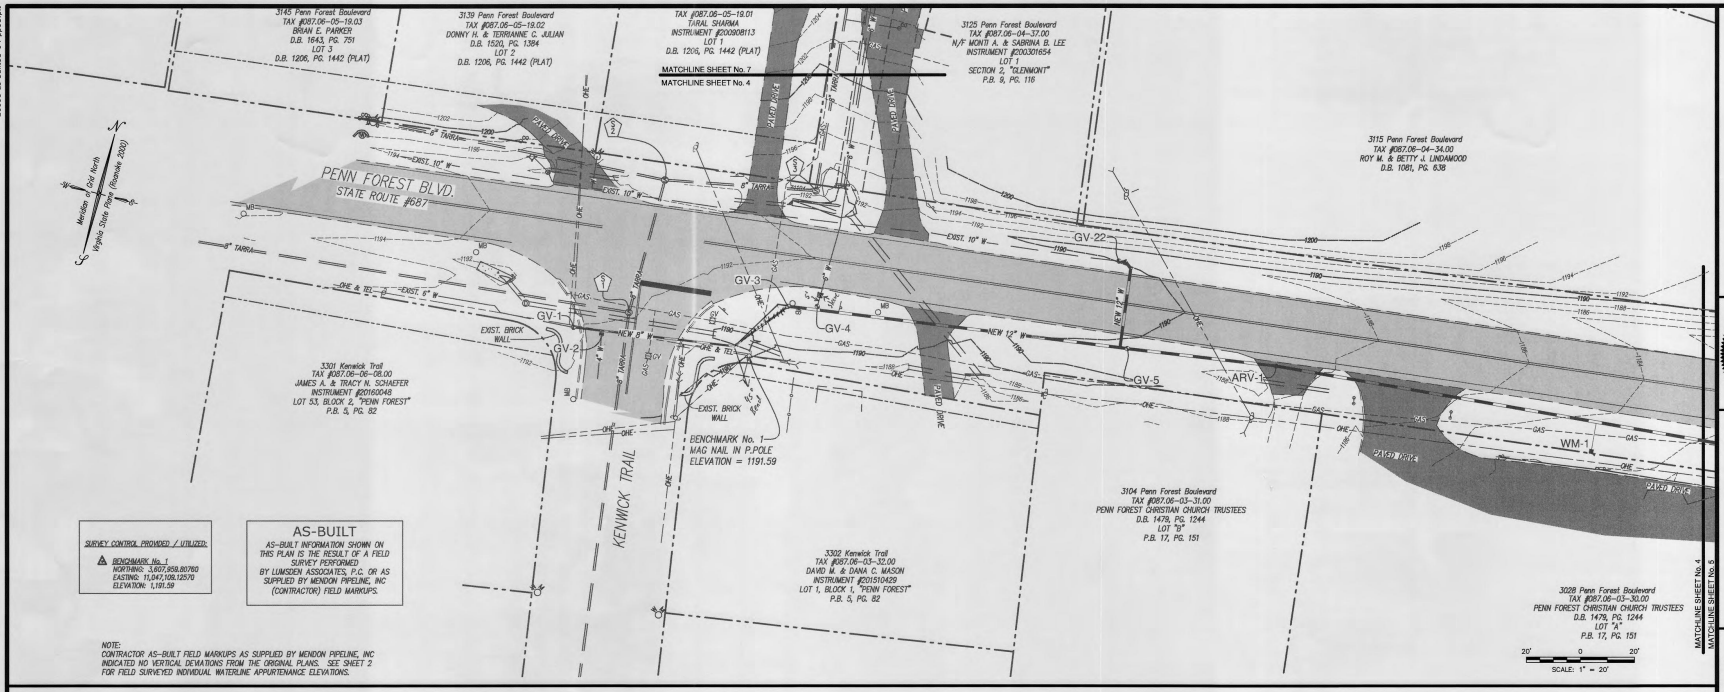

SURVEY CONTROL PROVIDED / UTILIZED:

BENCHMARK No. 1
NORTHING: 3,607,959.80760
EASTING: 11,047,109.12570
ELEVATION: 1,191.59

AS-BUILT

AS-BUILT INFORMATION SHOWN ON THIS PLAN IS THE RESULT OF A FIELD SURVEY PERFORMED BY LUMSDEN ASSOCIATES, P.C. OR AS SUPPLIED BY MENDON PIPELINE, INC (CONTRACTOR) FIELD MARKUPS.

NOTE:
CONTRACTOR AS-BUILT FIELD MARKUPS AS SUPPLIED BY MENDON PIPELINE, INC INDICATED NO VERTICAL DEVIATIONS FROM THE ORIGINAL PLANS. SEE SHEET 2 FOR FIELD SURVEYED INDIVIDUAL WATERLINE APPURTENANCE ELEVATIONS.

Lumsden Associates, P.C.
ENGINEERS | SURVEYORS | PLANNERS
4664 BRAMBLETON AVENUE
P.O. BOX 20669
ROANOKE, VIRGINIA 24018
PHONE: (540) 774-4411
FAX: (540) 772-9445
WWW.LUMSDENPC.COM

COMMONWEALTH OF VIRGINIA
ANDREW P. LUMSDEN
Lic. No. 002216
5/18/21
PROFESSIONAL ENGINEER

AS-BUILT PLAN

PENN FOREST/ GLENMONT WATERLINE REPLACEMENTS

PREPARED FOR
WESTERN VIRGINIA WATER AUTHORITY
SITUATED IN
ROANOKE COUNTY, VIRGINIA

REVISIONS		
NO.	DATE	DESCRIPTION
1		
2		
3		
4		
5		

DATE: May 18, 2021
SCALE: 1" = 20'
COMMISSION NO: 20-008
SHEET 4 OF 11

20008-as-built01-04-pp01.pdf

w:\drawings\2020\2020-008\01-cad\01-engineering\04-as-built\20008-as-built01.dwg