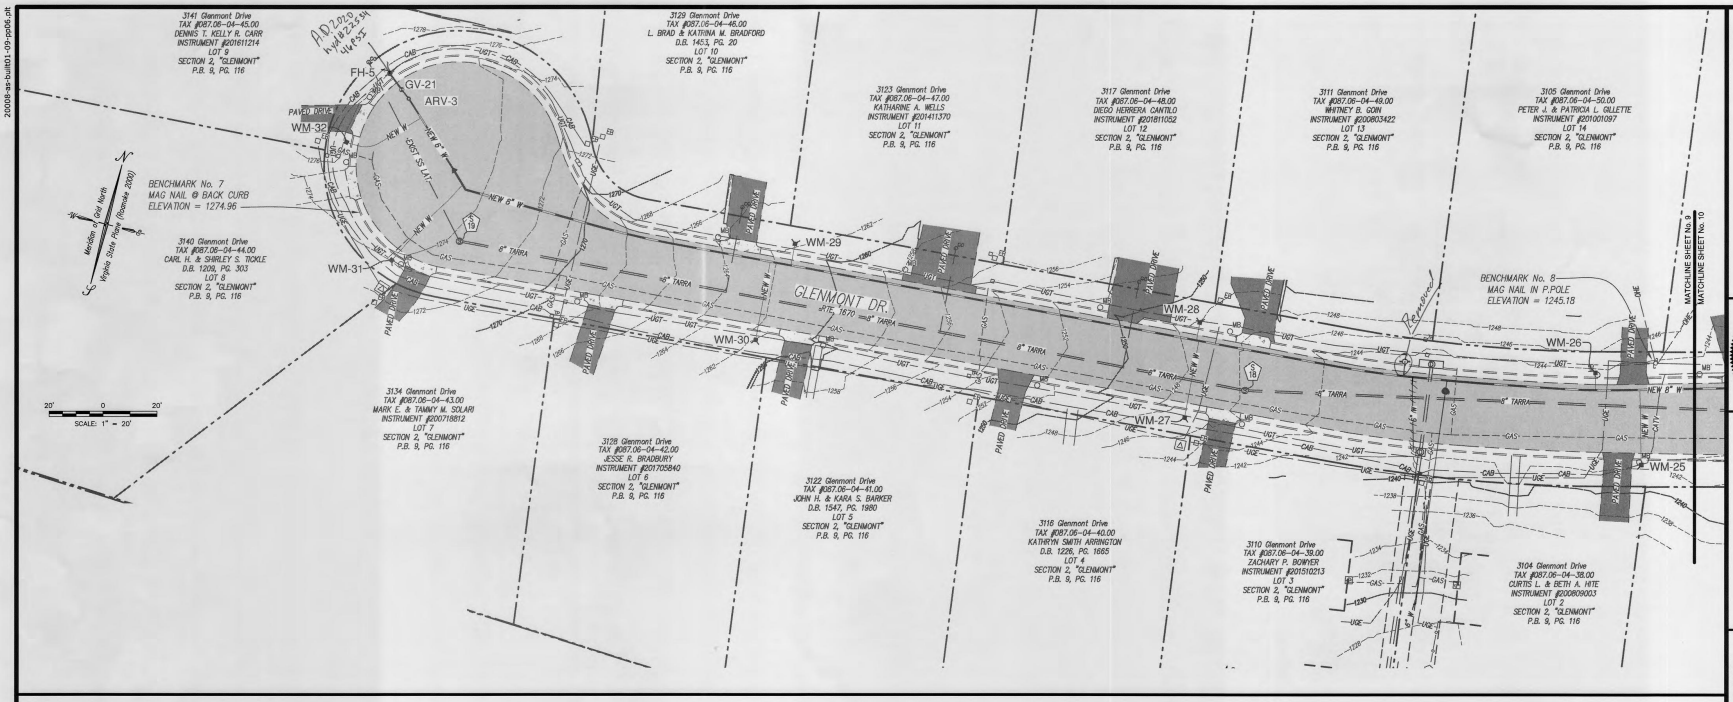

SURVEY CONTROL PROVIDED / UTILIZED:

BENCHMARK No. 7
NORTHING: 3,608,341.62131
EASTING: 11,046,685.19076
ELEVATION: 1,274.96

BENCHMARK No. 8
NORTHING: 3,608,409.25990
EASTING: 11,047,166.94670
ELEVATION: 1,245.18

AS-BUILT

AS-BUILT INFORMATION SHOWN ON THIS PLAN IS THE RESULT OF A FIELD SURVEY PERFORMED BY LUMSDEN ASSOCIATES, P.C. OR AS SUPPLIED BY MENDON PIPELINE, INC (CONTRACTOR) FIELD MARKUPS.

NOTE:
CONTRACTOR AS-BUILT FIELD MARKUPS AS SUPPLIED BY MENDON PIPELINE, INC INDICATED NO VERTICAL DEVIATIONS FROM THE ORIGINAL PLANS. SEE SHEET 2 FOR FIELD SURVEYED INDIVIDUAL WATERLINE APPURTENANCE ELEVATIONS.

Lumsden Associates, P.C.
ENGINEERS | SURVEYORS | PLANNERS
4664 BRAMBLETON AVENUE
ROANOKE, VIRGINIA 24018
PHONE: (540) 774-4411
FAX: (540) 774-4417
WWW.LUMSDENPC.COM

COMMONWEALTH OF VIRGINIA
ANDREW P. LUMSDEN
Lic. No. 028918
5/18/21
PROFESSIONAL ENGINEER

PLAN & PROFILE

PENN FOREST/ GLENMONT WATERLINE REPLACEMENTS

PREPARED FOR
WESTERN VIRGINIA WATER AUTHORITY
SITUATED IN
ROANOKE COUNTY, VIRGINIA

REVISIONS		
NO.	DATE	DESCRIPTION
1		
2		
3		
4		
5		

DATE: May 18, 2021
SCALE: 1" = 20'
COMMISSION NO: 20-008
SHEET 9 OF 11

20008-as-built01-09-pp06.plt
w:\drawings\2020\2020-008\01-cad\01-engineering\04-as-built\20008-as-built01.dwg