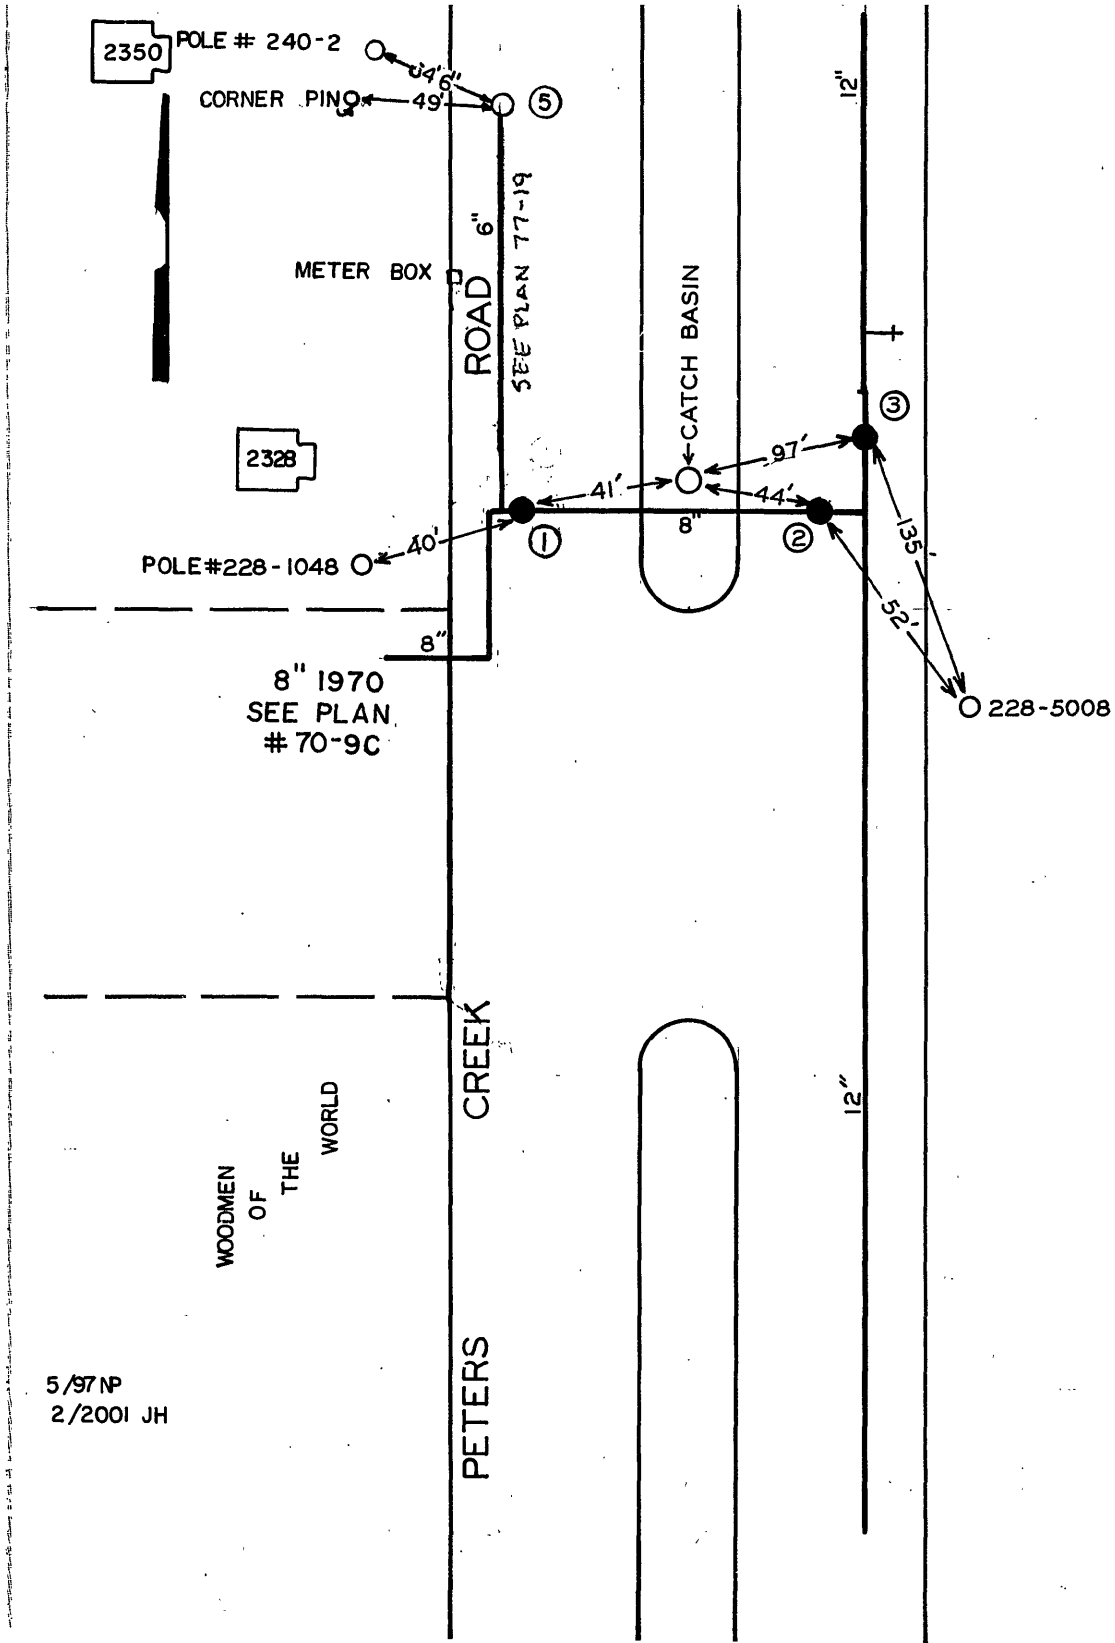

5/97 NP
2/2001 JH

DATE	NO.	SIZE	MARK	OPEN	TURNS
70	1	8"	MUELLER	R	
70	2	8"	MUELLER	R	
70	3	12"	MUELLER	R	
~~1977~~	~~4~~	~~6"~~	~~MUELLER~~	~~R~~	
1977	5	2"	BLOW OFF	L	
	1	30'-E	W.P.L.		
	2	18'-W	E.P.L.		

CITY OF ROANOKE—WATER DEPT
VALVE DIAGRAM

PETERS CREEK ROAD
450' NORTH OF ~~HARTMAN DR.~~
WOODBRIDGE AVE.

SEC. MAP 616, 637 NW (2)

DATE PAGE NO.