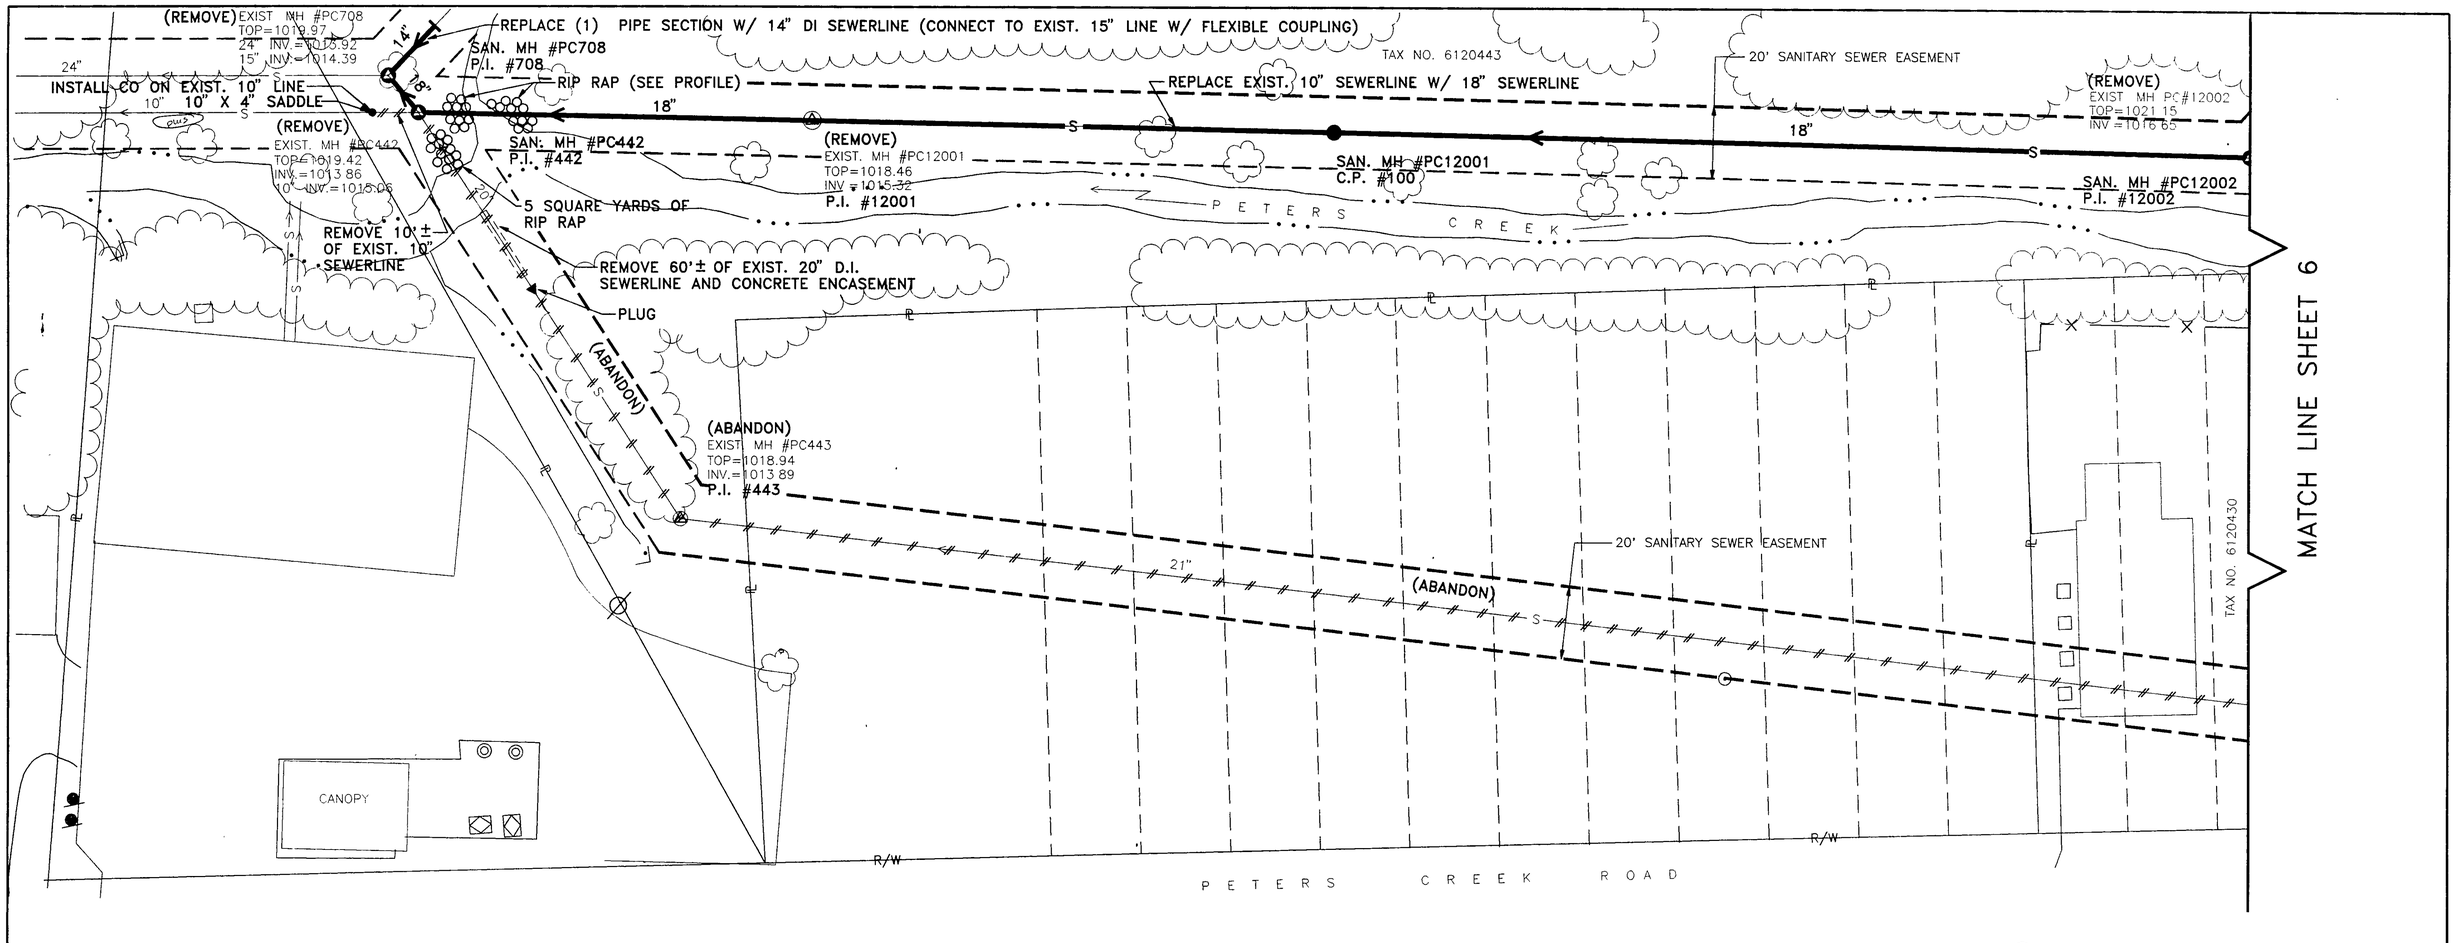

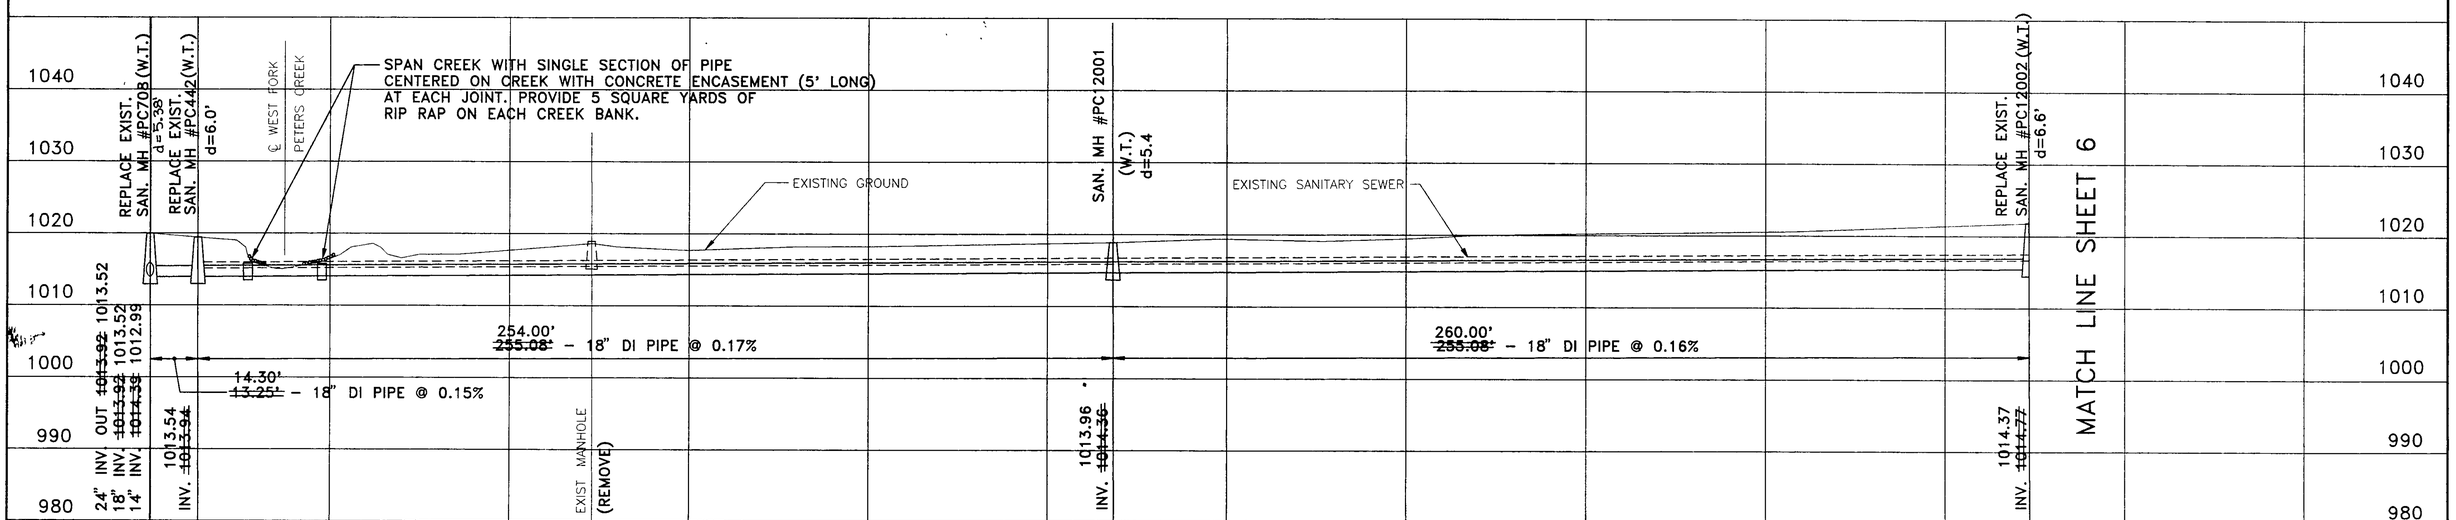

RECORD DRAWINGS
1-11-94

Mattern & Craig
CONSULTING ENGINEERS – SURVEYORS

DESIGNED: TAM
DRAWN: TAM
CHECKED: SWH

NORTH

COMMONWEALTH OF VIRGINIA
STEWART W. HUBBELL
NO. 07420
PROFESSIONAL ENGINEER
1/12/94

REV.	DATE	DESCRIPTION	BY	APP.
1	1/11/94	RECORD DRAWINGS	TAM	SWH

DATE: MAY 1993

COMM. NO. 1245

SEWER REPLACEMENT PROJECT PC-1
PETERS CREEK SEWERSHED
PLAN AND PROFILE
CITY OF ROANOKE, VIRGINIA

SCALE: 1"=20' HORIZ.
1"=10' VERT.

SHEET 5

PROJECT NO. 6245