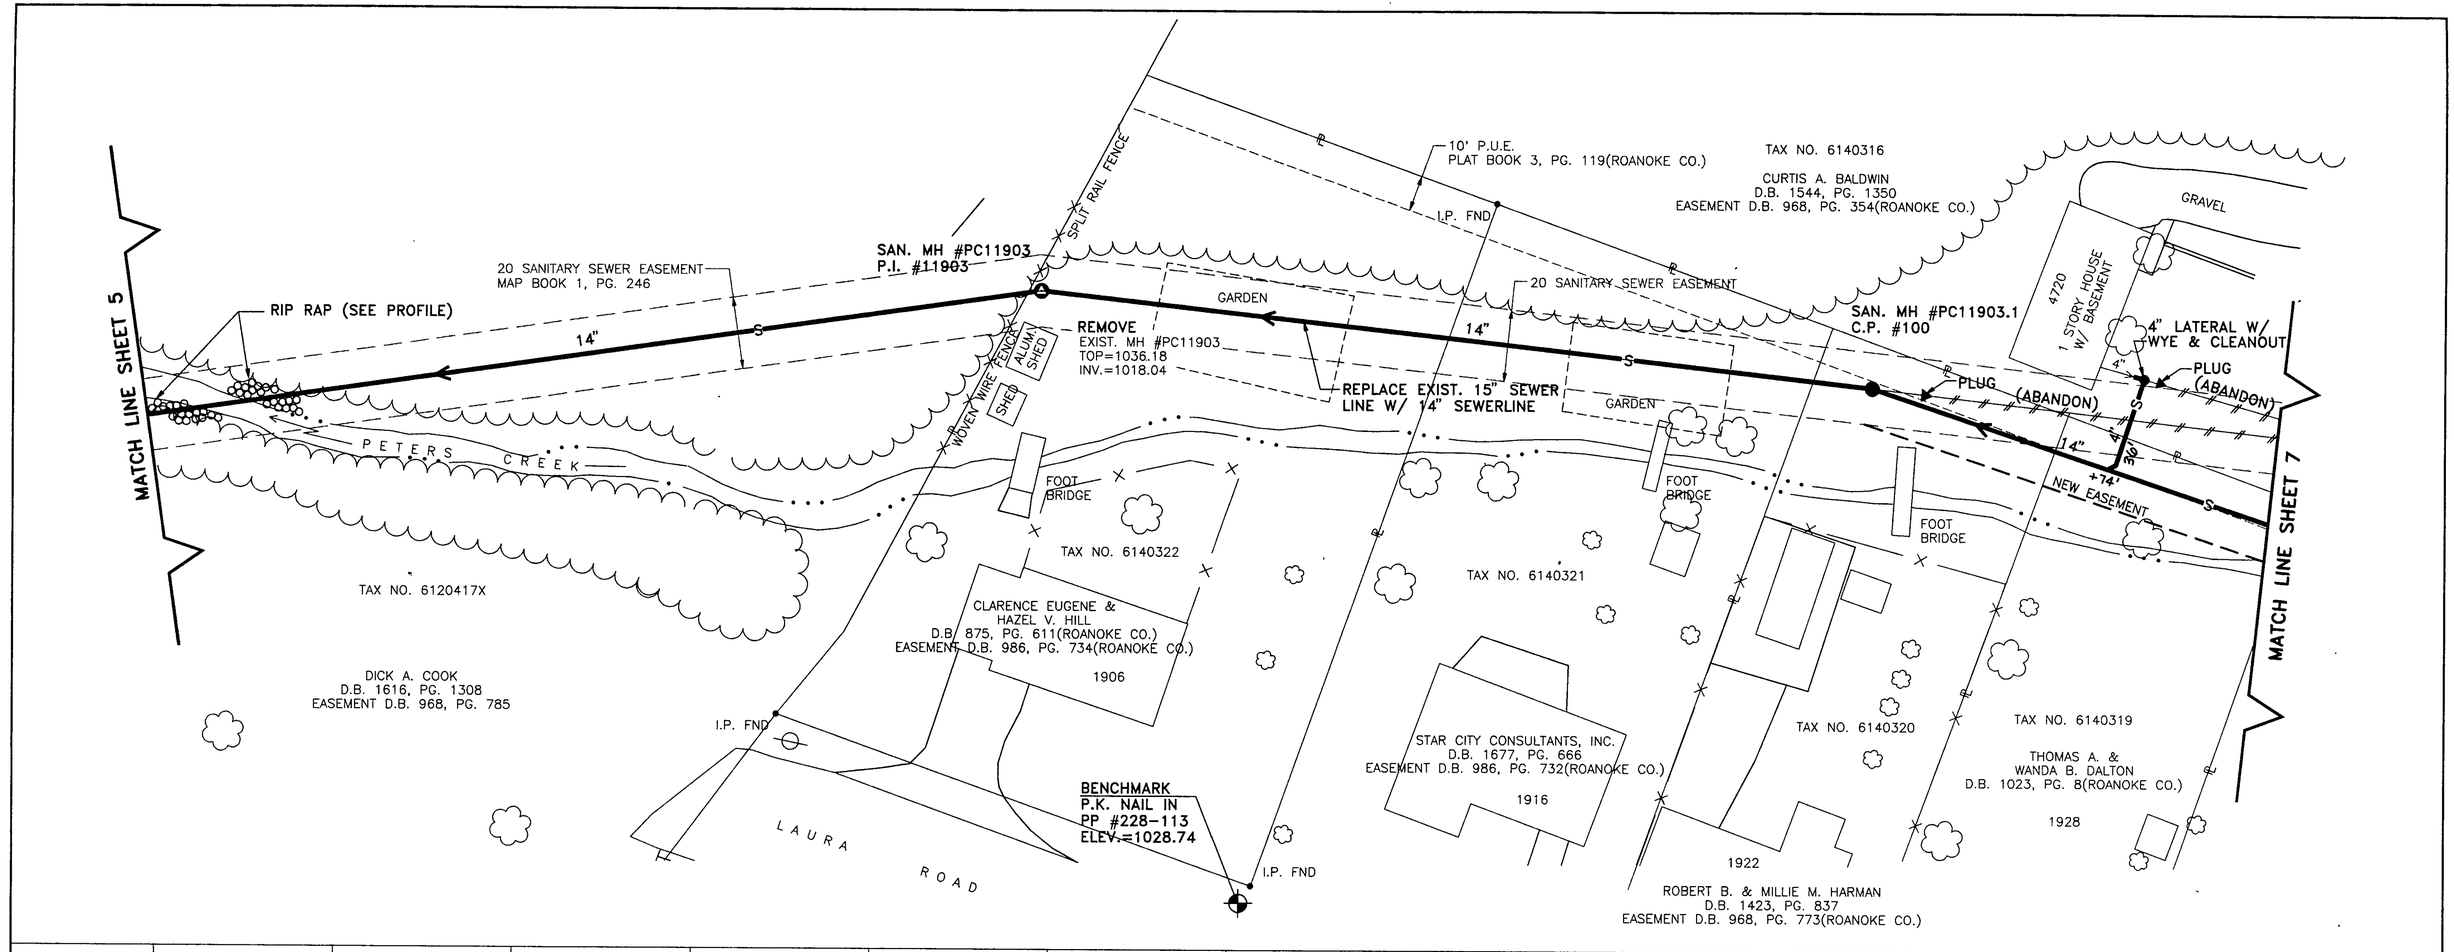

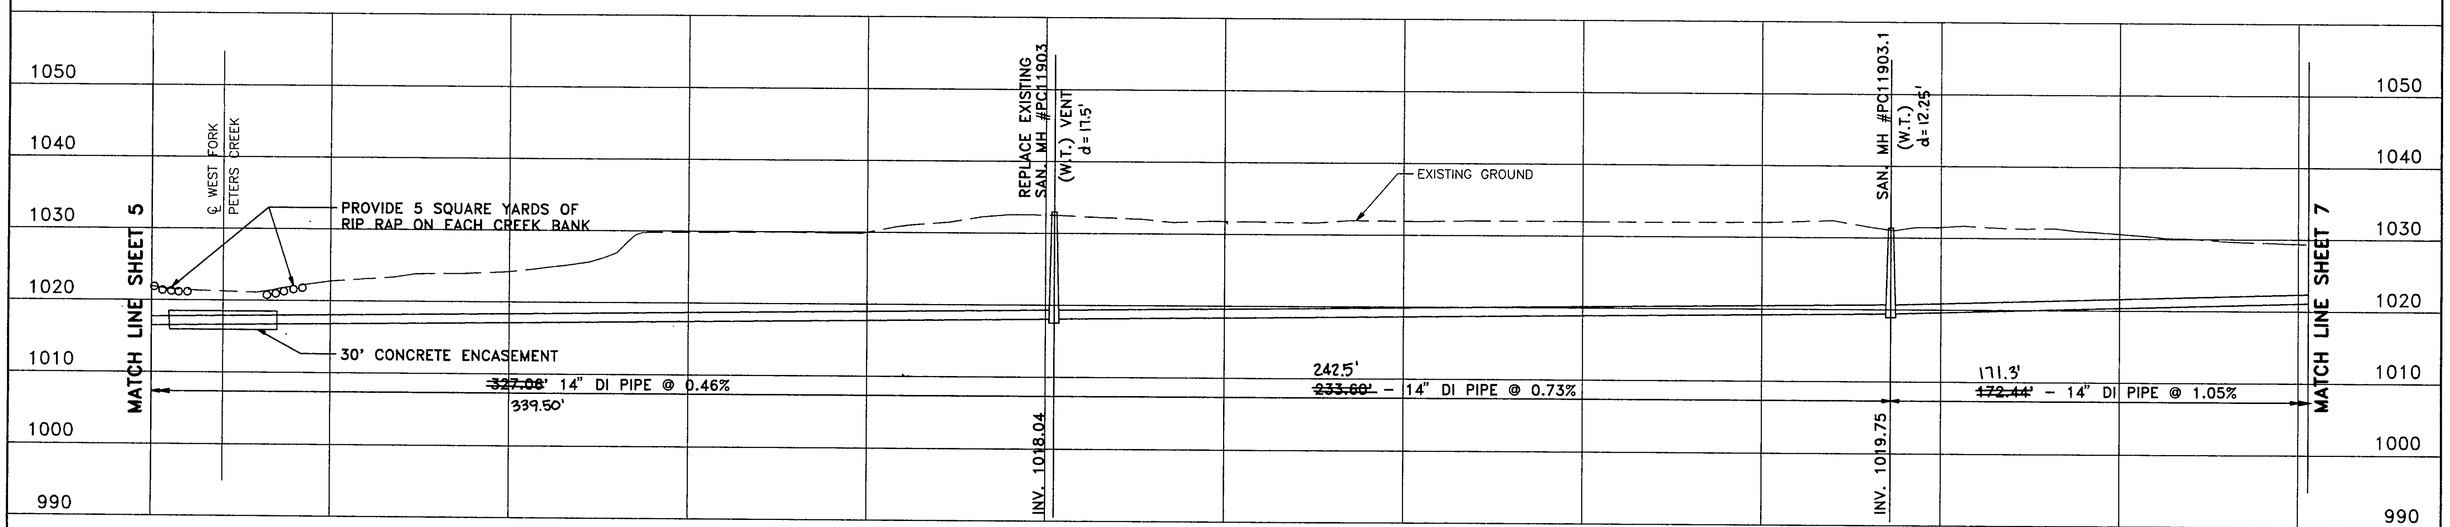

RECORD DRAWINGS
JUNE 1, 1994

Mattern & Craig
CONSULTING ENGINEERS – SURVEYORS

DESIGNED: TAM
DRAWN: TAM
CHECKED: SWH

NORTH

COMMONWEALTH OF VIRGINIA
STEWART W. HUBBELL
NO. 07420
PROFESSIONAL ENGINEER
5/27/93

REV.	DATE	DESCRIPTION	BY	APP.
1	6-1-94	RECORD DRAWINGS	TAM	SWH

DATE: JUNE 1993

COMM. NO. 1245A

PETERS CREEK SANITARY SEWER REPLACEMENT
PROJECT PC-2
PLAN AND PROFILE
CITY OF ROANOKE, VIRGINIA

SCALE: 1"=20' HORIZ.
1"=10' VERT.

SHEET 6

PROJECT NO. 6245A