
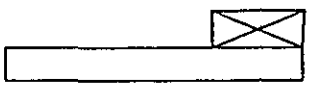
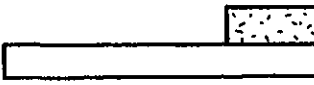
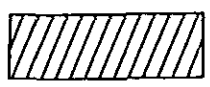
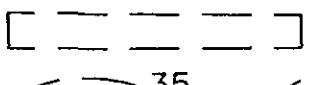
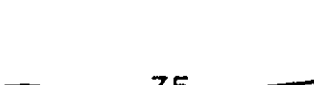
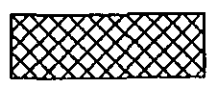
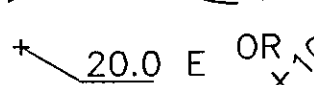
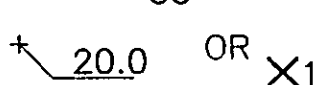
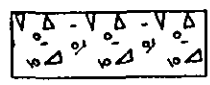
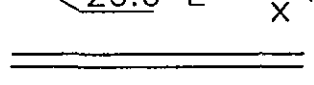
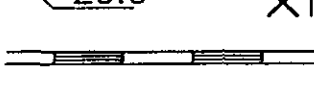

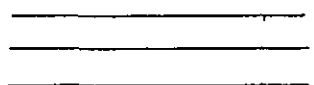
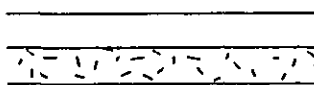
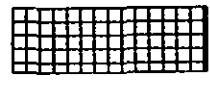
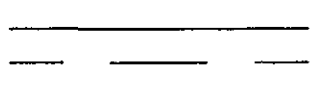
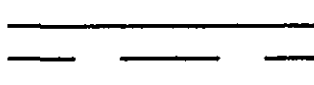
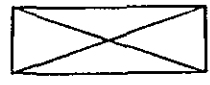





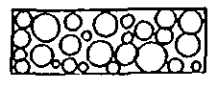
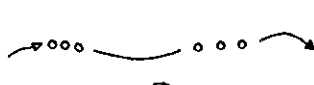
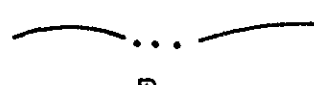

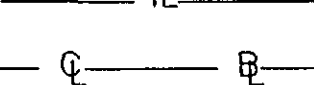
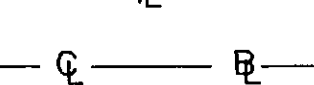

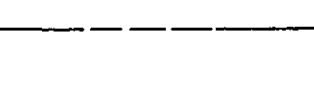
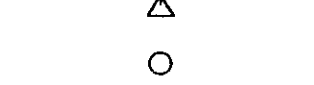
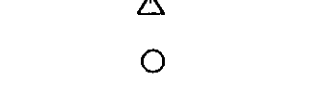


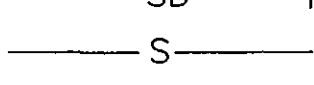
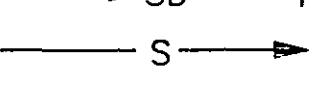
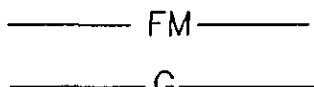
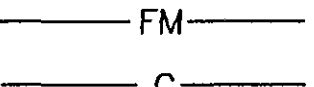
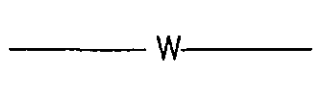
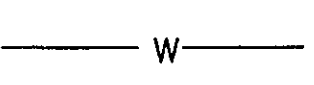
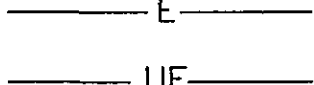
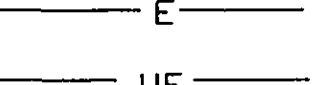
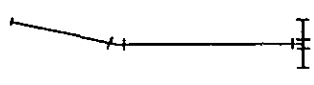
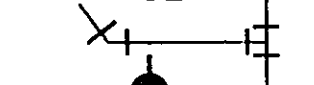
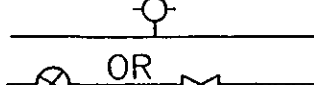
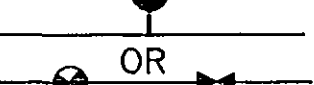
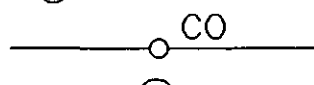
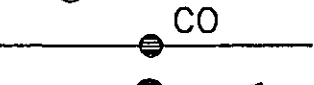

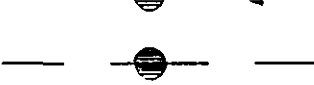


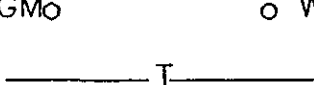
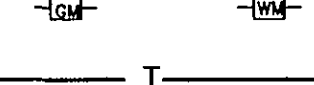
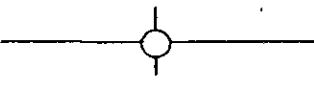

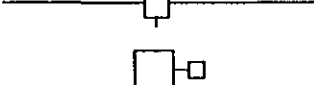




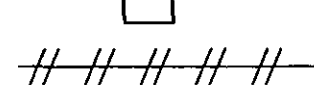
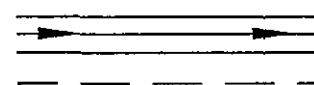
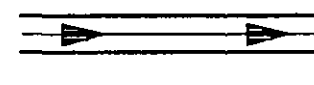
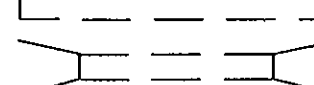
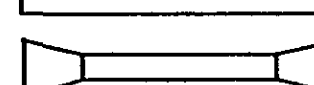
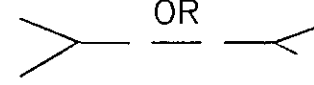
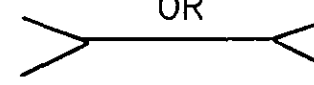













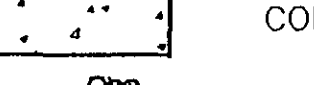



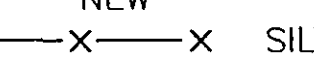

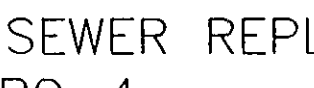


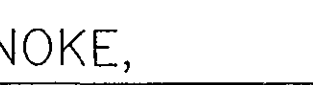



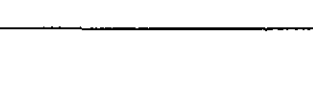
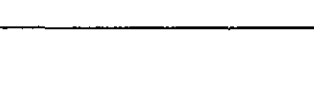











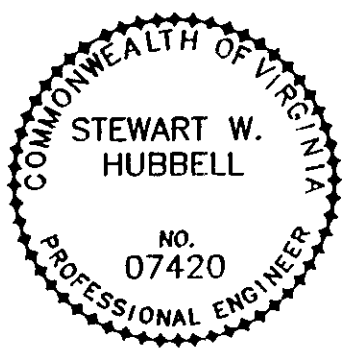


						MATERIALS SYMBOLS		EXISTING	NEW	DESCRIPTION
AB	ANCHOR BOLT	EW	EACH WAY, ENDWALL	PLYWD	PLYWOOD		METAL			BUILDING WITH PORCH OR STOOP
ABAN	ABANDON OR ABANDONED	EXIST	EXISTING	POL	POINT ON LINE		BRICK			FOUNDATION ONLY
ABUT	ABUTEMENT	EXP	EXPANSION	PP	POWER POLE		CONCRETE MASONRY			CONTOUR, CONTOUR WITH ELEVATION
ABV	ABOVE	EXT	EXTERIOR	POT	POINT ON TANGENT		CONCRETE			SPOT ELEVATION
ACT	ACOUSTICAL	FR	FRAME	PRC	POINT OF REVERSE CURVE		GROUT OR FINISHED CONCRETE			CONCRETE CURB
ADD	ADDITIONAL	FD	FLOOR DRAIN	PSI	POUNDS PER SQUARE INCH		INSULATION (RIGID)			CONCRETE CURB & GUTTER
ADJ	ADJACENT	FDN	FOUNDATION	PT	POINT OF TANGENT		WOOD BLOCKING			CONCRETE WALK OR SLAB
AFF	ABOVE FINISH FLOOR	FES	FLARED END SECTION	PVC	POLYVINYL CHLORIDE		FINISHED WOOD OR PLYWOOD			PAVEMENT
AGGR	AGGREGATE	FF	FINISH FLOOR	PVT	POINT OF VERTICAL INTERSECTION		GRAVEL OR STONE			UNPAVED OR GRAVEL ROAD
ALUM	ALUMINUM	FFE	FINISHED FLOOR ELEVATION	PVMT	PAVEMENT		EARTH			TREE LINE
ALT	ALTERNATE	FH	FIRE HYDRANT	R	RADIUS, RISER					TREE OR SHRUB
ANC	ANCHOR	FIG	FIGURE	RAS	RETURN ACTIVATED SLUDGE					FENCE
APPROX	APPROXIMATE	FIN	FINISH	RR	RAIL ROAD					CENTERLINE CREEK, SWALE OR DITCH
ARCH	ARCHITECTURAL	FIXT	FIXTURE	RCP	REINFORCED CONCRETE PIPE					PROPERTY LINE
AWWA	AMERICAN WATER WORKS ASSOCIATION	FL	FLOOR	RD	ROOF DRAIN, ROAD					CENTERLINE OR BASELINE
AVG	AVERAGE	FLEX	FLEXIBLE	RDCR	REDUCER					LIMIT OF WORK LINE
BIT	BITUMINOUS	FLG	FLANGE	RECPT	RECEPTACLE					FIELD SURVEY TRAVERSE POINT
BJ	BELL JOINT	FT	FOOT	RECT	RECTANGULAR					P.C. OR P.T.
BL	BASE LINE	FUT	FUTURE	REINF	REINFORCE, REINFORCEMENT					GEOLOGIC BORE HOLE
BEG	BEGIN OR BEGINNING	GAL	GALLON	REF	REFERENCE					STORM DRAIN AND ENDWALL
BLDG	BUILDING	GALV	GALVANIZED	REL	RELOCATED					SANITARY SEWER
BLKG	BLOCKING	GAR	GARAGE	REQD	REQUIRED					FORCE MAIN
BM	BENCH MARK, BEAM	GND	GROUND	REV	REVISION					GAS MAIN OR SERVICE LINE
BOTT	BOTTOM	GR	GRAVEL	RTE	ROUTE					WATER MAIN OR SERVICE LINE
BP	BYPASS	GOVT	GOVERNMENT	RT	RIGHT					ELECTRICAL LINE
BRG	BEARING	GPM	GALLONS PER MINUTE	R/W	RIGHT OF WAY					UNDERGROUND ELECTRICAL LINE
BSMT	BASEMENT	GRTG	GRATING	S	SANITARY SEWER, SOUTH, SWITCH					PIPE FITTINGS
BV	BUTTERFLY VALVE	GV	GATE VALVE	SAN	SANITARY					FIRE HYDRANT
C	CHANNEL, COLD	GW	GRAY WATER	SCH	SCHEDULE					GATE VALVE
C/C, C TO C	CENTER TO CENTER	H	HOT	SD	STORM DRAIN					CLEANOUT
CAB	CABINET	HB	HOSE BIBB	SECT	SECTION					MANHOLE
CAP	CAPACITY	HK	HOOK	SER	SERVICE					SEWER BY VDOT CONTRACTOR
CF	CUBIC FEET	HM	HOLLOW METAL	SH	SHEET					DROP INLET (CURB AND GRATING TYPES)
CG	CHANGE OF GRADE	HOR, HORIZ	HORIZONTAL	SHTG	SHEETING					G.M. - GAS METER, W.M. - WATER METER
C & G	CURB AND GUTTER	HP	HORSE POWER	SIM	SIMILAR					TELEPHONE LINE
CI	CAST IRON	HPT	HIGH POINT	SPEC	SPECIFICATION					TELEPHONE POLE, GUY AND ANCHOR
CIRC	CIRCULAR	HYD	HYDRANT	SQ	SQUARE					POWER POLE, GUY AND ANCHOR
CKT	CIRCUIT	ID	INSIDE DIAMETER	SS	STAINLESS STEEL					LIGHT POLE
CL	CLEAR	IN	INCH	ST	STREET					TELEPHONE PEDESTAL
CLR	CLEAR	INCH	INCH	STA	STATION					BURIED TELEPHONE VAULT
CONST	CONSTRUCTION	INSUL	INSULATION	STD	STANDARD					ABANDON OR REMOVE
COR	CORNER	INV	INVERT	STL	STEEL					PAVED DITCH
CMP	CORRUGATED METAL PIPE	IP	IRON PIN	STL	STEEL					DRIVEWAY CULVERT
CMU	CONCRETE MASONRY UNITS	JT	JOINT	STRUCT	STRUCTURAL					CULVERT WITH FLARED END SECTION
CND	CONDUIT	JB	JUNCTION BOX	STY	STORY					
CO	CLEAN OUT	LG	LENGTH, LONG	SUR	SURVEY					
COMB	COMBINATION	LF	LINEAL FOOT	SURF	SURFACE					
CONC	CONCRETE	LG	LONG	S/W	SIDEWALK					
CONN	CONNECT, CONNECTION	LP	LIGHT POLE	SYMM	SYMMETRICAL					
CONT	CONTINUOUS, CONTROL	LR	LONG RADIUS	T	TREAD, TOP					
CONTR	CONTRACTOR	LT	LEFT	T & B	TOP AND BOTTOM					
CONV	CONVEYOR	LTG	LIGHTING	TDC	TURNED DOWN CURB					
CP	COORDINATE POINT	MACH	MACHINERY	TELE	TELEPHONE					
CR STONE	CRUSHED STONE	MAS	MASONRY	TEMP	TEMPORARY					
CTR	CENTER	MATL	MATERIAL	THK	THICK					
CULV	CULVERT	MAX	MAXIMUM	TP	TELEPHONE POLE					
CY	CUBIC YARD	MECH	MECHANICAL	TRTD	TREATED					
D	DEPTH OR DEGREE OF CURVE	MFR	MANUFACTURER	TS	TOP OF SLAB					
DEPT	DEPARTMENT	MH	MANHOLE, MOUNTING HEIGHT	TV	TELEVISION					
DF	DRINKING FOUNTAIN	MIN	MINIMUM	TW	TOP OF WALL					
DI	DROP INLET, DUCTILE IRON	MISC	MISCELLANEOUS	TYP	TYPICAL					
DIA	DIAMETER	MJ	MECHANICAL JOINT	UG	UNDERGROUND					
DIM	DIMENSION	MO	MASONRY OPENING	UON	UNLESS OTHERWISE NOTED					
DISC	DISCONNECT	MON	MONUMENT	USGS	UNITED STATES COAST AND GEODETIC SURVEY					
DMH	DROP MANHOLE	MTD	MOUNTED		UNITED STATES GEOLOGICAL SURVEY					
DN	DOWN	MTG	MOUNTING							
DR	DRIVE	MTL	METAL							
DS	DOWN SPOUT	MV	MUD VALVE							
DTL	DETAIL	N & C	NAIL AND CAP							
DW,D/W	DRIVEWAY	NIC	NOT IN CONTRACT							
DWL	DWELLING	NO	NUMBER							
DWG	DRAWING	NTS	NOT TO SCALE							
E	EAST	OC	ON CENTERS							
EA	EACH	OD	OUTSIDE DIAMETER							
E.B.L.	EASTBOUND LANE	OPER	OPERATOR							
EF	EACH FACE	OPNG	OPENING							
EJ	EXPANSION JOINT	OPP	OPPOSITE							
EL, ELEV	ELEVATION	PC	POINT OF CURVE							
ELEC	ELECTRICAL	PCC	POINT OF COMPOUND							
ENGR	ENGINEER	PER	PERIMETER							
ENTR	ENTRANCE	PERF	PERFORATED							
EOL	END OF LINE	PERP	PERPENDICULAR							
EP	EDGE OF PAVEMENT	PI	POINT OF INTERSECTION							
EQ	EQUAL	PIV	POST INDICATOR VALVE							
EQPT	EQUIPMENT	PL	PLATE, PROPERTY LINE							

 Mattern & Craig CONSULTING ENGINEERS - SURVEYORS	DESIGNED:	TAM		REV.	DATE	DESCRIPTION	BY	APP.	DATE	PETERS CREEK SANITARY SEWER REPLACEMENT PROJECT PC-4 GENERAL ABBREVIATIONS & LEGEND CITY OF ROANOKE, VIRGINIA	SHEET 3
	DRAWN:	ASB		△	10/98	RECORD DRAWINGS	JMC	SWH	JANUARY 1995		
	CHECKED:	SWH							COMM. NO. 1245C		