
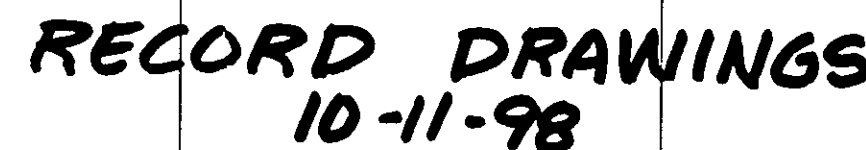


NOTES:

1. WORK SHALL NOT BEGIN ON THIS SECTION OF SEWERLINE UNTIL WORK IS COMPLETED BY VDOT CONTRACTOR.
2. WORK IN THIS AREA SHALL BE CONSTRUCTED CONCURRENTLY WITH VDOT SEWERLINE CONSTRUCTION AS TO MAINTAIN SEWER SERVICE TO THE UPSTREAM AREAS.
3. SEWER SHALL BE ABANDONED IN A SEQUENCE SUCH THAT NO AREA OR INDIVIDUAL WILL BE WITHOUT SEWER SERVICE.
4. SEWER IN THIS AREA SHALL NOT BE ABANDONED UNTIL ALL CONNECTIONS TO THE NEW SEWERLINE HAVE BEEN COMPLETED.

E.F. NICHOLS
1120 PETERS CREEK RD. N.W.
TAX NO. 6100629

VDOT CONTRACTOR (SEE SPECIAL INSTRUCTIONS)

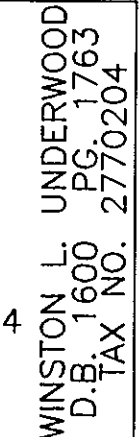

PROJECT NO. 6245C