

REVISED	FHWA REGION	STATE	FEDERAL AID PROJECT	ROUTE	STATE PROJECT	SHEET NO.
	3	VA.		117	0117-128-101, RW-201 C-501	20(4)


UTILITY OWNERS:

Power Poles and Underground Electrical Cables Property Of
Appalachian Power Company
P.O. Box 2021
Roanoke, Va. 24022

Telephone Poles and Underground Cables Property Of
Chesapeake and Potomac Telephone Company
5123 Oakland Blvd.
Roanoke, Va. 24102

Gas Lines Property Of
Roanoke Gas Company
601 Kimball Avenue
Roanoke, Va. 24030

Sanitary Sewer and Water Lines Property Of
City Of Roanoke
215 Church Avenue
Roanoke, Va. 24011

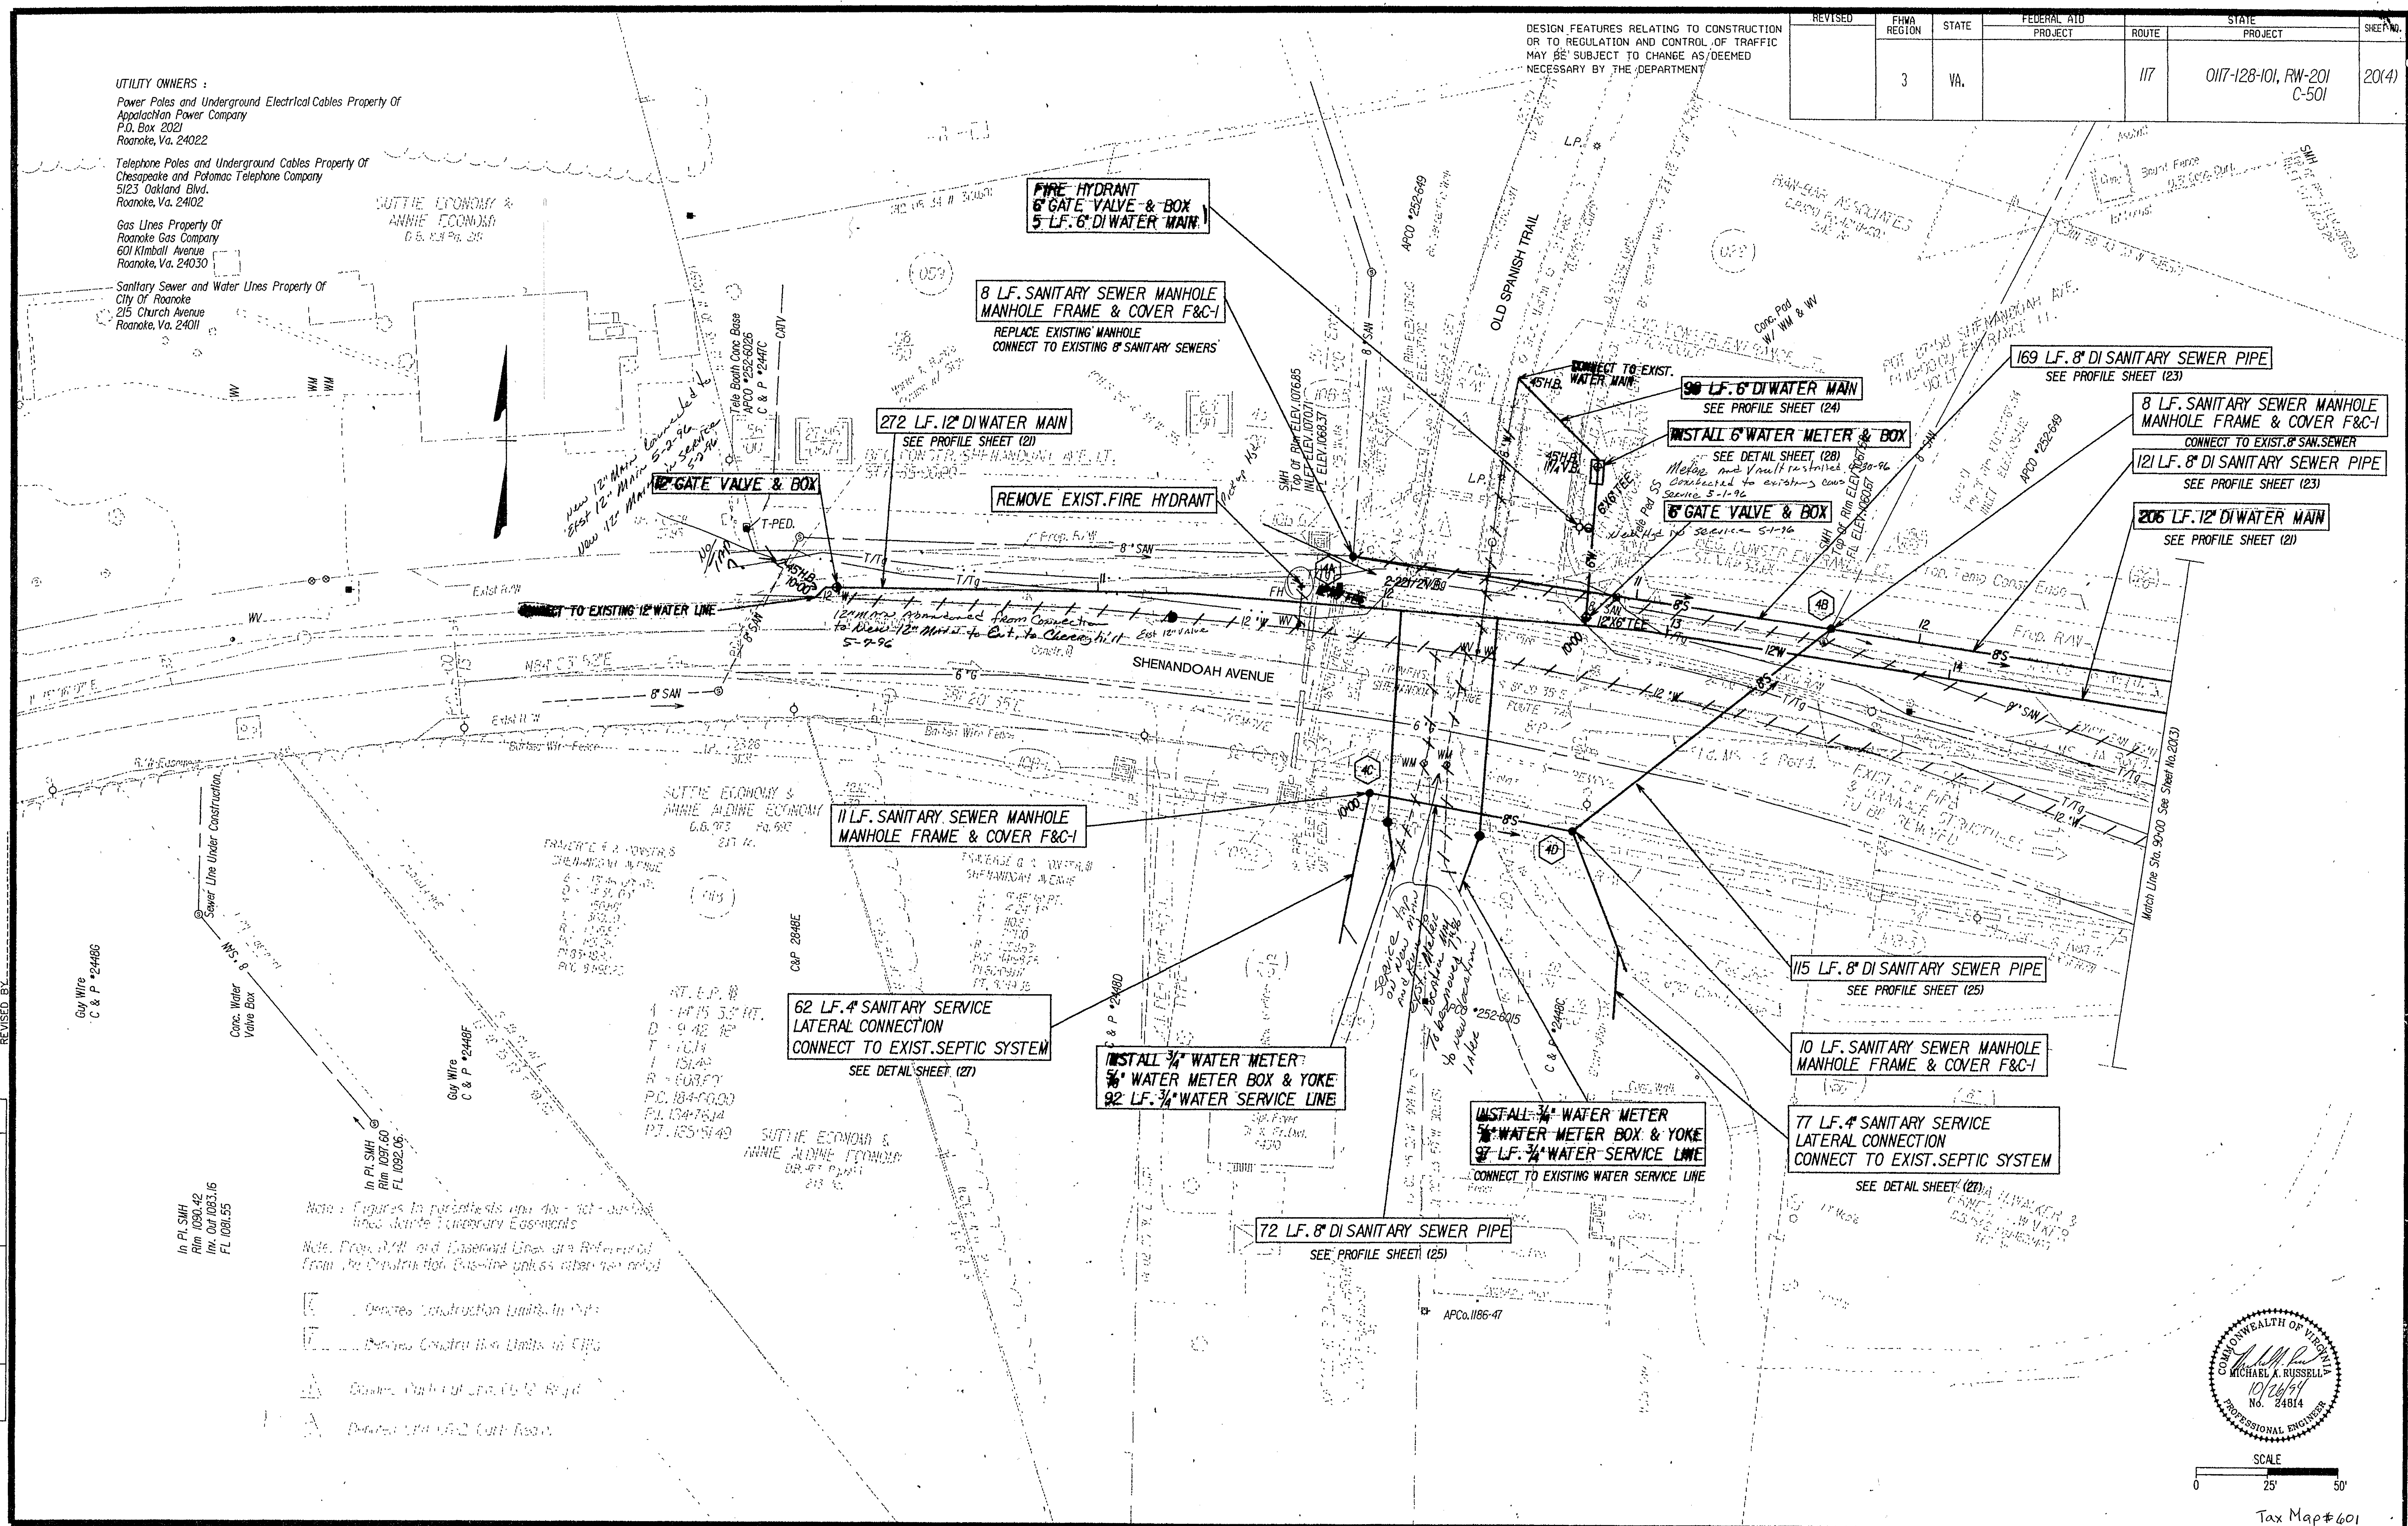

SUPERVISED BY: J. STONE
DESIGNED BY: M. RUSSELL
CADD OPERATOR: C. KAMUS
REVISED BY:

PLAN	DATE
NO. _____	
NOTE BOOK	
PAID TO _____	
PAID BY _____	
PAID FOR _____	
