

UTILITY OWNERS :

Power Poles and Underground Electrical Cables Property Of
Appalachian Power Company
P.O. Box 2021
Roanoke, Va. 24022

Telephone Poles and Underground Cables Property Of
Chesapeake and Potomac Telephone Company
5123 Oakland Blvd.
Roanoke, Va. 24102

Gas Lines Property Of
Roanoke Gas Company
601 Kimball Avenue
Roanoke, Va. 24030

Sanitary Sewer and Water Lines Property Of
City of Roanoke
215 Church Avenue
Roanoke, Va. 24011

DESIGN FEATURES RELATING TO CONSTRUCTION
OR TO REGULATION AND CONTROL OF TRAFFIC
MAY BE SUBJECT TO CHANGE AS DEEMED
NECESSARY BY THE DEPARTMENT

REVISED	FHWA REGION	STATE	FEDERAL AID PROJECT	ROUTE	STATE PROJECT	SHEET NO.
	3	VA.		117	0117-128-101, RW-201 C-501	20(7)









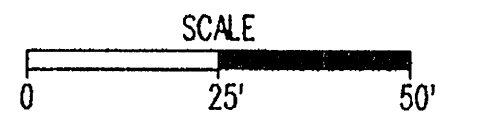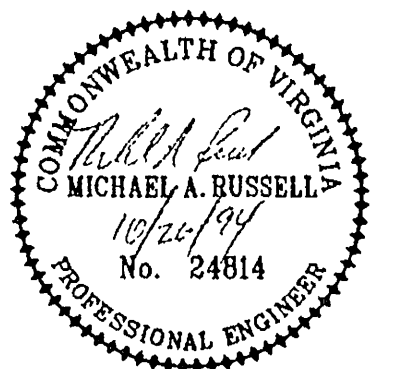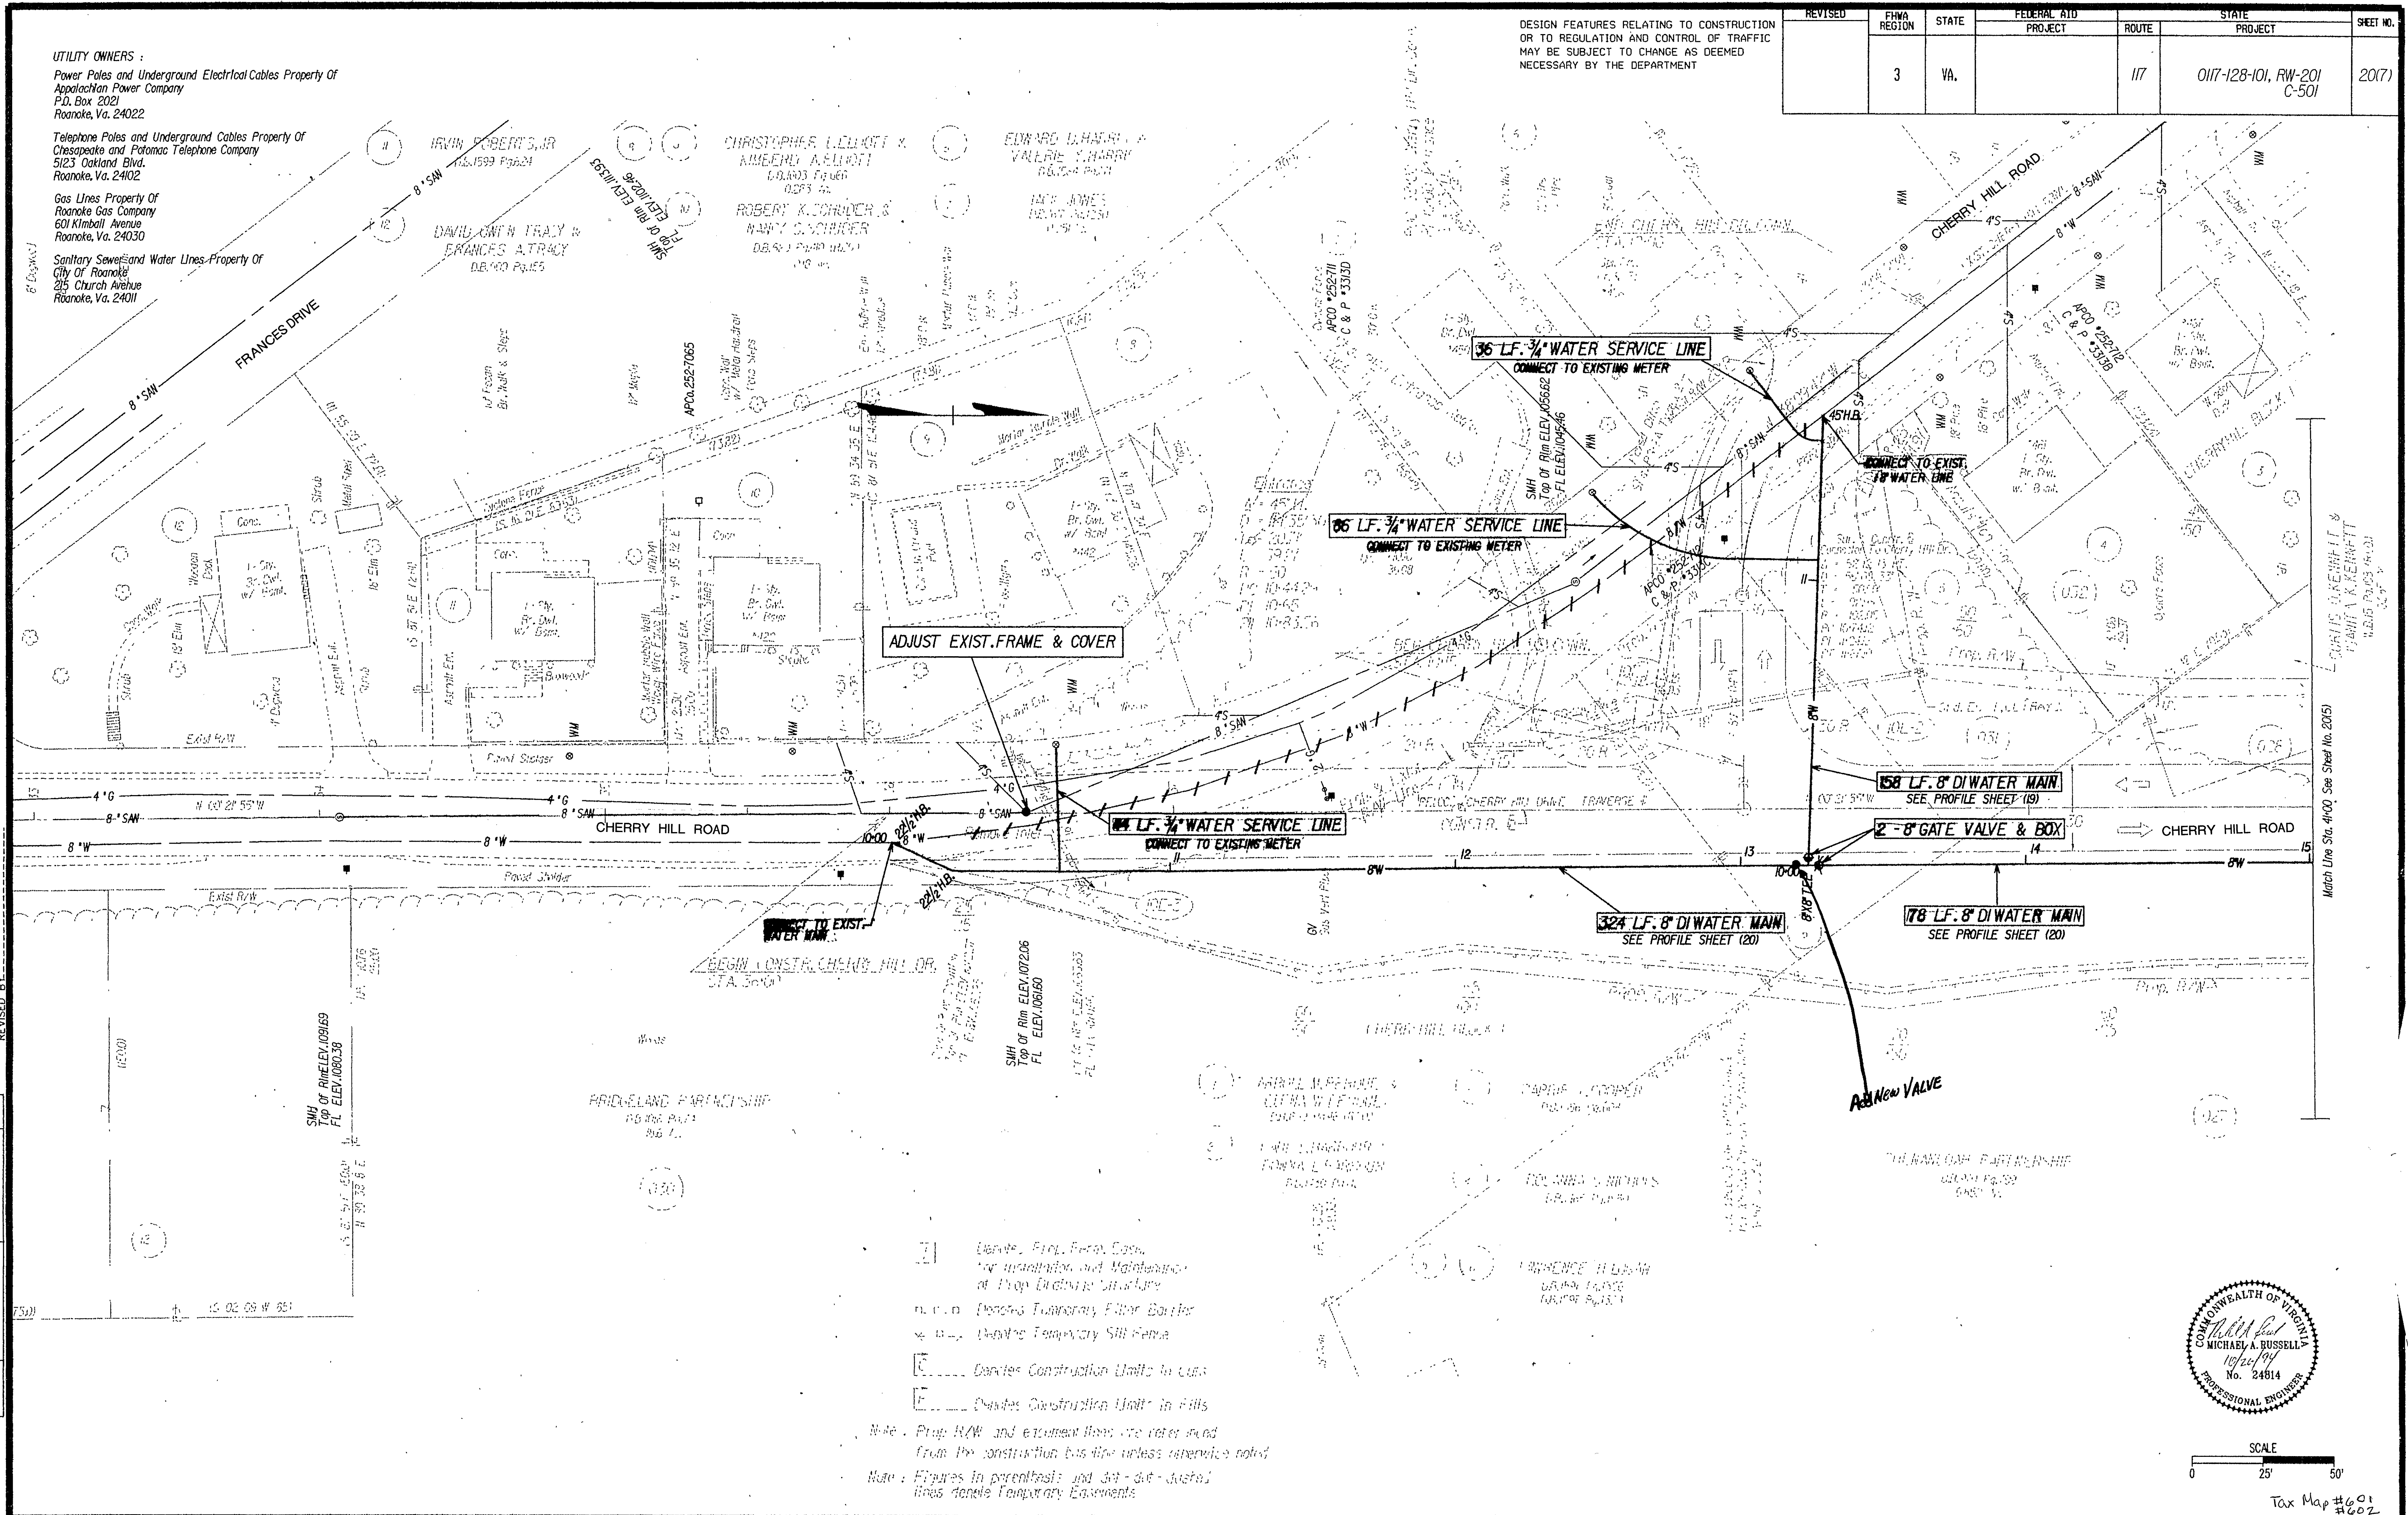

Tax Map #602
#602