THIS SHEET FOR UTILITY RELOCATION/ADJUSTMENT ONLY

REVISED	FHWA REGION	STATE	FEDERAL AID PROJECT	STATE ROUTE	STATE PROJECT	SHEET NO.
	3	VA.		117	0117-128-101, RW-201 C-501	20(10)

DESIGN FEATURES RELATING TO CONSTRUCTION OR TO REGULATION AND CONTROL OF TRAFFIC MAY BE SUBJECT TO CHANGE AS DEEMED NECESSARY BY THE DEPARTMENT

UTILITY OWNERS :

Power Poles and Underground Electrical Cables Property Of
Appalachian Power Company
P.O. Box 2021
Roanoke, Va. 24022

Telephone Poles and Underground Cables Property Of
Chesapeake and Potomac Telephone Company
5123 Oakland Blvd.
Roanoke, Va. 24102

Gas Lines Property Of
Roanoke Gas Company
601 Kimball Avenue
Roanoke, Va. 24030

Sanitary Sewer and Water Lines Property Of
City Of Roanoke
215 Church Avenue
Roanoke, Va. 24011

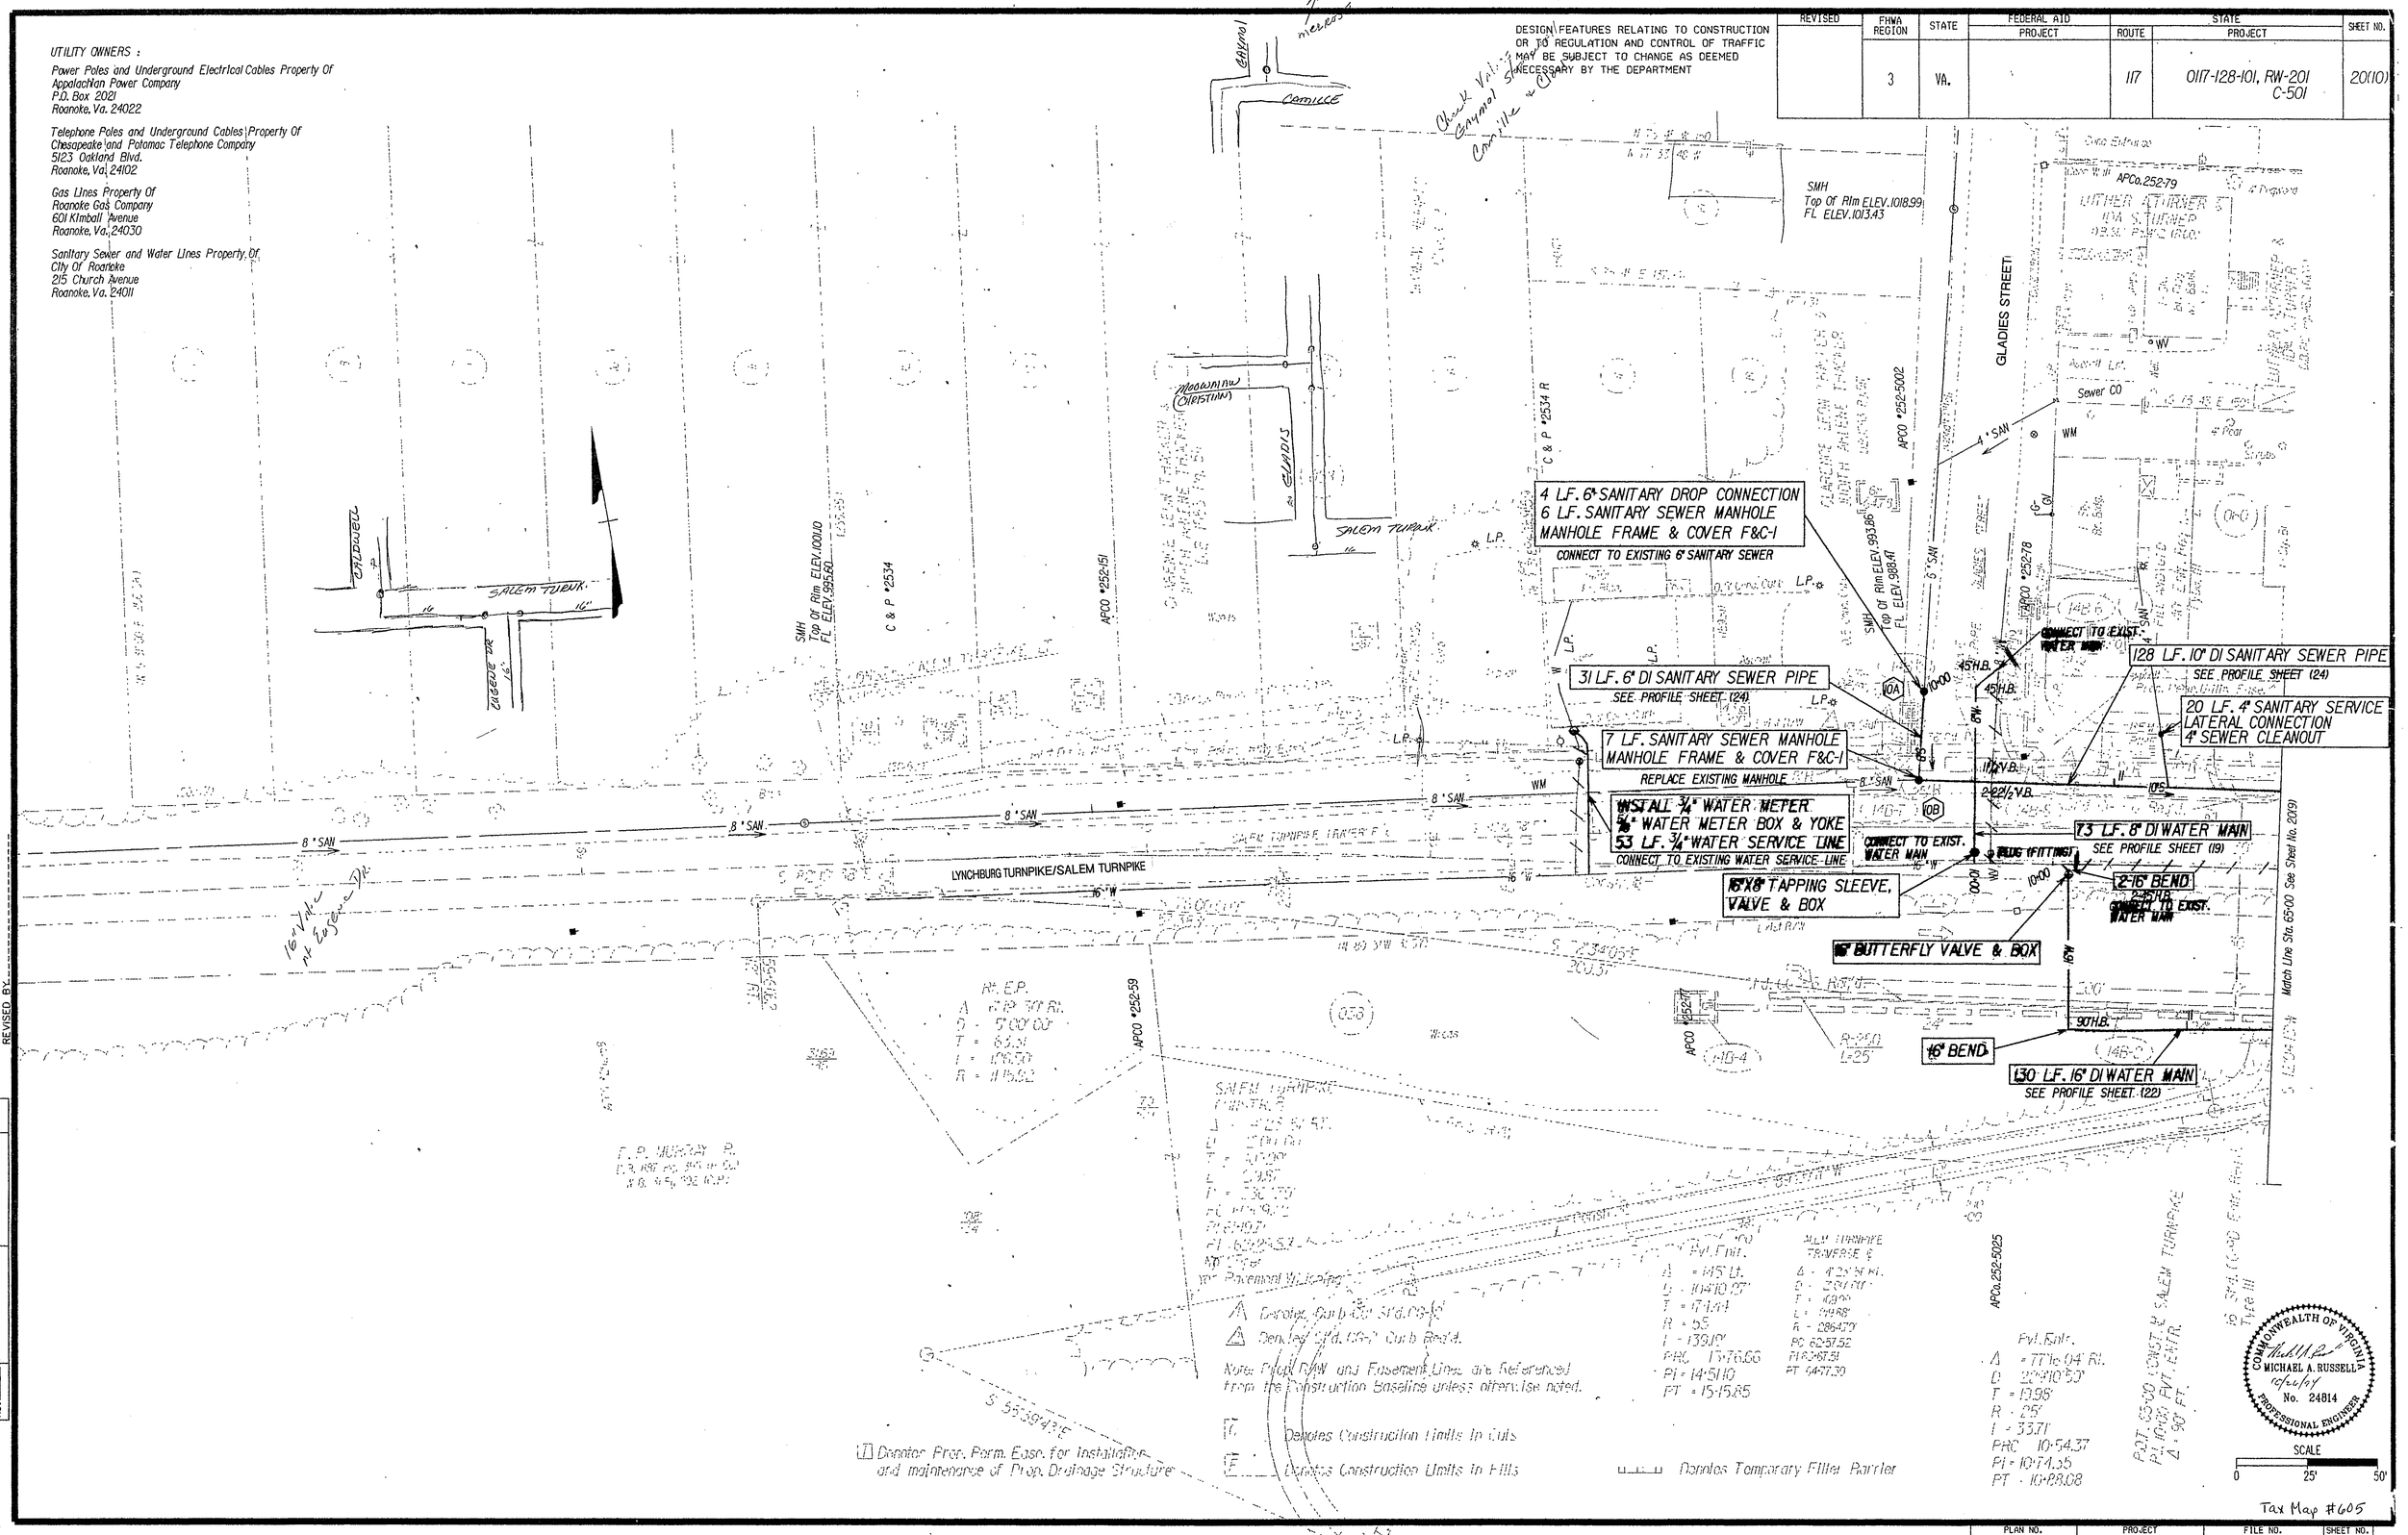

Denotes Proposed Permanent Easement for Installation and maintenance of Prop. Drainage Structure

Denotes Construction Limits In Cuts

Denotes Construction Limits In Fills

Denotes Temporary Filter Barrier

Note: Proposed R/W and Easement Lines are Referenced from the Construction Baseline unless otherwise noted.

SUPERVISED BY T. STONE
DESIGNED BY M.A. RUSSELL
CADD OPERATOR G.B. KANNIS
REVISED BY

PLAN	SURVEYED	BY	DATE
NOTE BOOK	PLOTTED		
	ALIGNMENT CHECKED		
NO.	RIGHT OF WAY CHECKED		

26 OCT 94

COMMONWEALTH OF VIRGINIA
MICHAEL A. RUSSELL
10/26/94
No. 24814
PROFESSIONAL ENGINEER

SCALE 0 25' 50'

PLAN NO.	PROJECT	FILE NO.	SHEET NO.
A	0117-128-101		20(10)

10127-10/100% SUBMITTAL