


UTILITY OWNERS:
Power Poles and Underground Electric Cables Property Of
Appalachian Power Company
P.O. Box 2021
Roanoke, Va. 24002
Telephone Poles and Underground Cables Property Of
Chesapeake and Potomac Telephone Company
5123 Oakland Blvd.
Roanoke, Va. 24002
Gas Lines Property Of
Roanoke Gas Company
601 Kimball Avenue
Roanoke, Va. 24030
Sanitary Sewer and Water Lines Property Of
City of Roanoke
215 Church Avenue
Roanoke, Va. 24001

DESIGN FEATURES RELATING TO CONSTRUCTION
OR TO REGULATION AND CONTROL OF TRAFFIC
MAY BE SUBJECT TO CHANGE AS DEEMED
NECESSARY BY THE DEPARTMENT

REVISED	FMA REGION	STATE	FEDERAL AID PROJECT	ROUTE	STATE PROJECT	SHEET NO.
	3	VA		117	0117-128-F01, RW-201 0117-128-101-C-502 B-602	20(30)

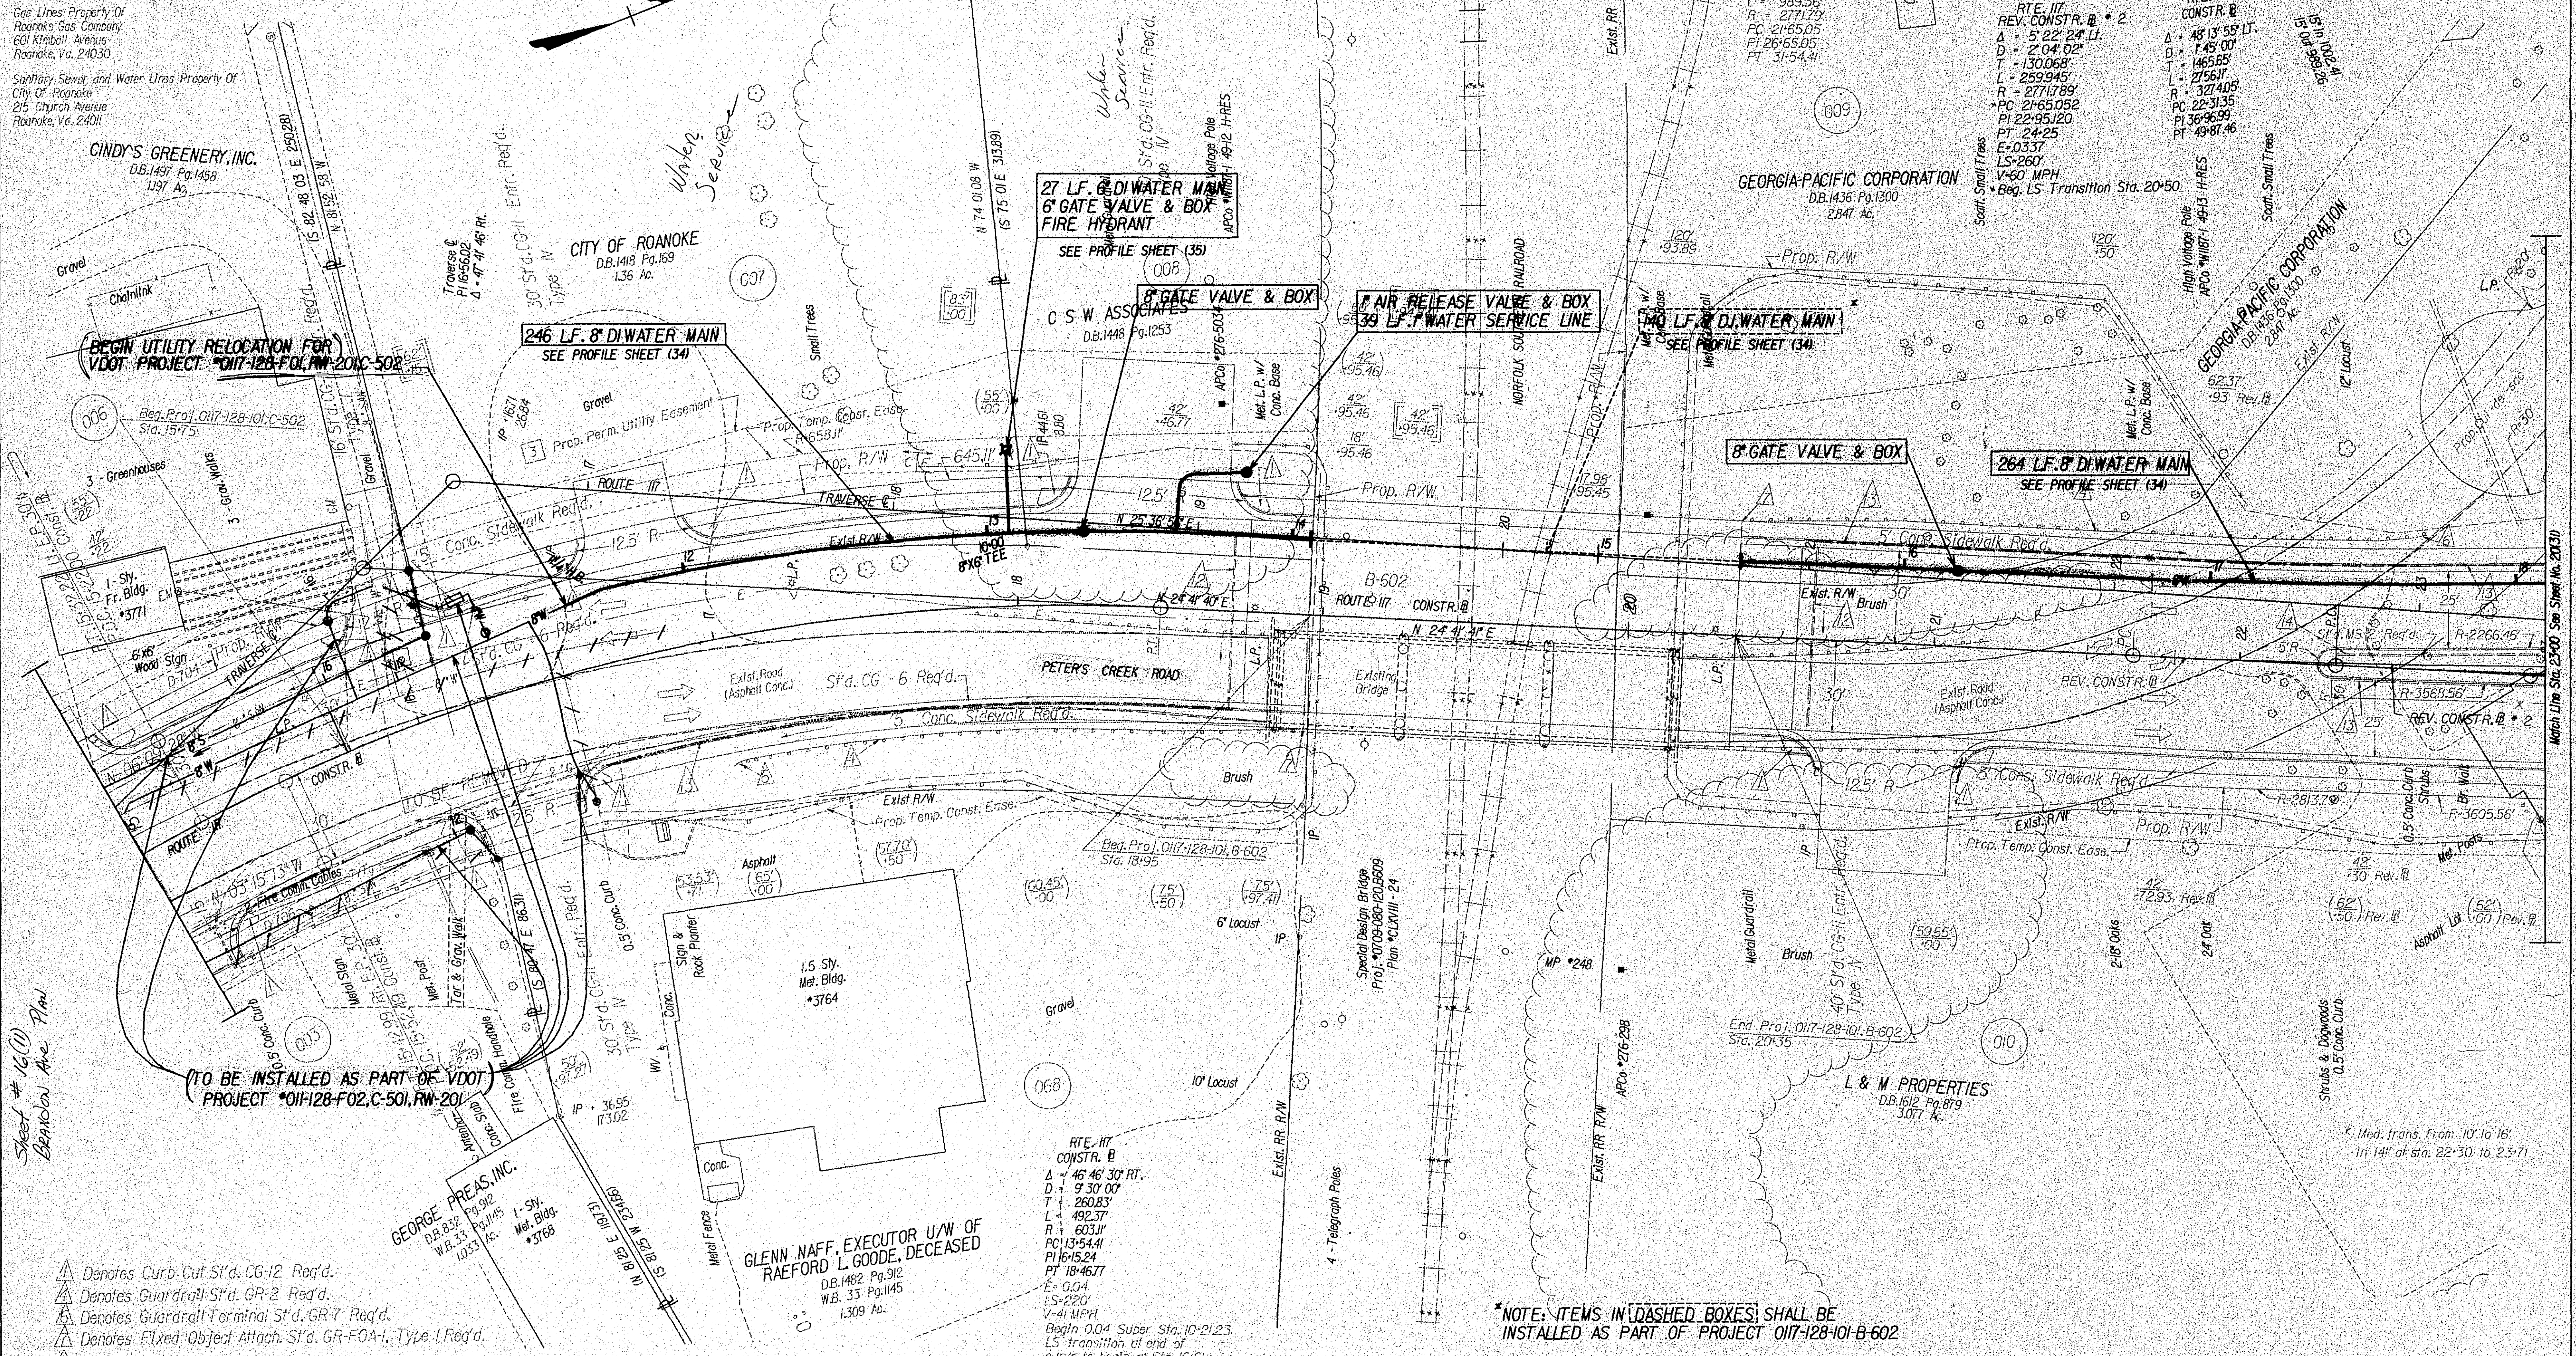

- Denotes Curb Cut S'd. CG-12 Reg'd.
- Denotes Guardrail S'd. GR-2 Reg'd.
- Denotes Guardrail Terminal S'd. GR-7 Reg'd.
- Denotes Fixed Object Attach. S'd. GR-FOA-1, Type I Reg'd.
- Denotes Underdrain S'd. CD-2 Reg'd.
- Denotes Underdrain S'd. UD-4 Reg'd.
- Denotes Underdrain S'd. UD-2 Reg'd.

Hatched Areas Denote Areas
of Demolition of Pavement

Denotes Construction Units in Cuts
Denotes Construction Units in Fills

Denotes Temporary Filter Barrier
Denotes Temporary Silt Fence

*NOTE: ITEMS IN DASHED BOXES SHALL BE
INSTALLED AS PART OF PROJECT 0117-128-101-B-602

Note: Figures in parentheses and dot-dot-dashed
lines denote Temporary Easements.
Note: Prop. R/W and Easement Lines are Referenced
from the Construction Baseline unless otherwise noted.

