SHEET	SCHEDULE OF DRAWINGS TITLE	STATION
1	OVERALL LAYOUT OF WEST FORK OF PETERS CREEK INTERCEPTOR	0+07.57S. - 13+30.95
2	WEST FORK OF PETERS CREEK INTERCEPTOR	13+30.95 - 27+21.87
3	WEST FORK OF PETERS CREEK INTERCEPTOR	27+21.87 - 42+80.90
4		
5		

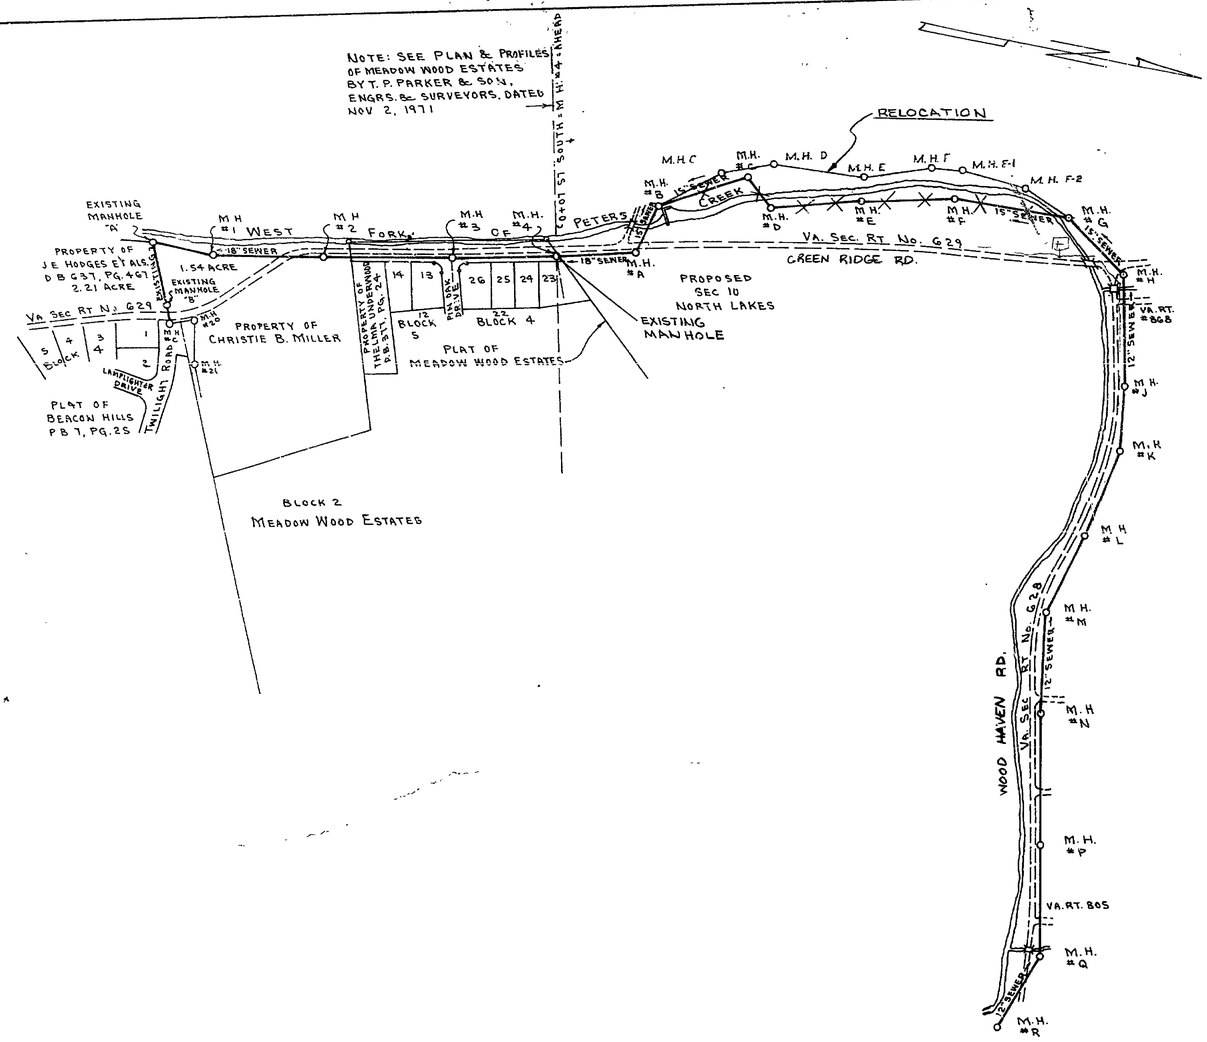

REFERENCES:
1. ROANOKE COUNTY PUBLIC SERVICE AUTHORITY RULES AND REGULATIONS AND CONSTRUCTION SPECIFICATIONS AND STANDARDS.
2. SPECIFICATIONS - SANITARY SEWERAGE SYSTEM - WEST FORK PETERS CREEK INTERCEPTOR FOR ROANOKE COUNTY PUBLIC SERVICE AUTHORITY BY: T. P PARKER & SON ENGINEERS & SURVEYORS, SALEM, VA. DATED 2-23-72. REVISED BY ROANOKE COUNTY ( ) 4-02-90

SUMMARY OF QUANTITIES

ITEM	DESCRIPTION	QUANTITY	UNIT
1	18" SANITARY SEWER PIPE	235	L.F.
2	15" SANITARY SEWER PIPE	1563	L.F.
3	12" SANITARY SEWER PIPE	2328	L.F.
4	STANDARD MANHOLES, TYPE "A"	~~16~~ 18	EACH
~~5~~	~~15" CAST IRON PIPE~~	~~128~~	~~L.F.~~
~~6~~	~~12" CAST IRON PIPE~~	~~36~~	~~L.F.~~
~~7~~	~~36" O.D. x 1/4" THICK STEEL CASING PIPE~~	~~75~~	~~L.F.~~
~~8~~	~~24" x 1/4" THICK STEEL CASING PIPE~~	~~79~~	~~L.F.~~

NOTES:
1. ALL SEWER LINES SHOWN ON PLANS ARE PROPOSED.
2. ALL MANHOLES SHOWN HEREON ARE TYPE "A".

SANITARY SEWERAGE SYSTEM
WEST FORK OF PETERS CREEK INTERCEPTOR
MADE FOR
ROANOKE COUNTY PUBLIC SERVICE AUTHORITY
OVERALL LAYOUT

SCALE: AS NOTED FEB. 23, 1972
BY: T.P. PARKER & SON
ENGRS. & SURVEYORS