


|                                                       |      |
|-------------------------------------------------------|------|
| PLAN                                                  | DATE |
| BY                                                    |      |
| NO.                                                   |      |
| NOTE: CENTERLINE OF SEWER IS CENTERLINE OF 20' P.U.E. |      |

|                                                       |      |
|-------------------------------------------------------|------|
| PROFILE                                               | DATE |
| BY                                                    |      |
| NO.                                                   |      |
| NOTE: CENTERLINE OF SEWER IS CENTERLINE OF 20' P.U.E. |      |

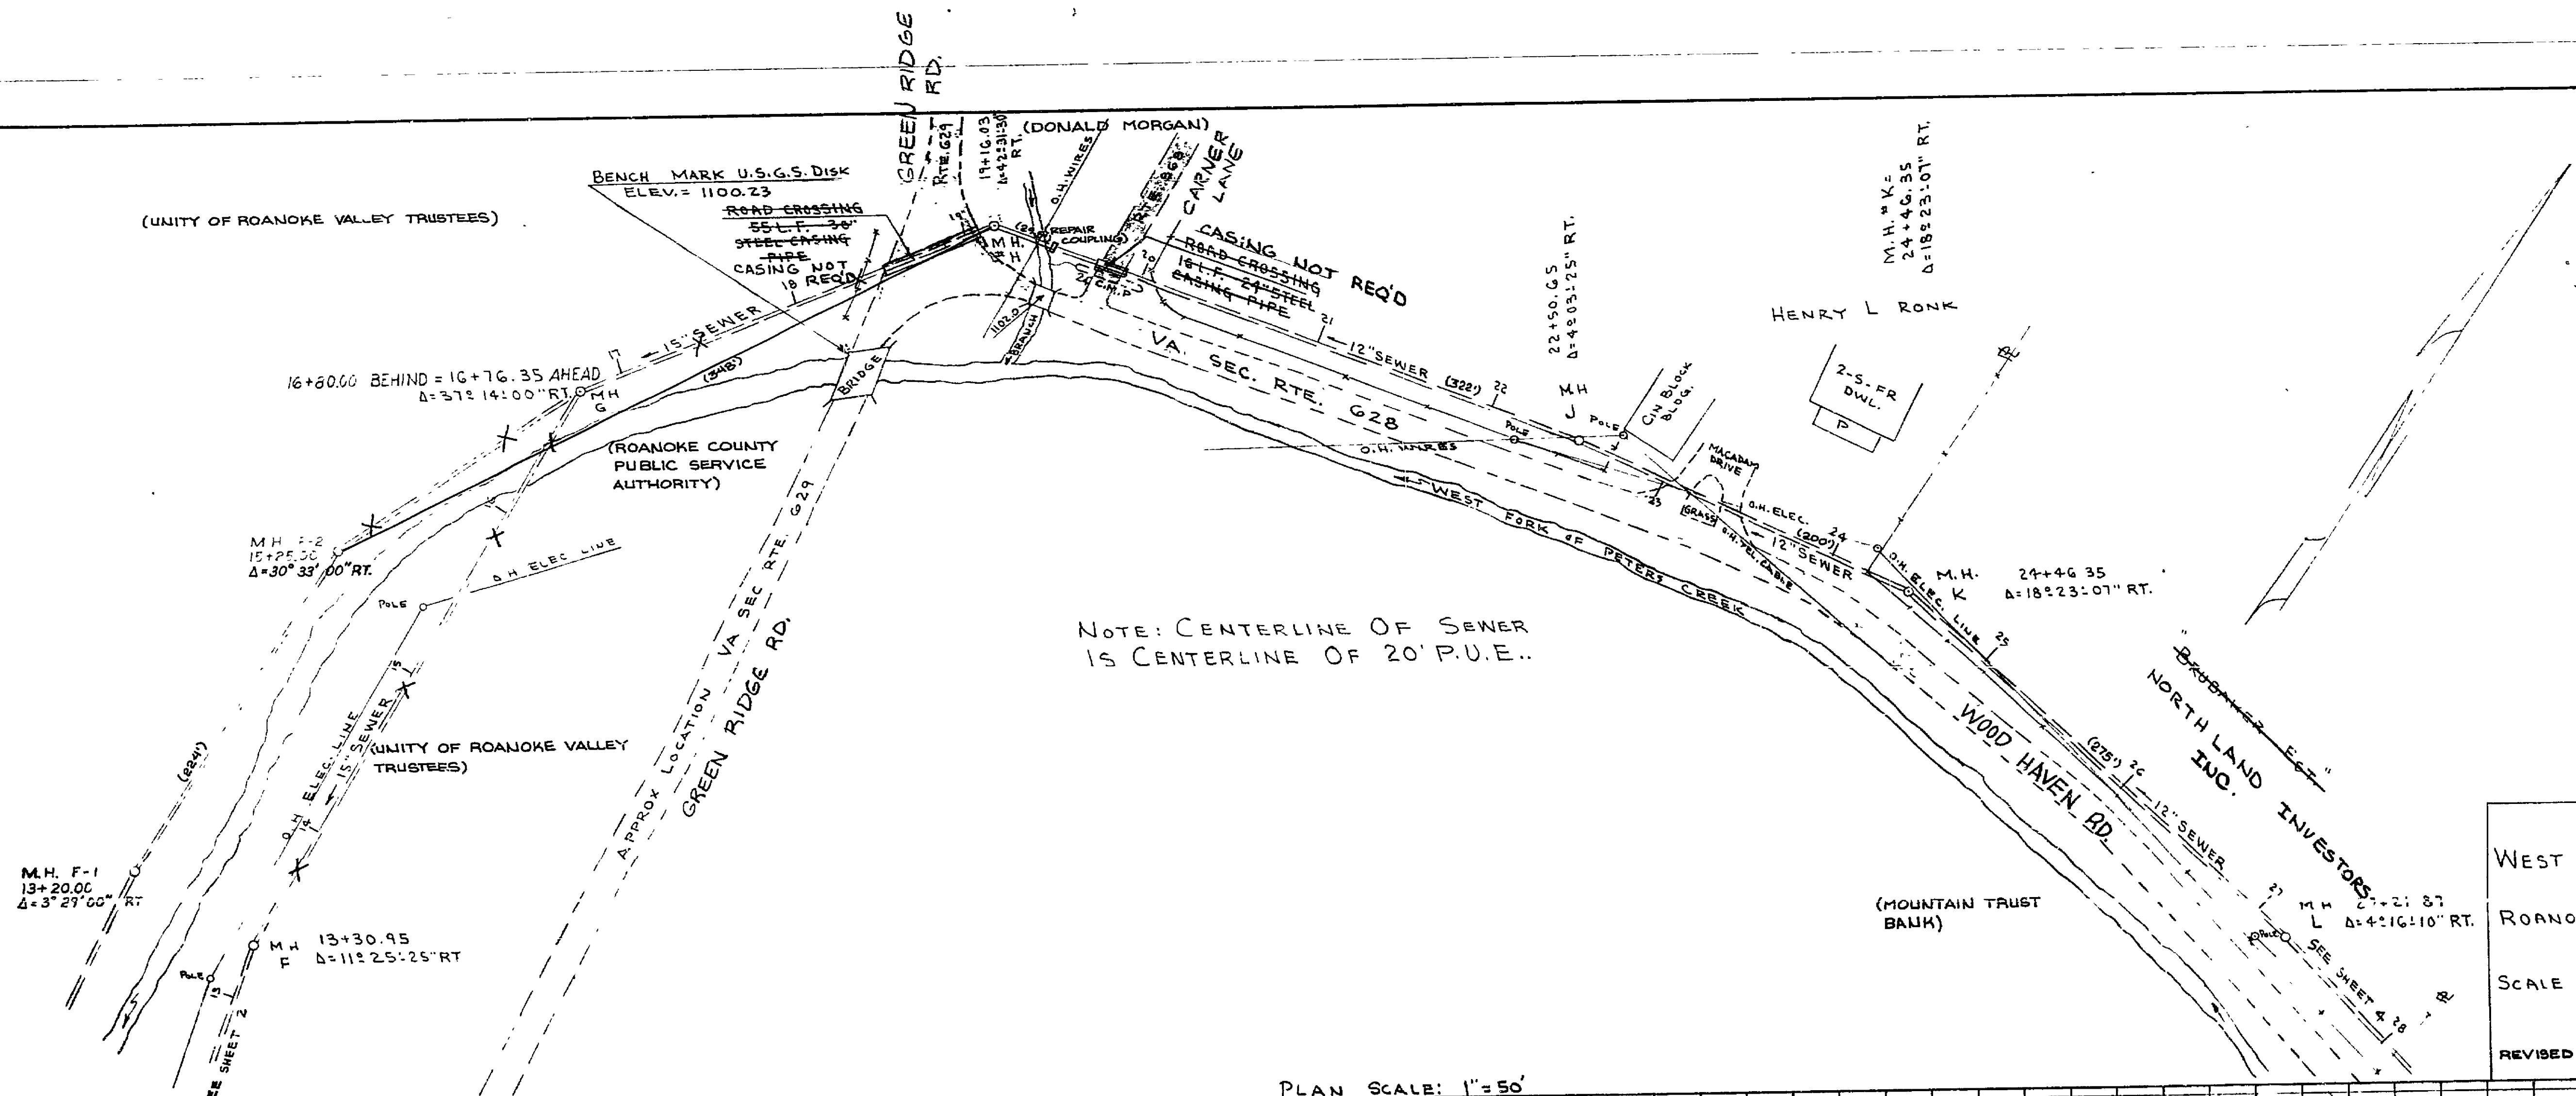

SANITARY SEWERAGE SYSTEM  
WEST FORK OF PETERS CREEK INTERCEPTOR  
MADE FOR  
ROANOKE COUNTY PUBLIC SERVICE AUTHORITY  
STA 13+30.95 - 27+21.87  
SCALE AS NOTED  
BY T. P. PARKER & SON  
ENGRS. & SURVEYORS  
REVISED BY ROANOKE COUNTY ( ) 4-08-90

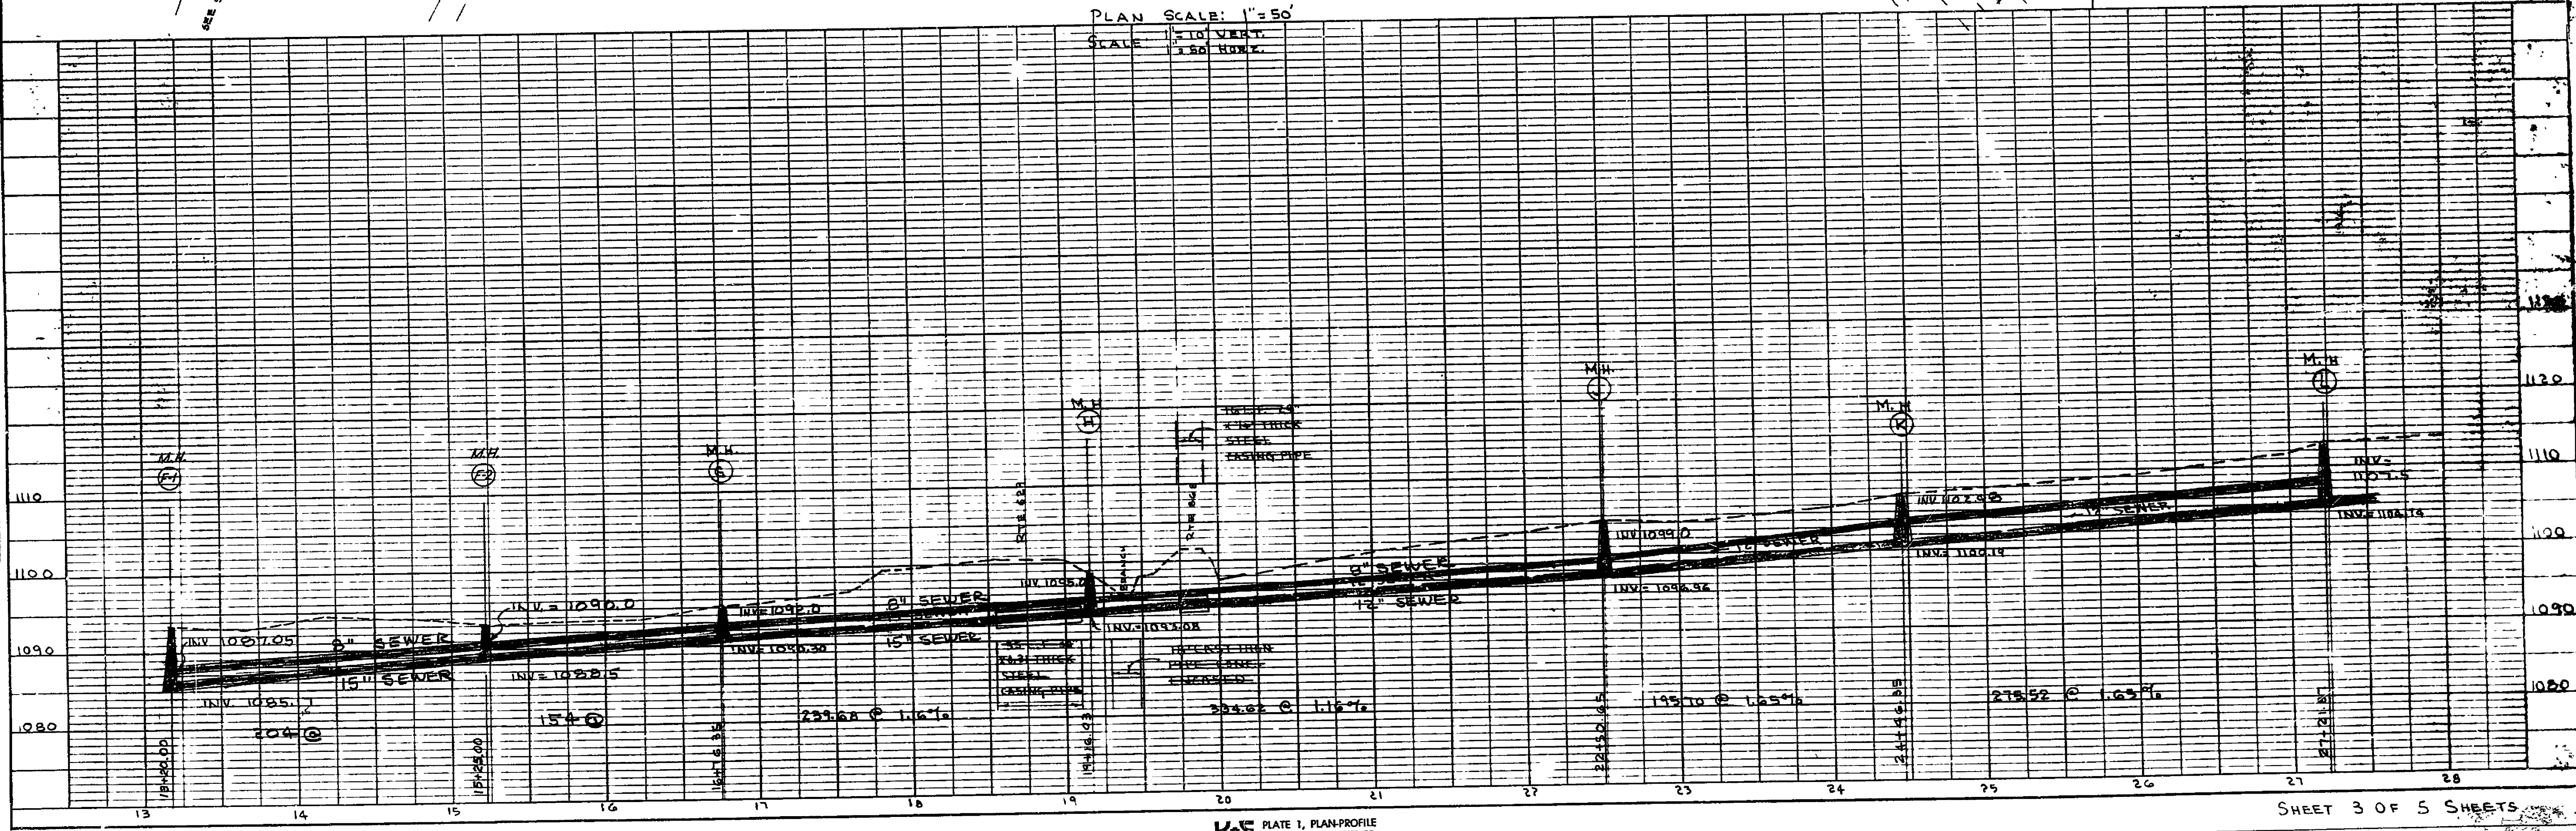


PLATE 1, PLAN-PROFILE  
K&E  
487004

