


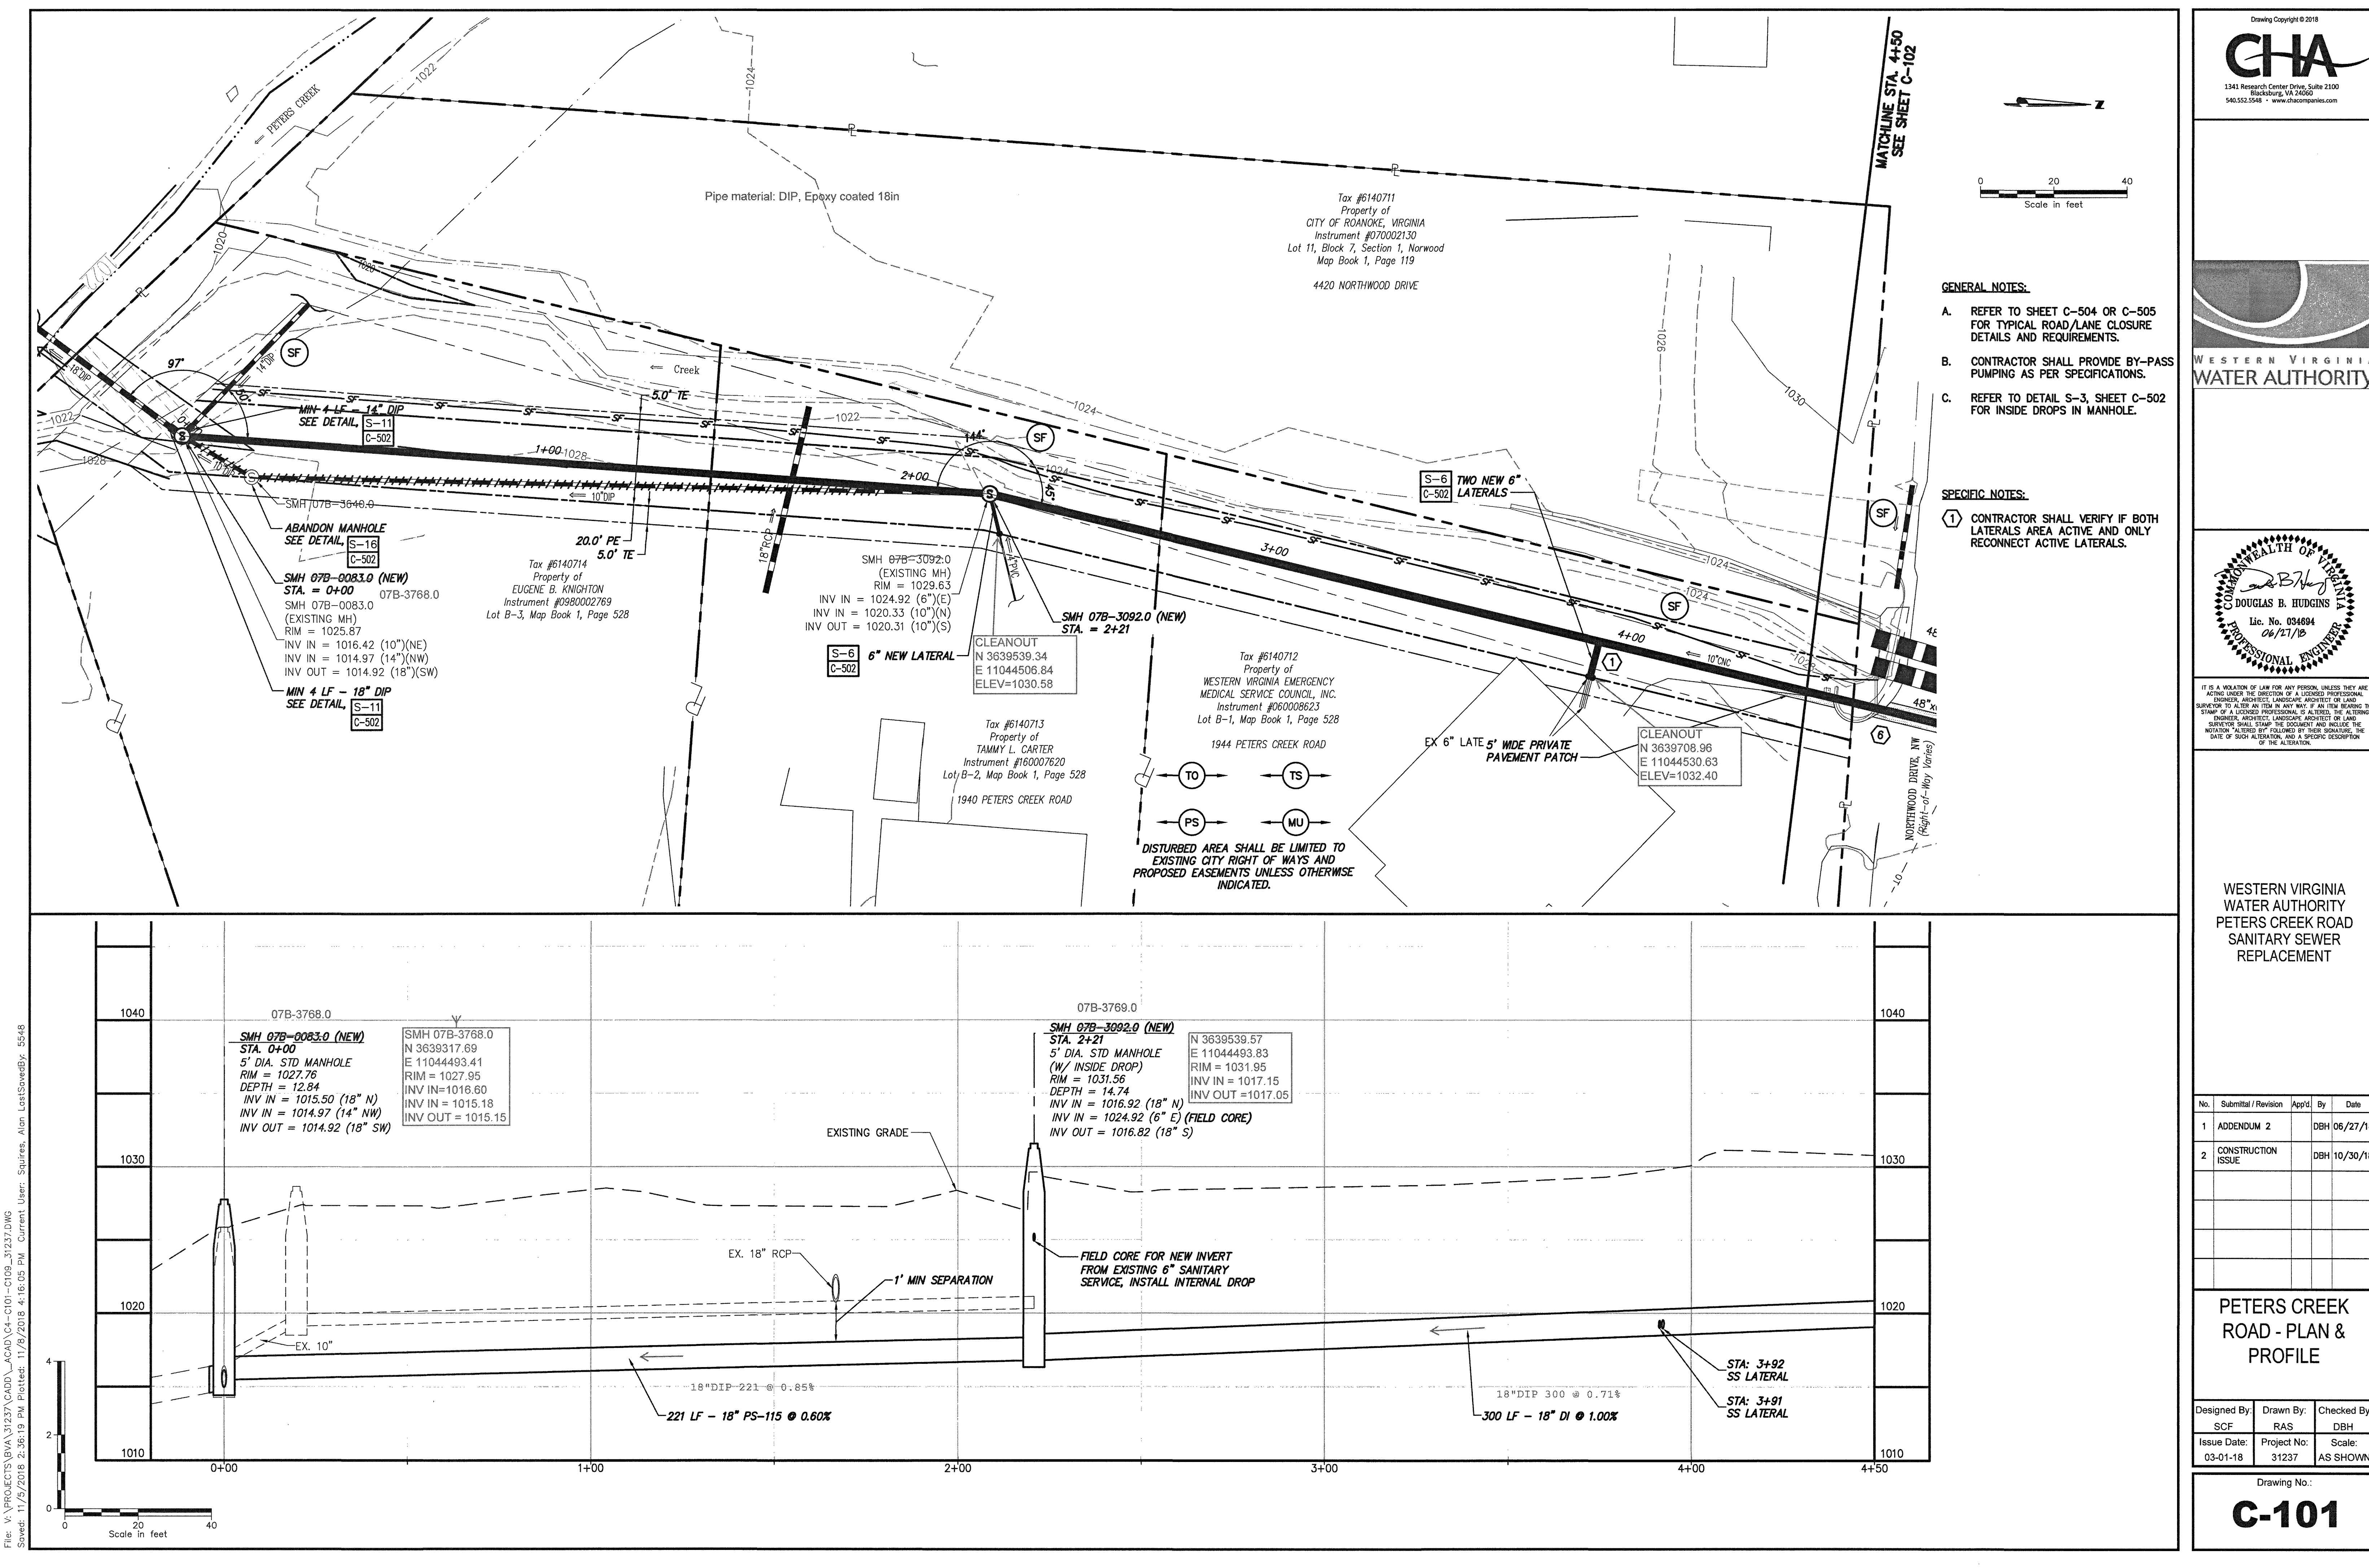


Drawing Copyright © 2018

CHA
1341 Research Center Drive, Suite 2100
Blacksburg, VA 24060
540.552.5548 • www.chacompanies.com

WESTERN VIRGINIA
WATER AUTHORITY

Douglas B. Hudgins
Professional Engineer
Lic. No. 034694
06/27/18

WESTERN VIRGINIA
WATER AUTHORITY
PETERS CREEK ROAD
SANITARY SEWER
REPLACEMENT

No.	Submittal / Revision	App'd. By	Date
1	ADDENDUM 2	DBH	06/27/18
2	CONSTRUCTION ISSUE	DBH	10/30/18

PETERS CREEK
ROAD - PLAN &
PROFILE

Designed By: SCF	Drawn By: RAS	Checked By: DBH
Issue Date: 03-01-18	Project No: 31237	Scale: AS SHOWN

Drawing No.:
C-101