



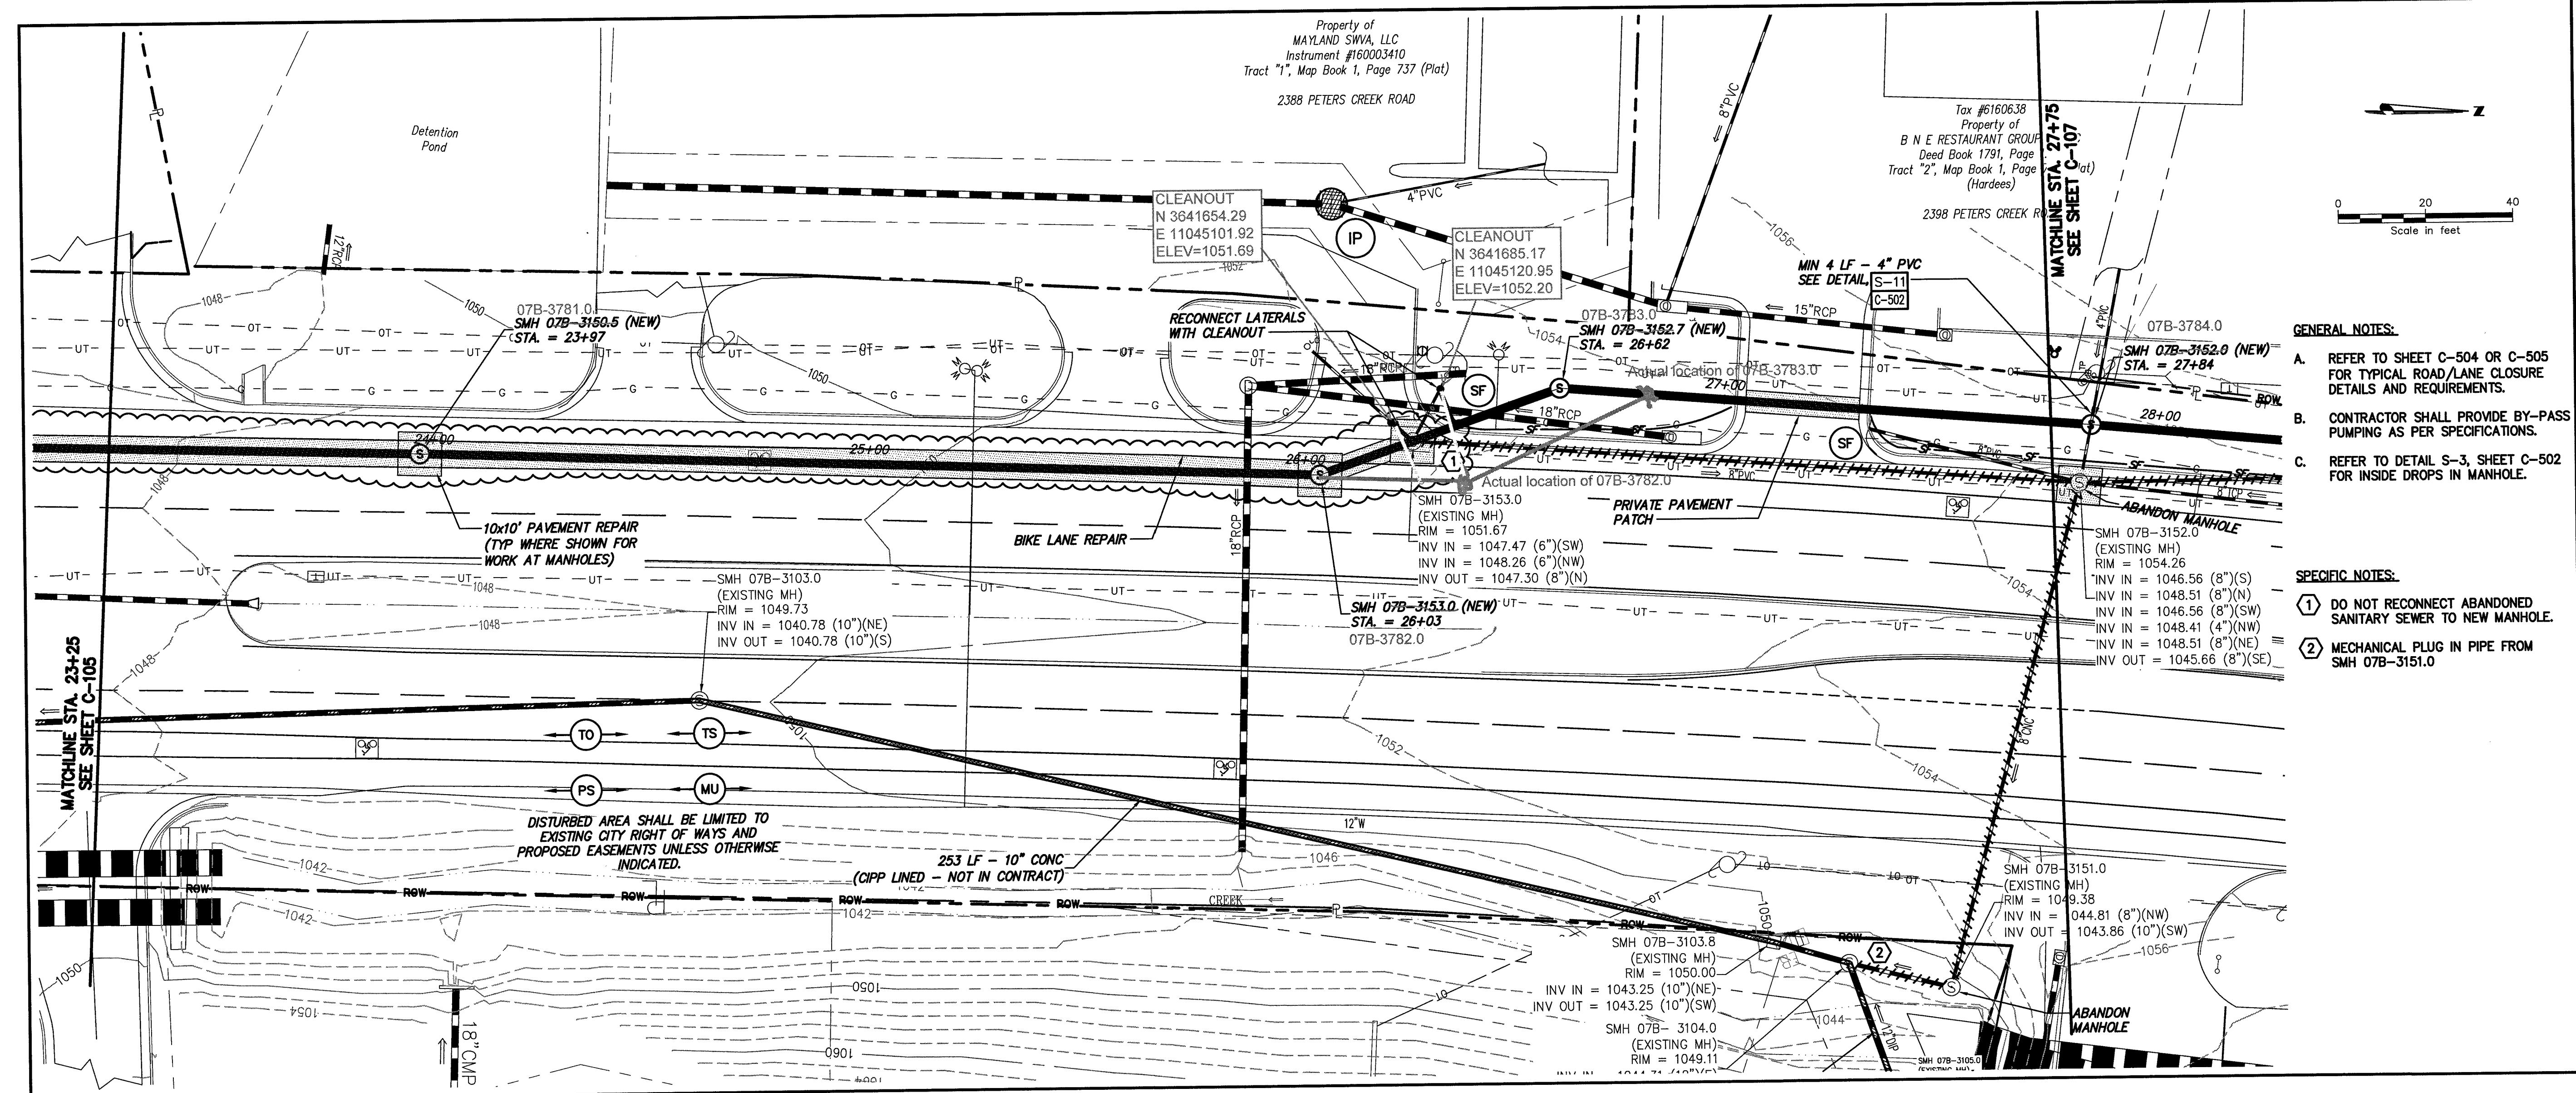

- GENERAL NOTES:**
- REFER TO SHEET C-504 OR C-505 FOR TYPICAL ROAD/LANE CLOSURE DETAILS AND REQUIREMENTS.
 - CONTRACTOR SHALL PROVIDE BY-PASS PUMPING AS PER SPECIFICATIONS.
 - REFER TO DETAIL S-3, SHEET C-502 FOR INSIDE DROPS IN MANHOLE.
- SPECIFIC NOTES:**
- DO NOT RECONNECT ABANDONED SANITARY SEWER TO NEW MANHOLE.
 - MECHANICAL PLUG IN PIPE FROM SMH 07B-3151.0

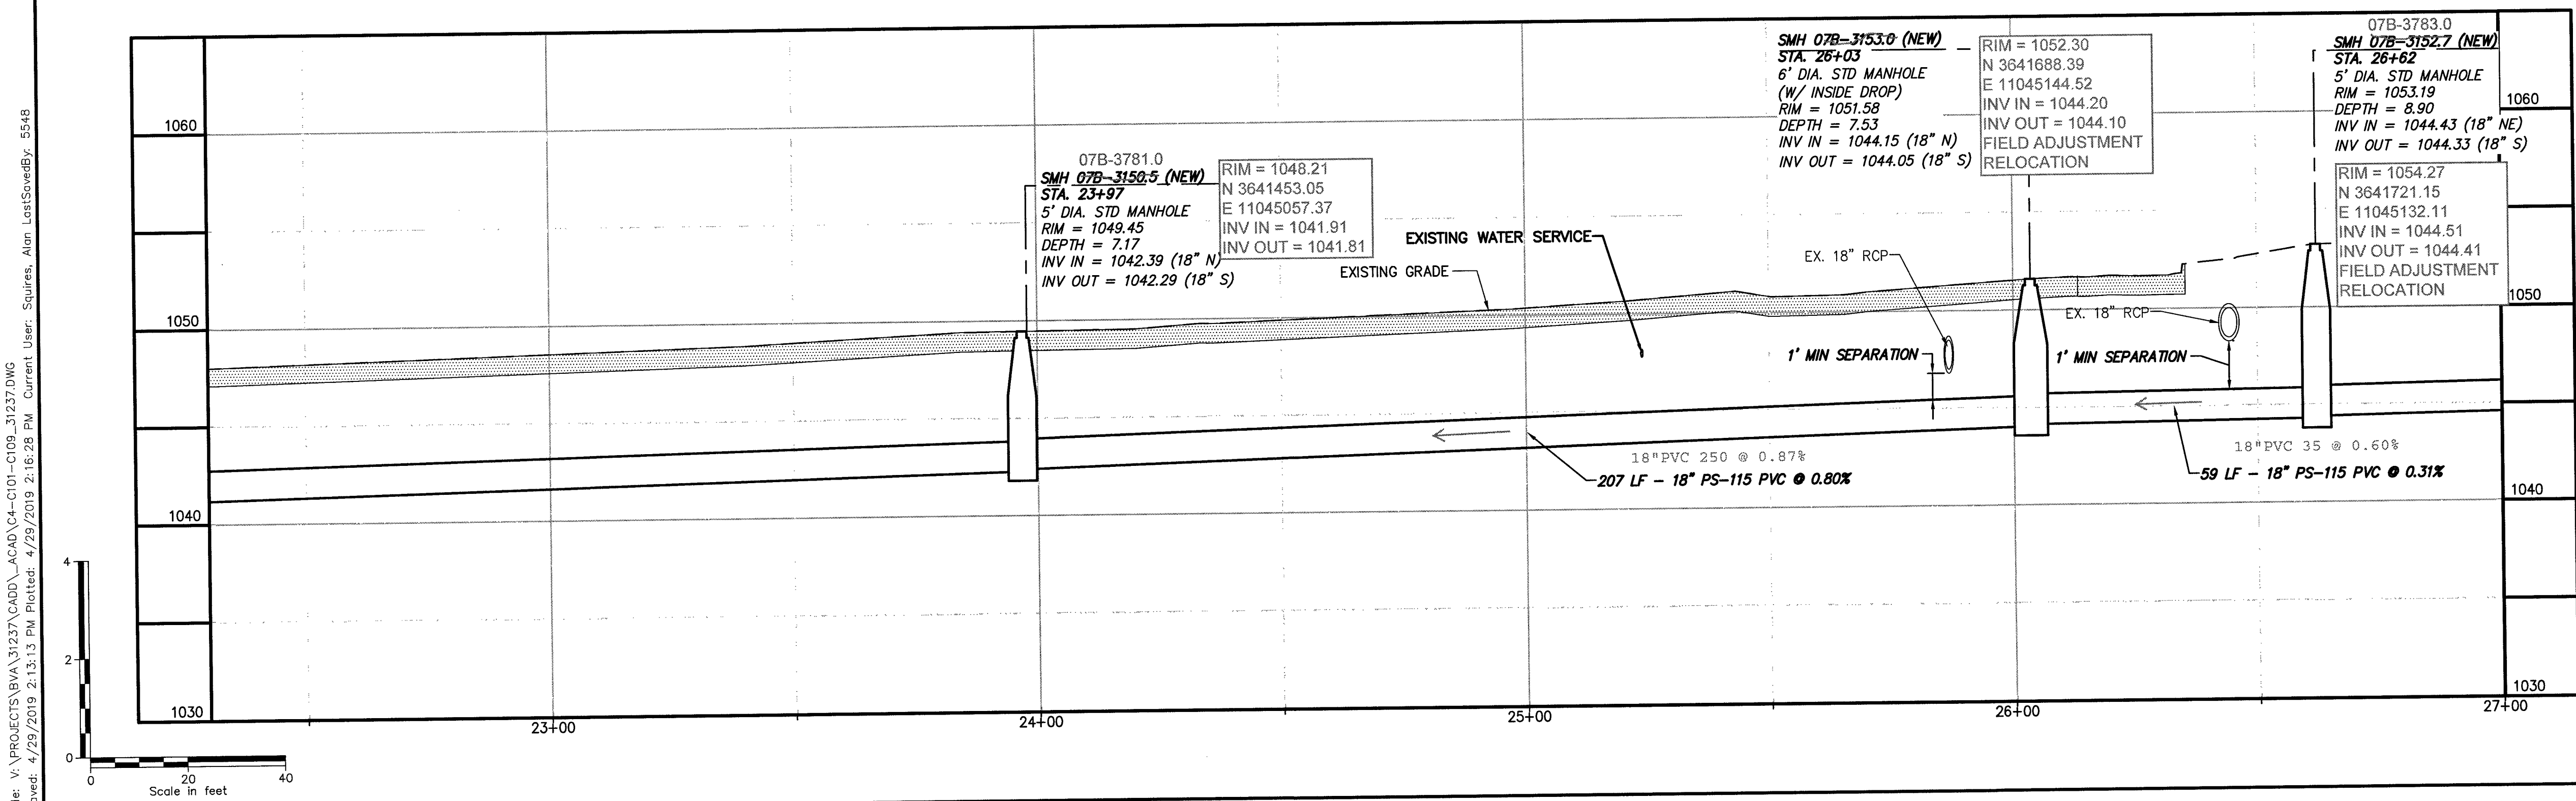


Drawing Copyright © 2018



1341 Research Center Drive, Suite 2100
Blacksburg, VA 24060
540.552.3548 • www.chacompanies.com



WESTERN VIRGINIA
WATER AUTHORITY

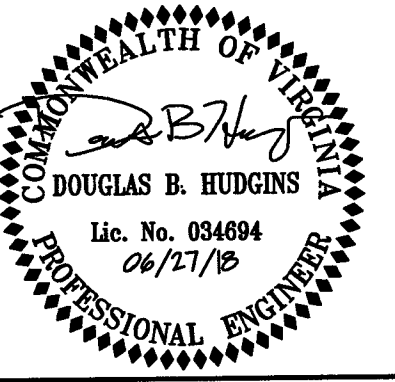

COMMONWEALTH OF VIRGINIA
DOUGLAS B. HUDGINS
Lic. No. 034684
06/27/18
PROFESSIONAL ENGINEER

IT IS A VIOLATION OF LAW FOR ANY PERSON, UNLESS THEY ARE ACTING UNDER THE DIRECTION OF A LICENSED PROFESSIONAL ENGINEER, ARCHITECT, LANDSCAPE ARCHITECT OR LAND SURVEYOR TO ALTER AN ITEM IN ANY WAY, IF AN ITEM BEARING THE STAMP OF A LICENSED PROFESSIONAL IS ALTERED. THE ALTERING ENGINEER, ARCHITECT, LANDSCAPE ARCHITECT OR LAND SURVEYOR SHALL STAMP THE DOCUMENT AND INCLUDE THE NOTATION "ALTERED BY" FOLLOWED BY THEIR SIGNATURE, THE DATE OF SUCH ALTERATION, AND A SPECIFIC DESCRIPTION OF THE ALTERATION.

WESTERN VIRGINIA
WATER AUTHORITY
PETERS CREEK ROAD
SANITARY SEWER
REPLACEMENT

No.	Submittal / Revision	App'd.	By	Date
1	ADDENDUM 2		DBH	06/27/18
2	CONSTRUCTION ISSUE		DBH	10/30/18

PETERS CREEK
ROAD - PLAN &
PROFILE

Designed By: SCF	Drawn By: RAS	Checked By: DBH
Issue Date: 03-01-18	Project No: 31237	Scale: AS SHOWN

Drawing No.:
C-106