


File: V:\PROJECTS\BVA\31237\CAD\ACAD\C4-C01-C109-31237.DWG
Saved: 11/5/2018 2:26:19 PM Plotted: 11/8/2018 4:17:36 PM Current User: Squires, Alan LastSavedBy: 5548

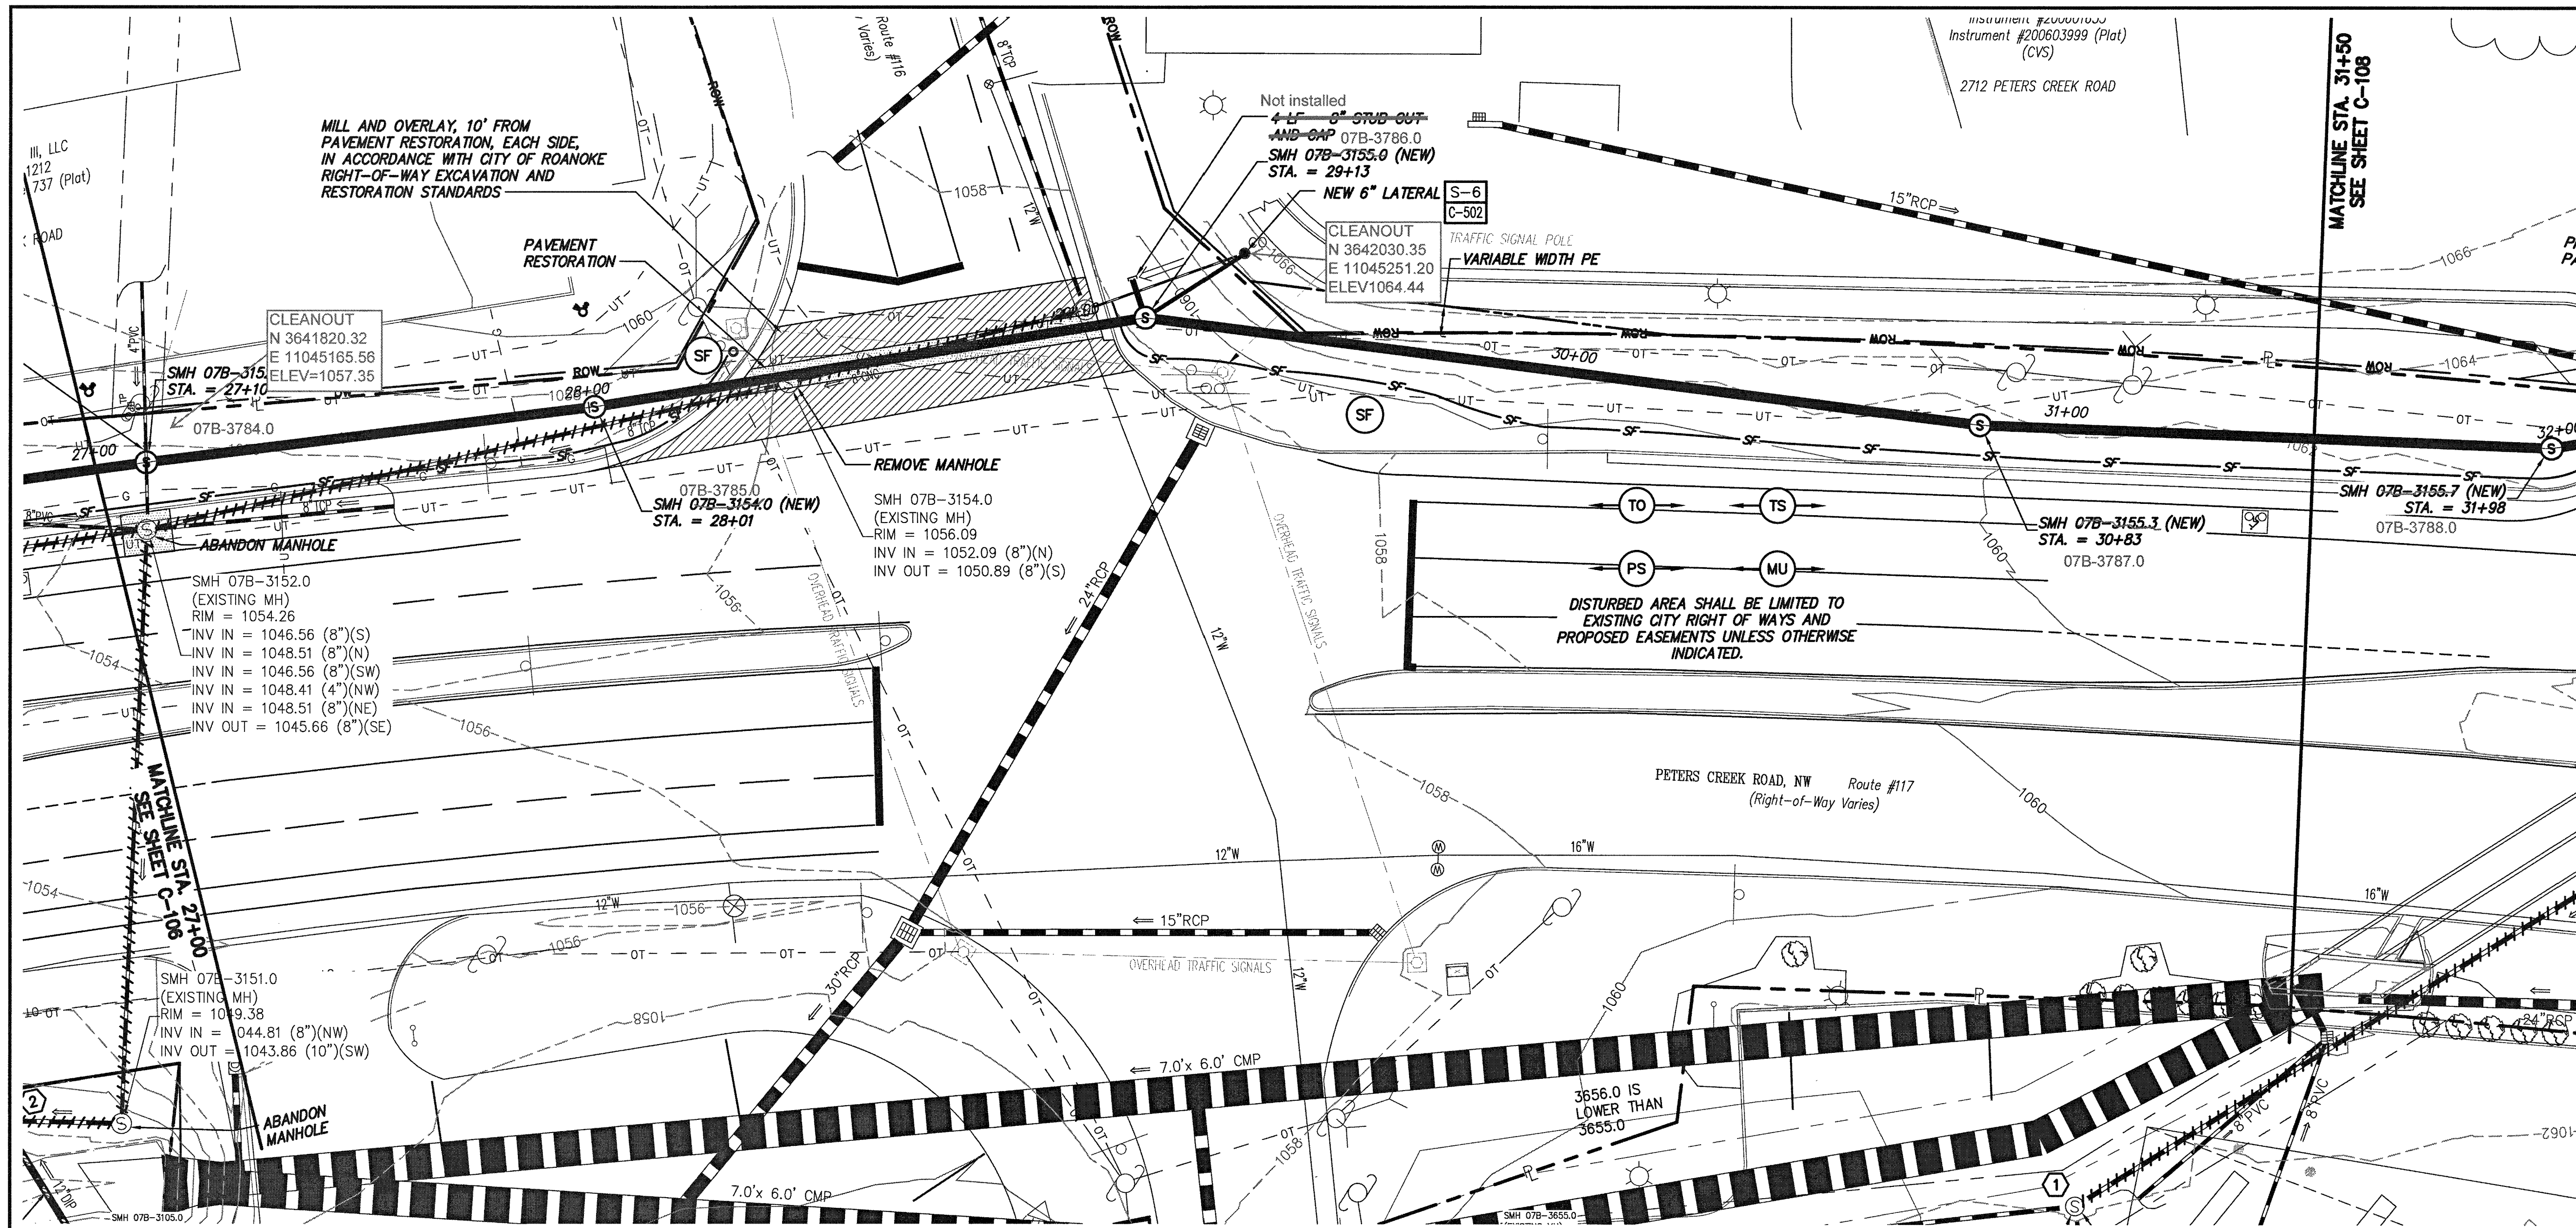


GENERAL NOTES:

- REFER TO SHEET C-504 OR C-505 FOR TYPICAL ROAD/LANE CLOSURE DETAILS AND REQUIREMENTS.
- CONTRACTOR SHALL PROVIDE BY-PASS PUMPING AS PER SPECIFICATIONS.
- REFER TO DETAIL S-3, SHEET C-502 FOR INSIDE DROPS IN MANHOLE.

SPECIFIC NOTES:

- INSTALL MECHANICAL PLUG AND GROUT ABANDONED SEWER.

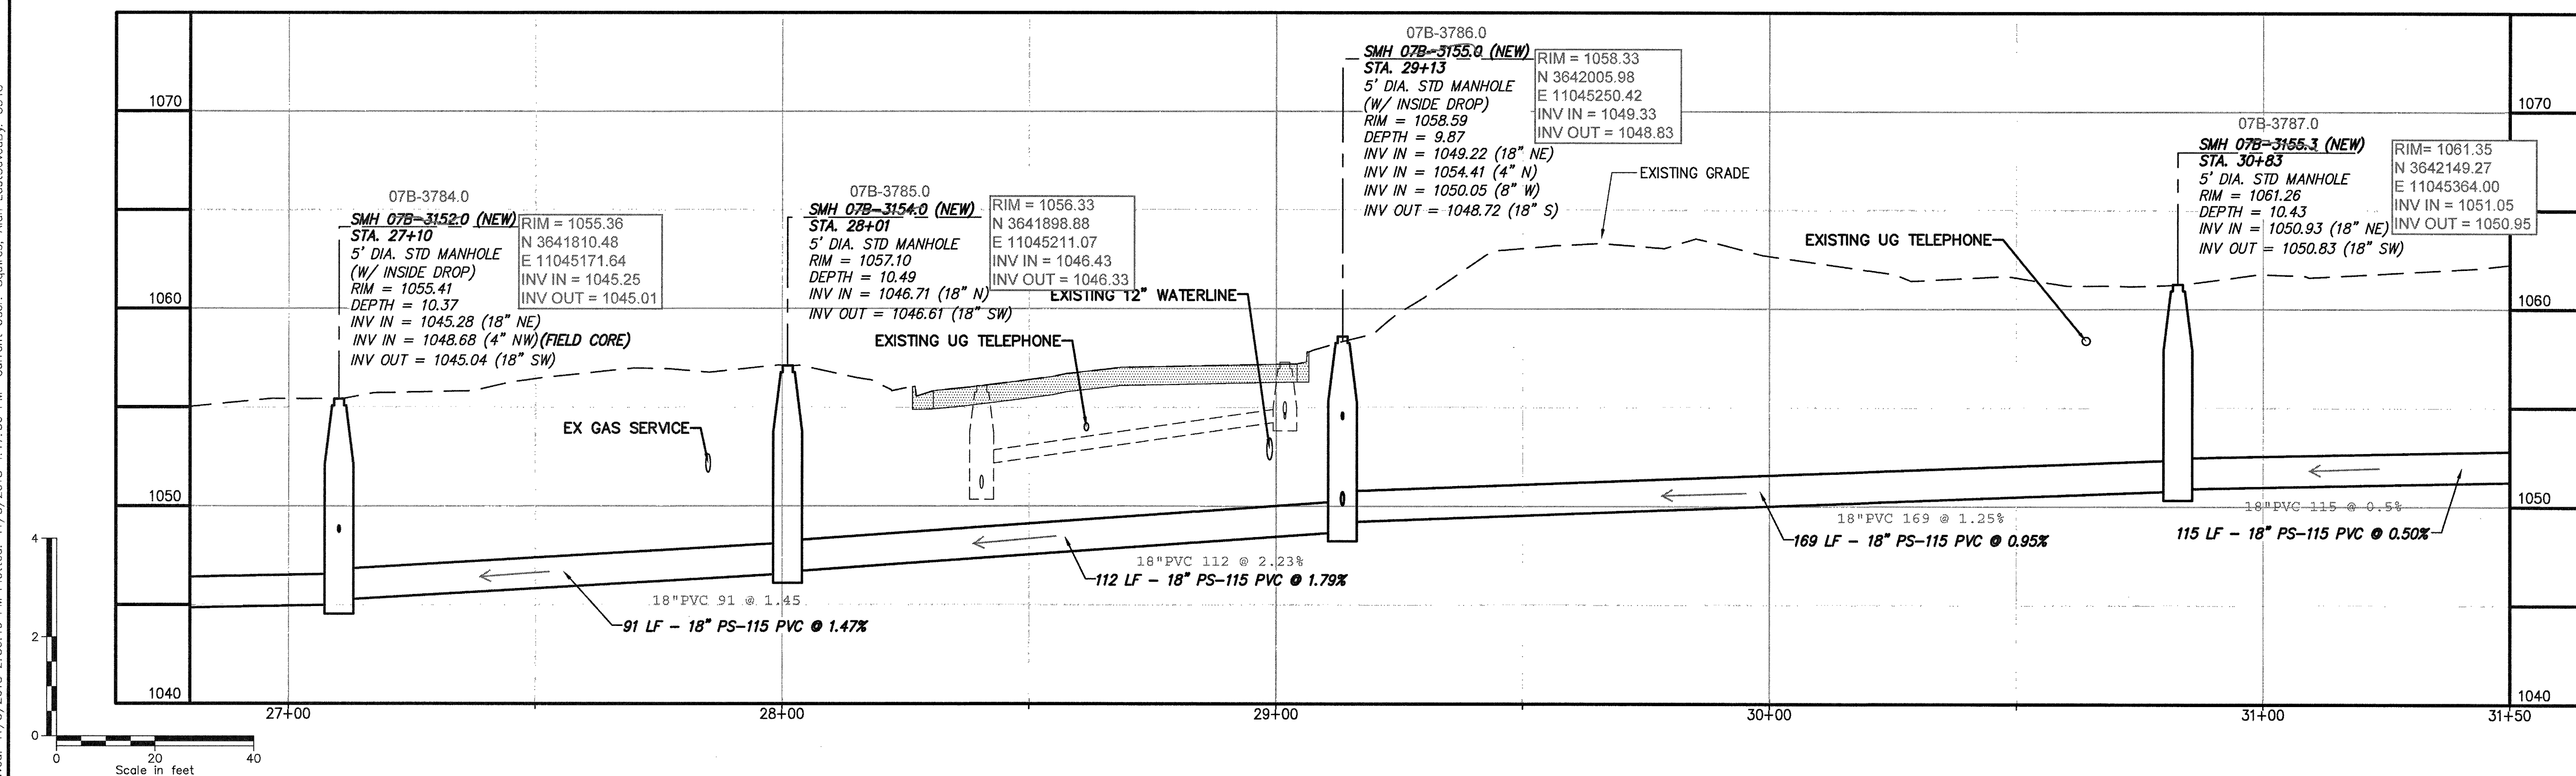

No.	Submittal / Revision	App'd. By	Date
1	ADDENDUM 2	DBH	06/27/18
2	CONSTRUCTION ISSUE	DBH	10/30/18

PETERS CREEK ROAD - PLAN & PROFILE

Designed By: SCF	Drawn By: RAS	Checked By: DBH
Issue Date: 03-01-18	Project No: 31237	Scale: AS SHOWN