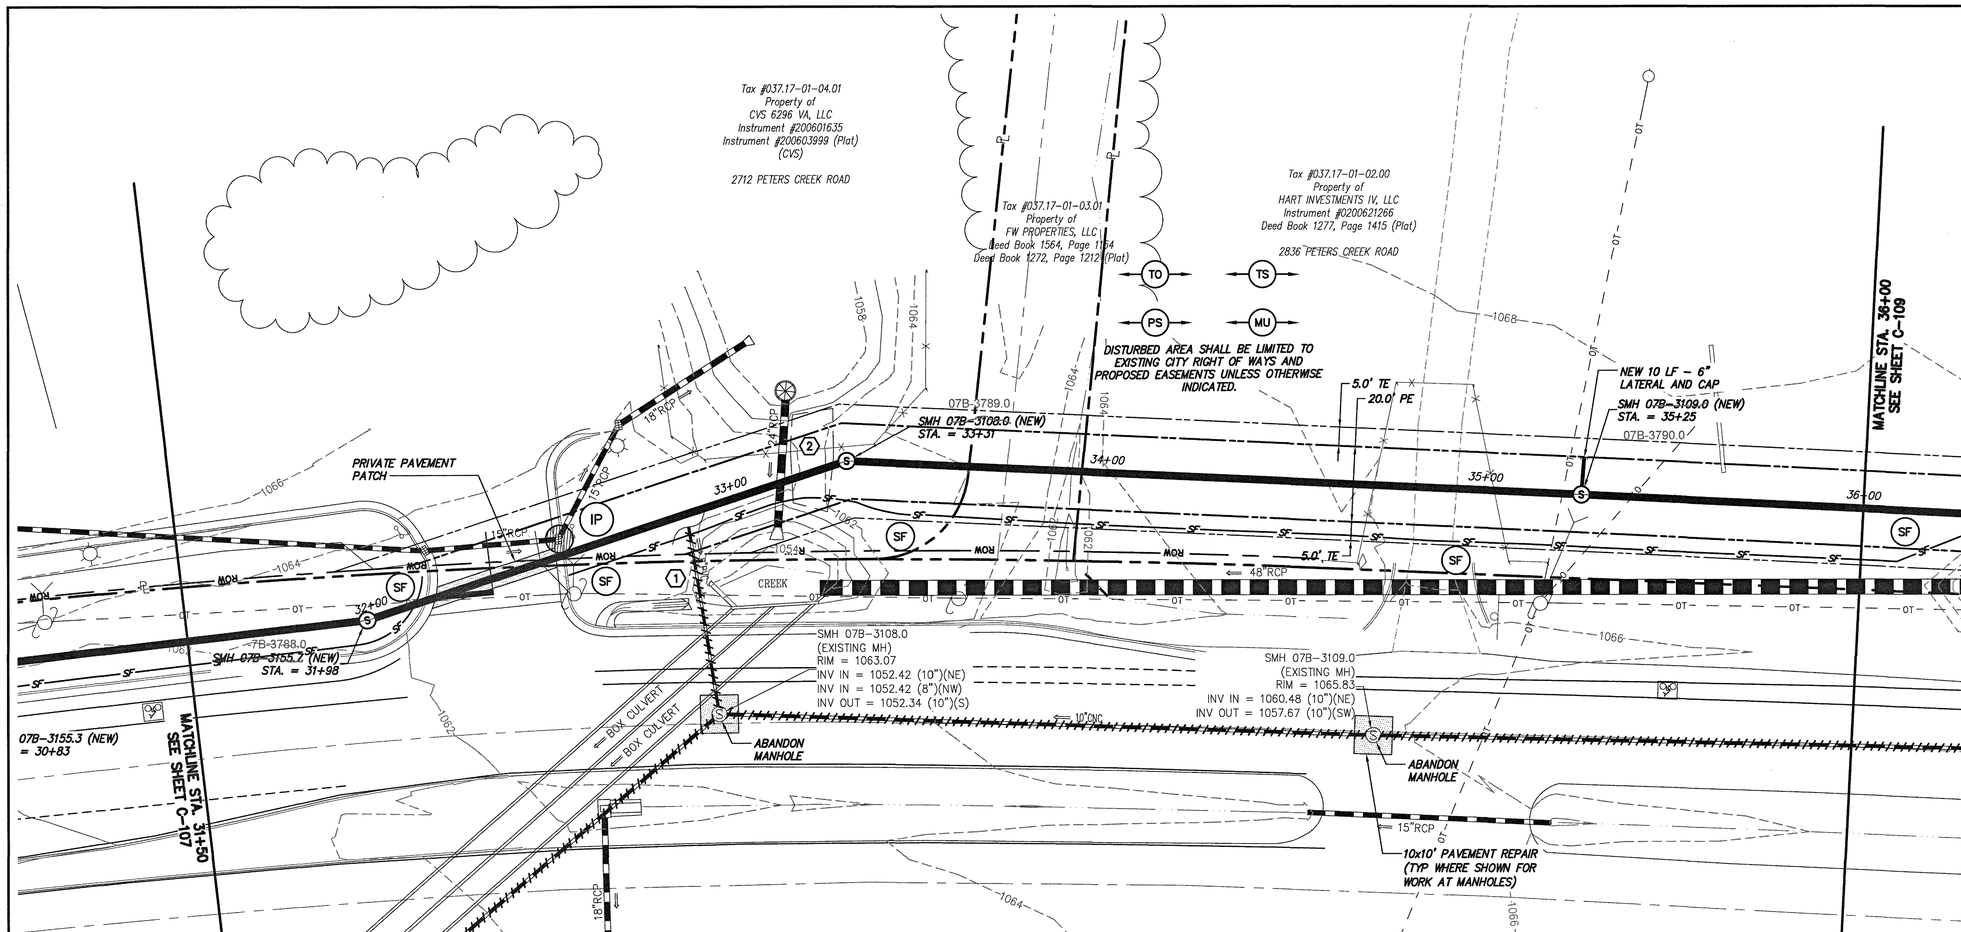

GENERAL NOTES:

A. REFER TO SHEET C-504 OR C-505 FOR TYPICAL ROAD/LANE CLOSURE DETAILS AND REQUIREMENTS.

B. CONTRACTOR SHALL PROVIDE BY-PASS PUMPING AS PER SPECIFICATIONS.

C. REFER TO DETAIL S-3, SHEET C-502 FOR INSIDE DROPS IN MANHOLE.

SPECIFIC NOTES:

1. CONTRACTOR TO CONFIRM THAT THIS LINE IS INACTIVE AND ABANDON.
2. CONTRACTOR SHALL REPLACE ANY LANDSCAPING, TREES OR SHRUBS TO MATCH EXISTING CONDITIONS THAT ARE DISTURBED DURING CONSTRUCTION.

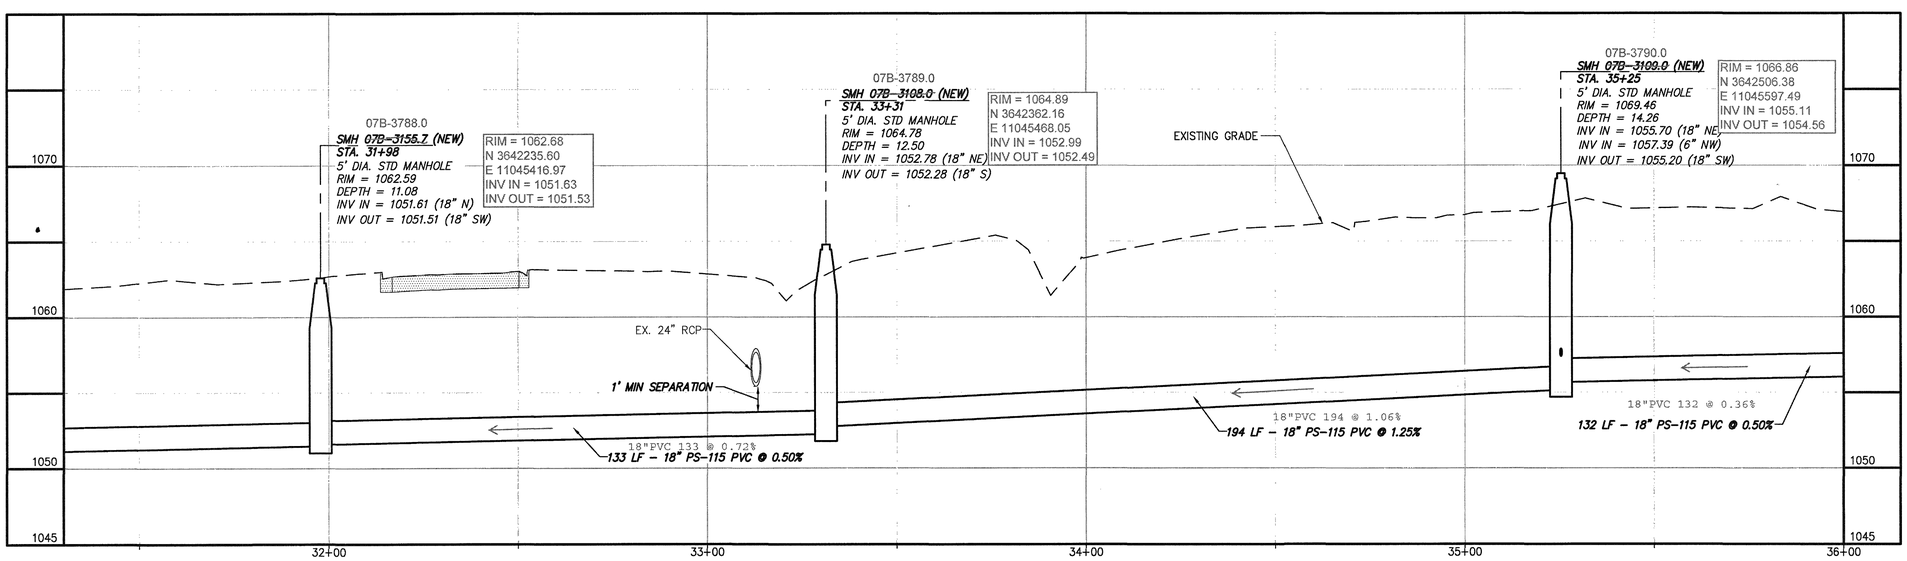

Drawing Copyright © 2018

CHA
1341 Research Center Drive, Suite 2100
Blacksburg, VA 24060
540.552.5548 • www.chacompanies.com

WESTERN VIRGINIA WATER AUTHORITY

COMMONWEALTH OF VIRGINIA
DOUGLAS B. HUDGINS
Lic. No. 034694
06/27/18
PROFESSIONAL ENGINEER

IT IS A VIOLATION OF LAW FOR ANY PERSON, UNLESS THEY ARE ACTING UNDER THE DIRECTION OF A LICENSED PROFESSIONAL ENGINEER, ARCHITECT, LANDSCAPE ARCHITECT OR LAND SURVEYOR TO ALTER AN ITEM IN ANY WAY. IF AN ITEM BEARING THE STAMP OF A LICENSED PROFESSIONAL IS ALTERED, THE ALTERING ENGINEER, ARCHITECT, LANDSCAPE ARCHITECT OR LAND SURVEYOR SHALL STAMP THE DOCUMENT AND INCLUDE THE NOTATION "ALTERED BY" FOLLOWED BY THEIR SIGNATURE, THE DATE OF SUCH ALTERATION, AND A SPECIFIC DESCRIPTION OF THE ALTERATION.

WESTERN VIRGINIA WATER AUTHORITY
PETERS CREEK ROAD SANITARY SEWER REPLACEMENT

No.	Submittal / Revision	App'd.	By	Date
1	ADDENDUM 2		DBH	06/27/18
2	CONSTRUCTION ISSUE		DBH	10/30/18

PETERS CREEK ROAD - PLAN & PROFILE

Designed By:	Drawn By:	Checked By:
SCF	RAS	DBH
Issue Date:	Project No:	Scale:
03-01-18	31237	AS SHOWN

Drawing No.:
C-108

File: V:\PROJECTS\BVA\31237\CADD_ACAD\C4-C101-C109_31237.DWG
Saved: 11/5/2018 2:36:19 PM Plotted: 11/8/2018 4:17:51 PM Current User: Squires, Alan LastSavedBy: 5548