



File: V:\PROJECTS\BVA\31237\CADD\CAD\C4-C101-C109_31237.DWG
Saved: 11/5/2018 2:36:19 PM Plotted: 11/9/2018 4:18:09 PM Current User: Squires, Alan LastSavedBy: 5548

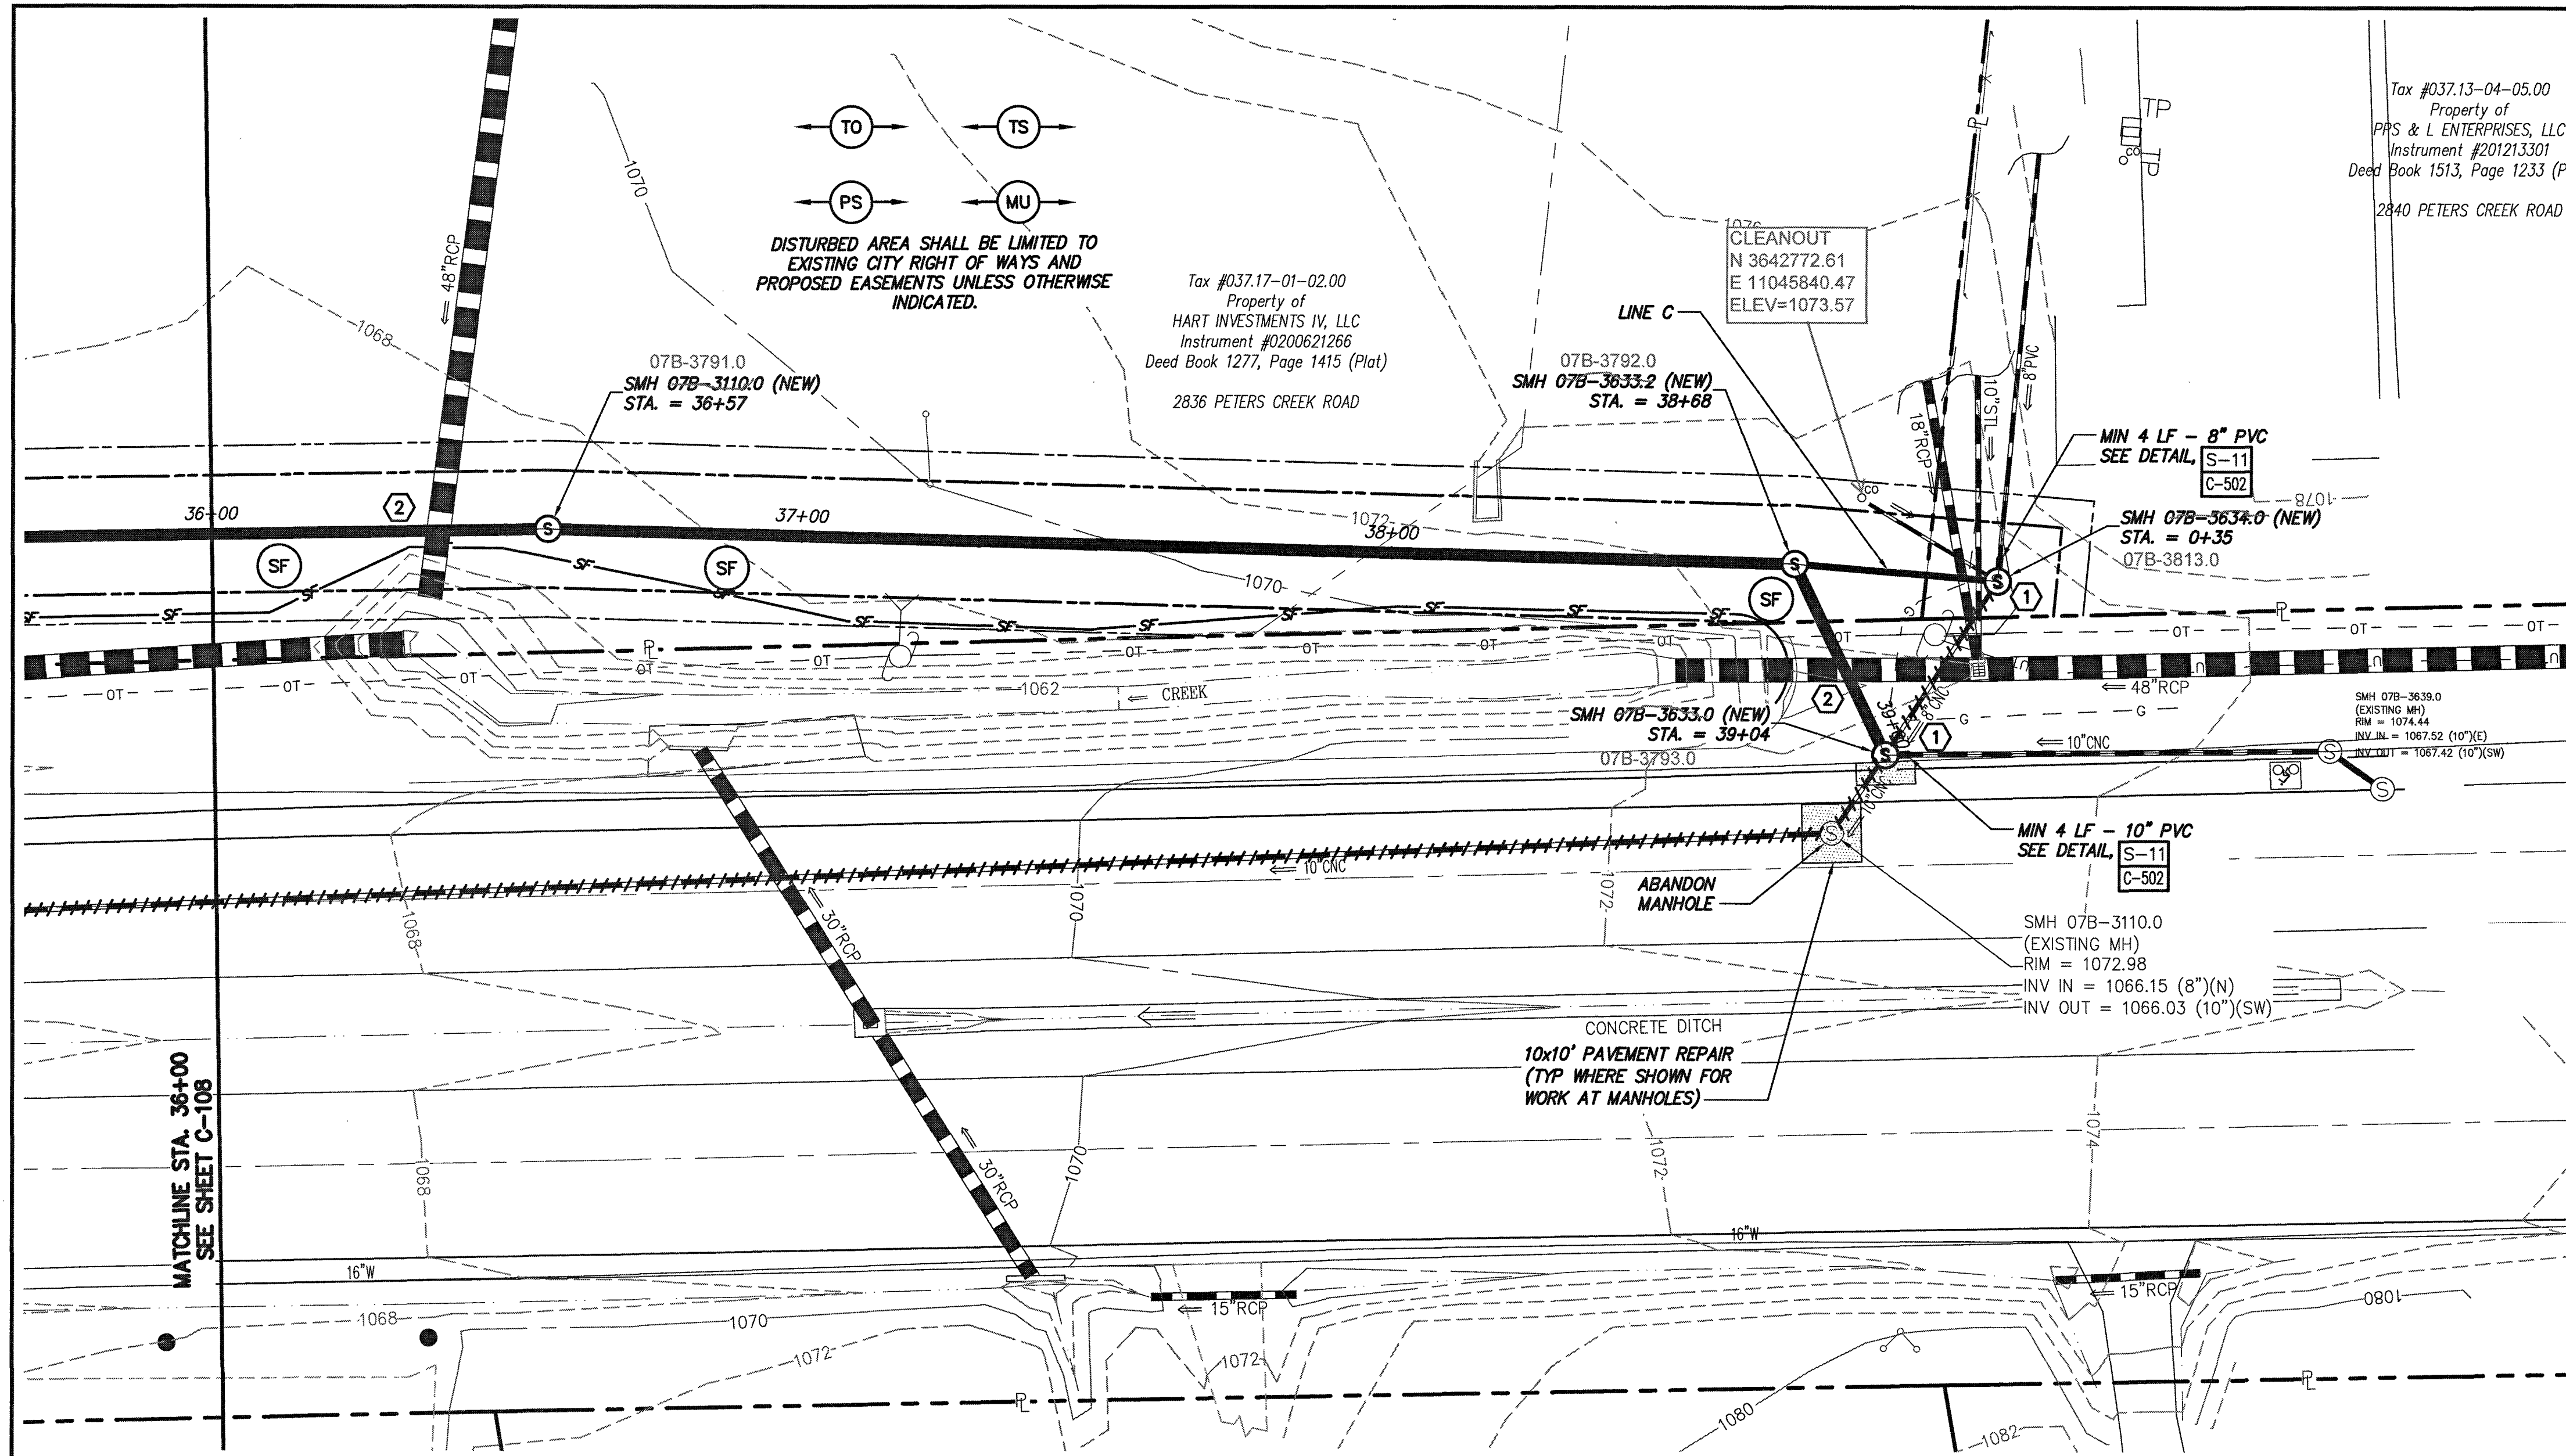

Tax #037.13-04-05.00
Property of
PWS & L ENTERPRISES, LLC
Instrument #201213301
Deed Book 1513, Page 1233 (Pl.)
2840 PETERS CREEK ROAD


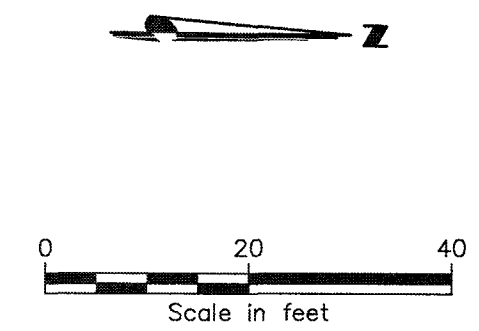


GENERAL NOTES:

- REFER TO SHEET C-504 OR C-505 FOR TYPICAL ROAD/LANE CLOSURE DETAILS AND REQUIREMENTS.
- CONTRACTOR SHALL PROVIDE BY-PASS PUMPING AS PER SPECIFICATIONS.
- REFER TO DETAIL S-3, SHEET C-502 FOR INSIDE DROPS IN MANHOLE.

SPECIFIC NOTES:

- DO NOT RECONNECT ABANDONED SANITARY SEWER TO NEW MANHOLE.
- CONTRACTOR TO TEST (OBSERVATION) PIT PROPOSED 48" CULVERT CROSSING AT INITIATION OF CONSTRUCTION TO INSURE ADEQUATE CLEARANCE. ADJUST SEWER DEPTH TO CLEAR CULVERT AT NO ADDITIONAL COST TO OWNER.

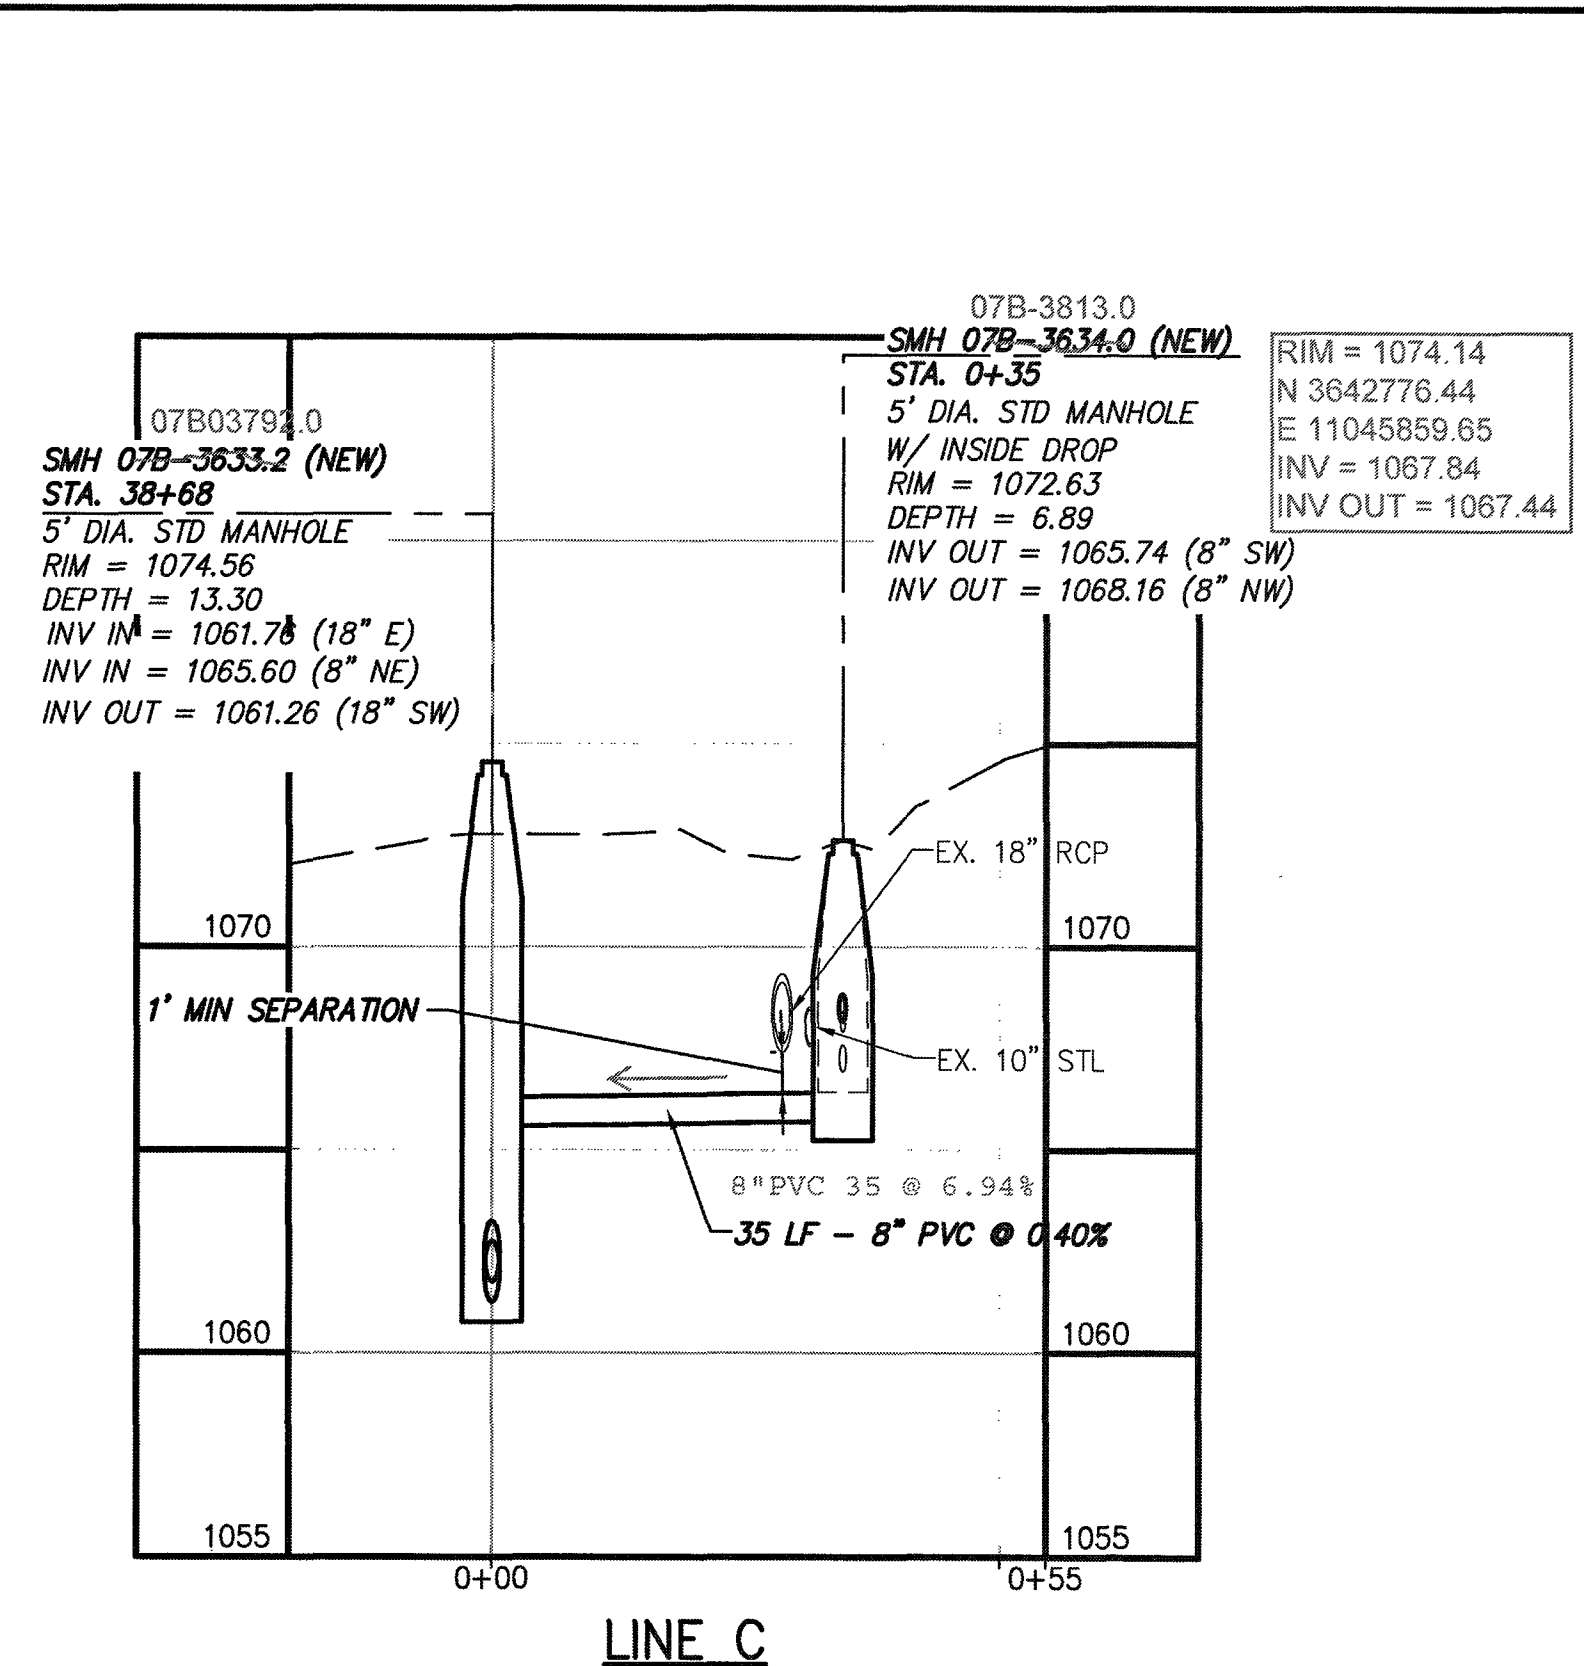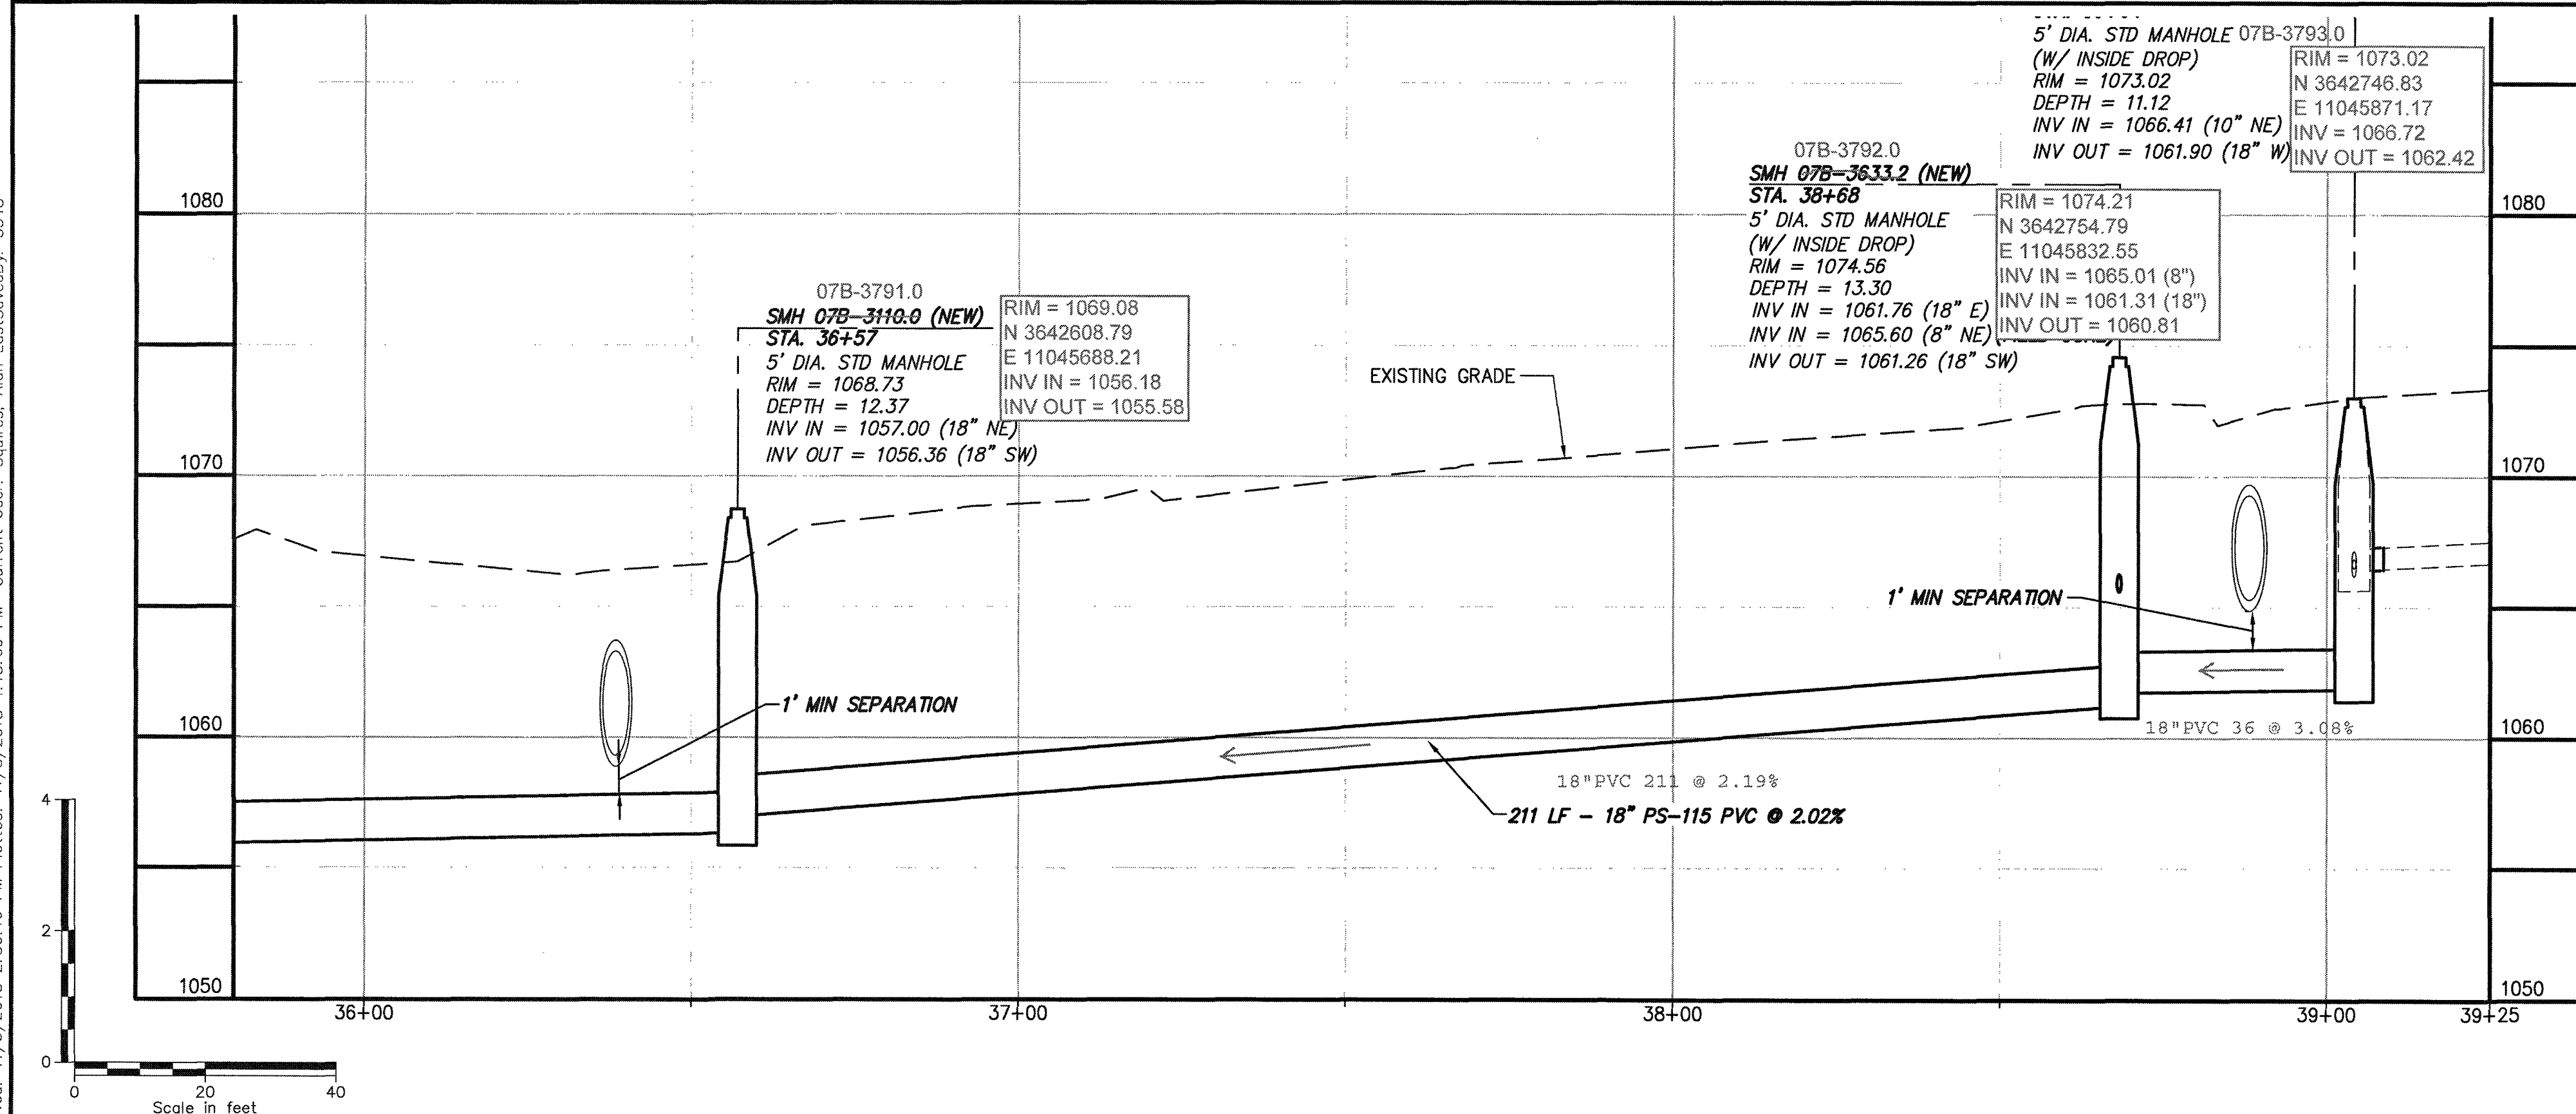

No.	Submital / Revision	App'd	By	Date
1	ADDENDUM 2		DBH	06/27/18
2	CONSTRUCTION ISSUE		DBH	10/30/18

PETERS CREEK ROAD - PLAN & PROFILE

Designed By:	Drawn By:	Checked By:
SCF	RAS	DBH
Issue Date:	Project No:	Scale:
03-01-18	31237	AS SHOWN

Drawing No.:

C-109