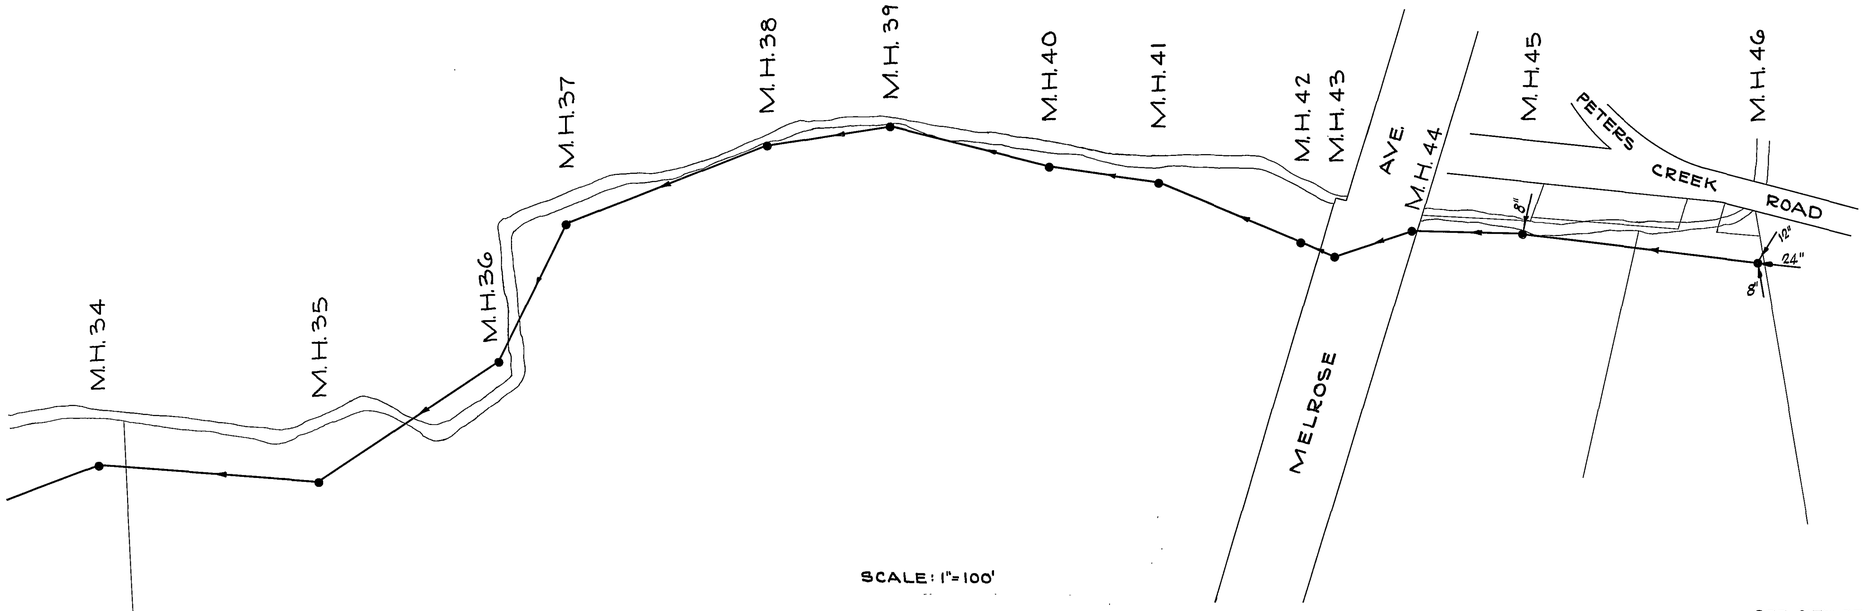

SCALE: 1"=100'

SEE CITY OF ROANOKE SEWER MAP, SHEET 276

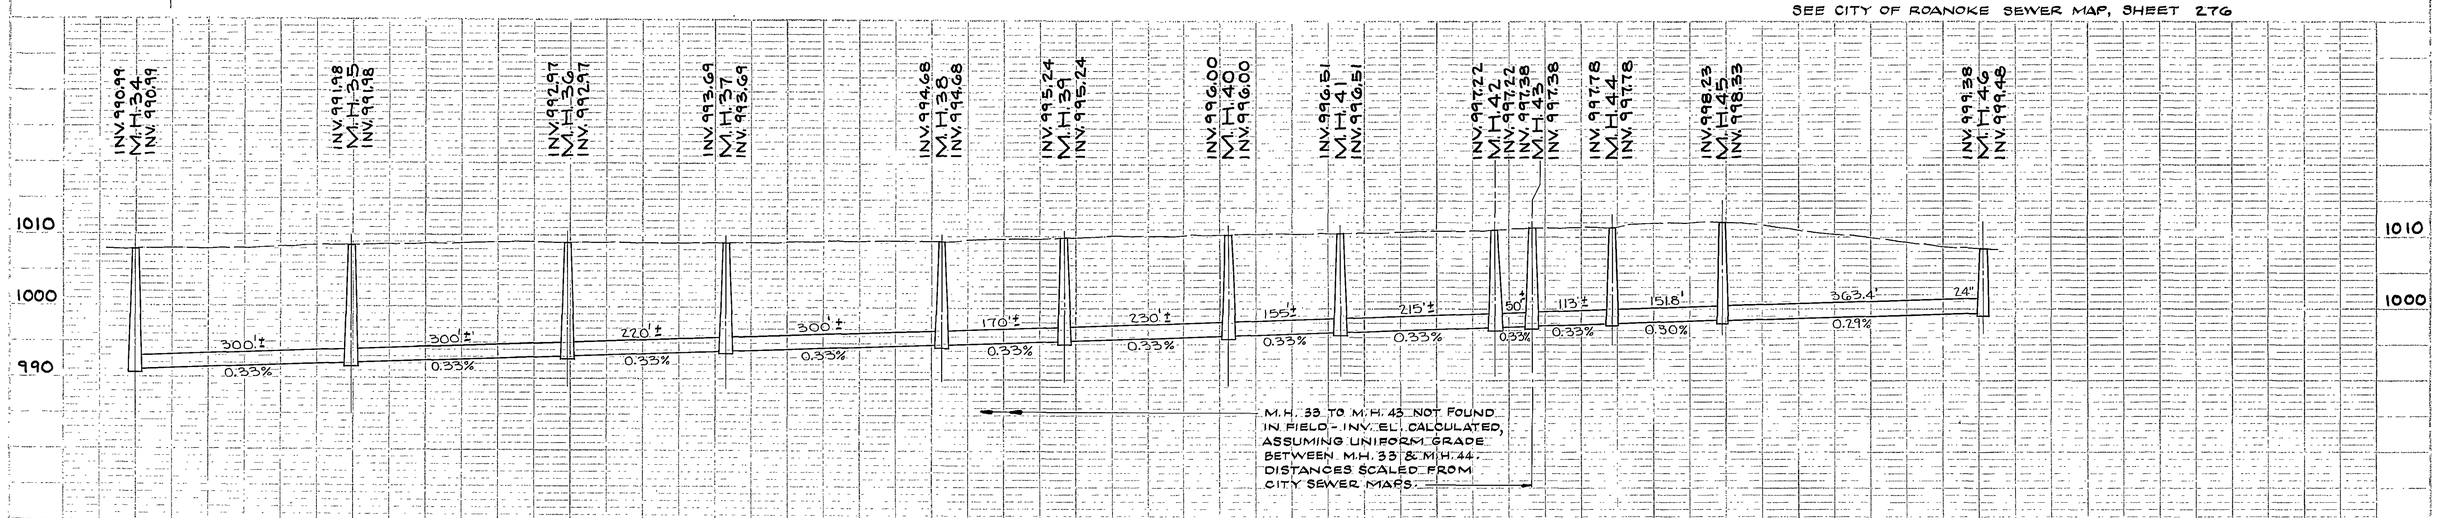

SCALE HORIZ. 1"=100'
VERT. 1"=10'

DEPARTMENT OF PUBLIC WORKS
CITY OF ROANOKE

PETERS CREEK TRUNK SEWER

APPENDIX B TO REPORT ON SANITARY SEWERAGE INTERCEPTORS AND TRUNK MAINS

PREPARED BY
HAYES, SEAY, MATTERN & MATTERN
ARCHITECTS — ENGINEERS

DECEMBER, 1965