


ROANOKE, VIRGINIA AND VICINITY

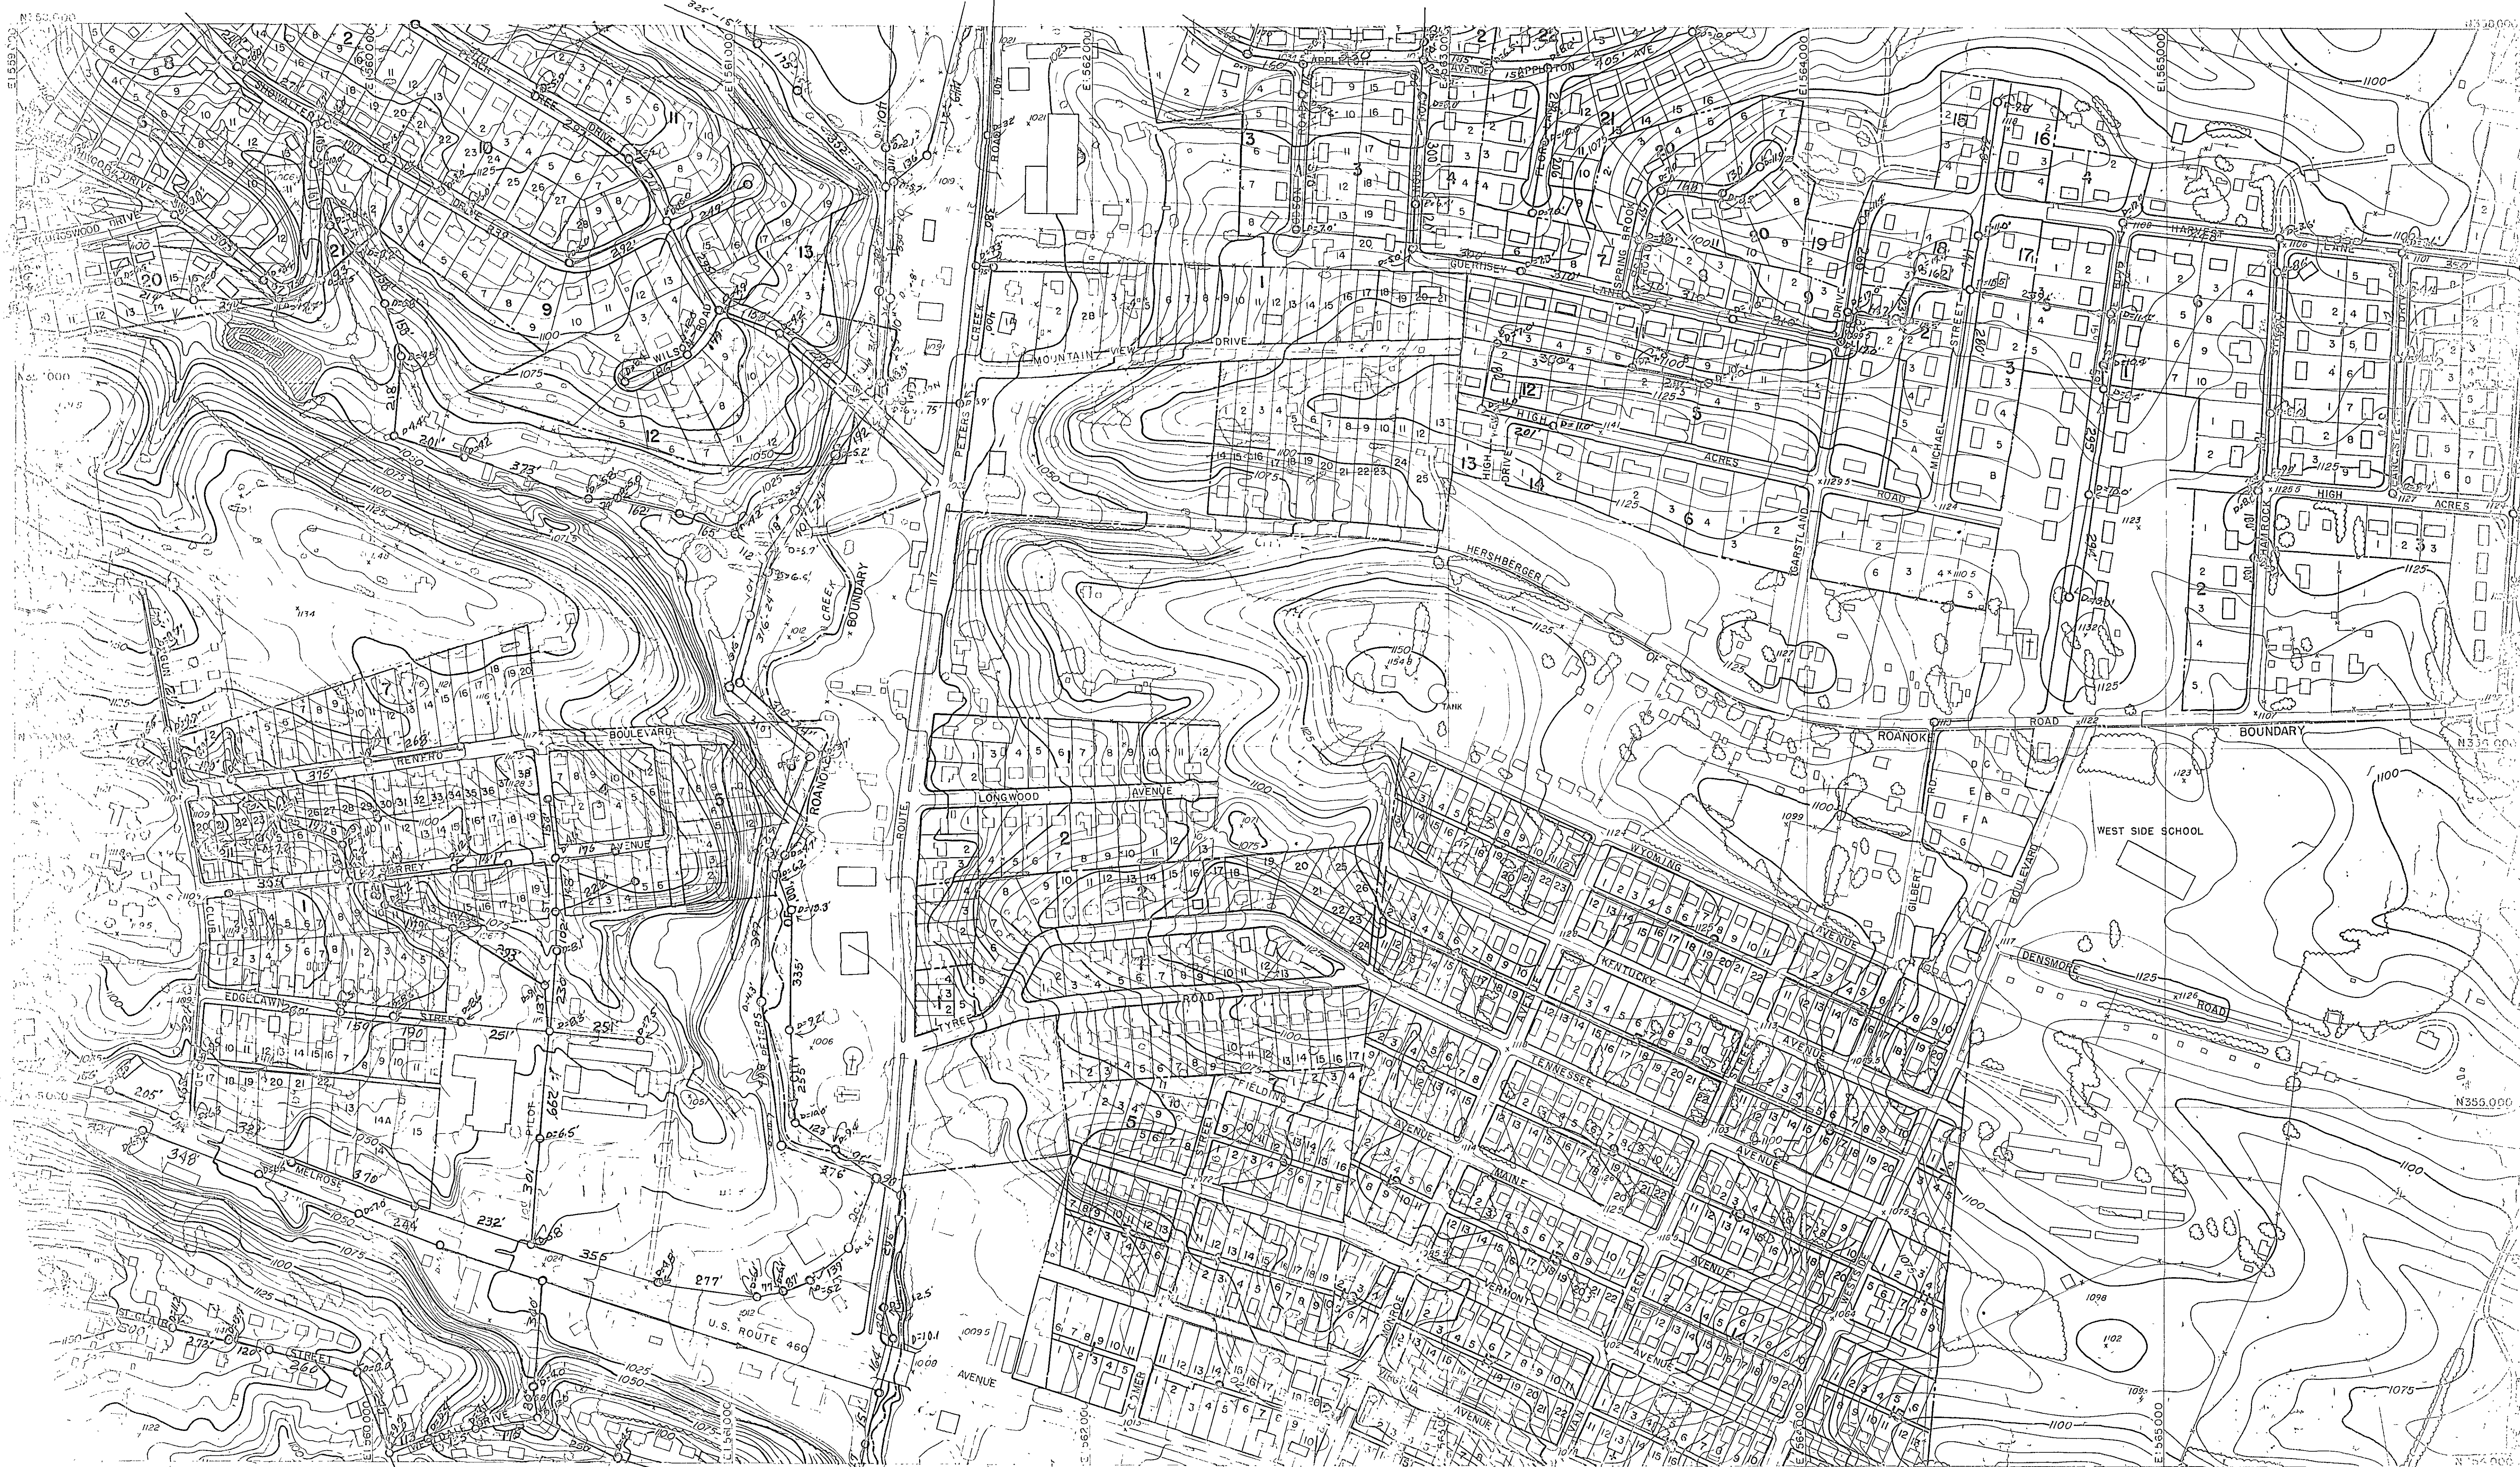

PREPARED BY
AMERICAN AIR SURVEYS, INC.
907 PENN AVENUE
PITTSBURGH, PA
15222

THE PREPARATION OF THIS MAP WAS FINANCED IN PART
THROUGH AN URBAN PLANNING GRANT FROM THE HOUSING
AND HOME FINANCE AGENCY UNDER THE PROVISIONS OF
SECTION 701 OF THE HOUSING ACT OF 1954, AS AMENDED

SCALE: 1" = 200'
1000' GRID BASED VIRGINIA STATE COORDINATE SYSTEM
ELEVATION INTERVAL: 5'

REVISIONS		
DATE	DATE	DATE
1 FEB 63	1 FEB 66	1 FEB 69
1 FEB 64	1 FEB 67	30 JUN 70
1 FEB 65	1 FEB 68	30 JUN 71

DATE MARCH, 1961

SHEET NO. 127
SEWER

REVISIONS		
DATE	DATE	DATE
30 JUN 72		
30 JUN 73		

PREPARED FOR
ROANOKE VALLEY
REGIONAL PLANNING & ECONOMIC DEVELOPMENT COMMISSION
ROANOKE, VIRGINIA