


- GENERAL NOTES:**
- SEWER LATERALS SHOWN ARE BASED ON CCTV FOOTAGE. ADDITIONAL LATERALS & CONFLICTS SHALL BE INVESTIGATED BY CONTRACTOR PRIOR TO EXCAVATION.
 - PROPERTY LINES SHOWN ON THIS PAGE WERE SET BASED ON RECORDS AND FIELD SURVEY DATA.

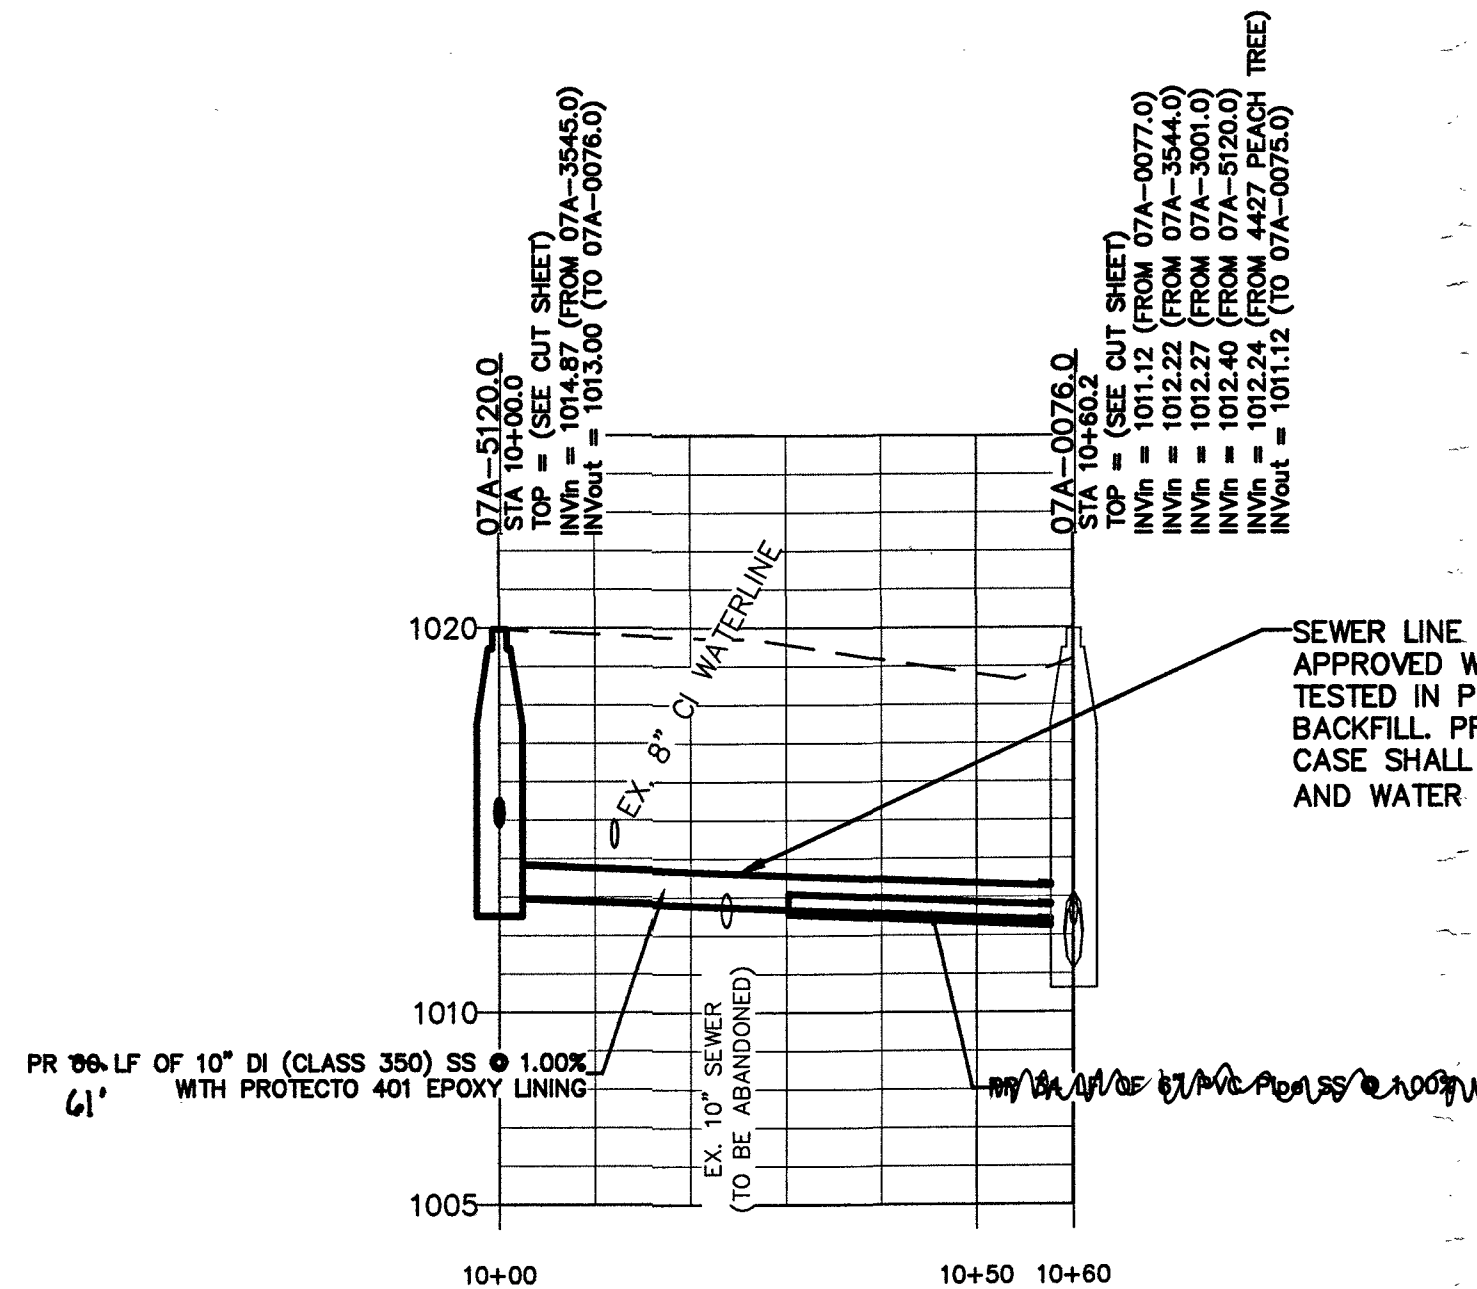

SEWERLINE "B"

SCALE
VERTICAL: 1" = 5'
HORIZONTAL: 1" = 20'

- SURVEY NOTES:**
- ALL SURVEY FOR THIS PROJECT WAS CONDUCTED USING A COMBINATION OF TOTAL STATION AND RTK GPS EQUIPMENT. THE DATUMS USED FOR THE SURVEY ARE NAD83 & NAVD88. THE COORDINATE SYSTEM USED FOR THE SURVEY IS VIRGINIA STATE PLANE, SOUTH ZONE, US FOOT.
 - ALL SURVEY DATA'S GENERAL ACCURACY IS AS FOLLOWS:
-HORIZONTAL ACCURACY: WITHIN 0.5' WITH OCCASIONAL EXCEPTION
-VERTICAL ACCURACY: WITHIN 0.1' WHERE INFORMATION IS PROVIDED ON PLAN
 - CONTOUR DATA ON THIS PLAN IS GENERALLY ACCURATE TO WITHIN ±0.5' WHERE CONTOUR DATA IS PROVIDED.
 - THIS PLAN WAS PREPARED WITHOUT THE BENEFIT OF A CURRENT TITLE REPORT AND THEREFORE, THERE MAY EXIST ENCUMBRANCES NOT SHOWN HEREON.
 - WITH OCCASIONAL EXCEPTION, EDGE OF PAVEMENT, GRAVEL, CONCRETE, & BRICK ARE SHOWN BASED ON GEOREFERENCED AERIAL IMAGERY AND ARE TYPICALLY ACCURATE TO WITHIN 1.0'.
 - WITH OCCASIONAL EXCEPTION, EXISTING BUILDINGS SHOWN ARE BASED ON MUNICIPAL GIS DATA AND GEOREFERENCED AERIAL IMAGERY AND ARE TYPICALLY ACCURATE TO WITHIN 5.0'.
 - WITH OCCASIONAL EXCEPTION, PROPERTY LINES ON THIS PLAN ARE BASED ON GIS DATA AND HAVE NOT BEEN FIELD SURVEYED.
 - SEWER LATERALS SHOWN ON THIS PLAN ARE BASED ON CCTV FOOTAGE AND HAVE NOT BEEN FIELD SURVEYED EXCEPT IN CASES WHERE A CLEAN-OUT IS PRESENT. ADDITIONAL LATERALS & CONFLICTS SHALL BE INVESTIGATED BY CONTRACTOR PRIOR TO EXCAVATION.
 - THIS PLAN DOES NOT GUARANTEE THE EXISTENCE, LOCATION, SIZE, MATERIAL OR TYPE OF ANY UNDERGROUND UTILITIES. ALL UNDERGROUND UTILITIES & STRUCTURES SHOWN ON THIS PLAN ARE SHOWN BASED ON SURVEYED ABOVE GROUND STRUCTURES, CCTV SURVEYS, AVAILABLE PUBLIC RECORDS AND BY UTILITY LINE LOCATION MARKINGS ESTABLISHED BY MISS UTILITY OF VIRGINIA TICKETS. ALL UNDERGROUND UTILITY & STRUCTURE LOCATION SHOULD BE FIELD VERIFIED PRIOR TO THE START OF ANY CONSTRUCTION.

**PETERS CREEK SEWER
ABANDONMENT
PLAN & PROFILE**

Rev	Description	Date	By
1	DESIGN CHANGE REQUEST	8/29/19	DRJ

Designed: DRJ
Drawn: AJC
Checked: NSS, AJC
Approved: TEC
Date: AUGUST 2019
Project: SCIP-239