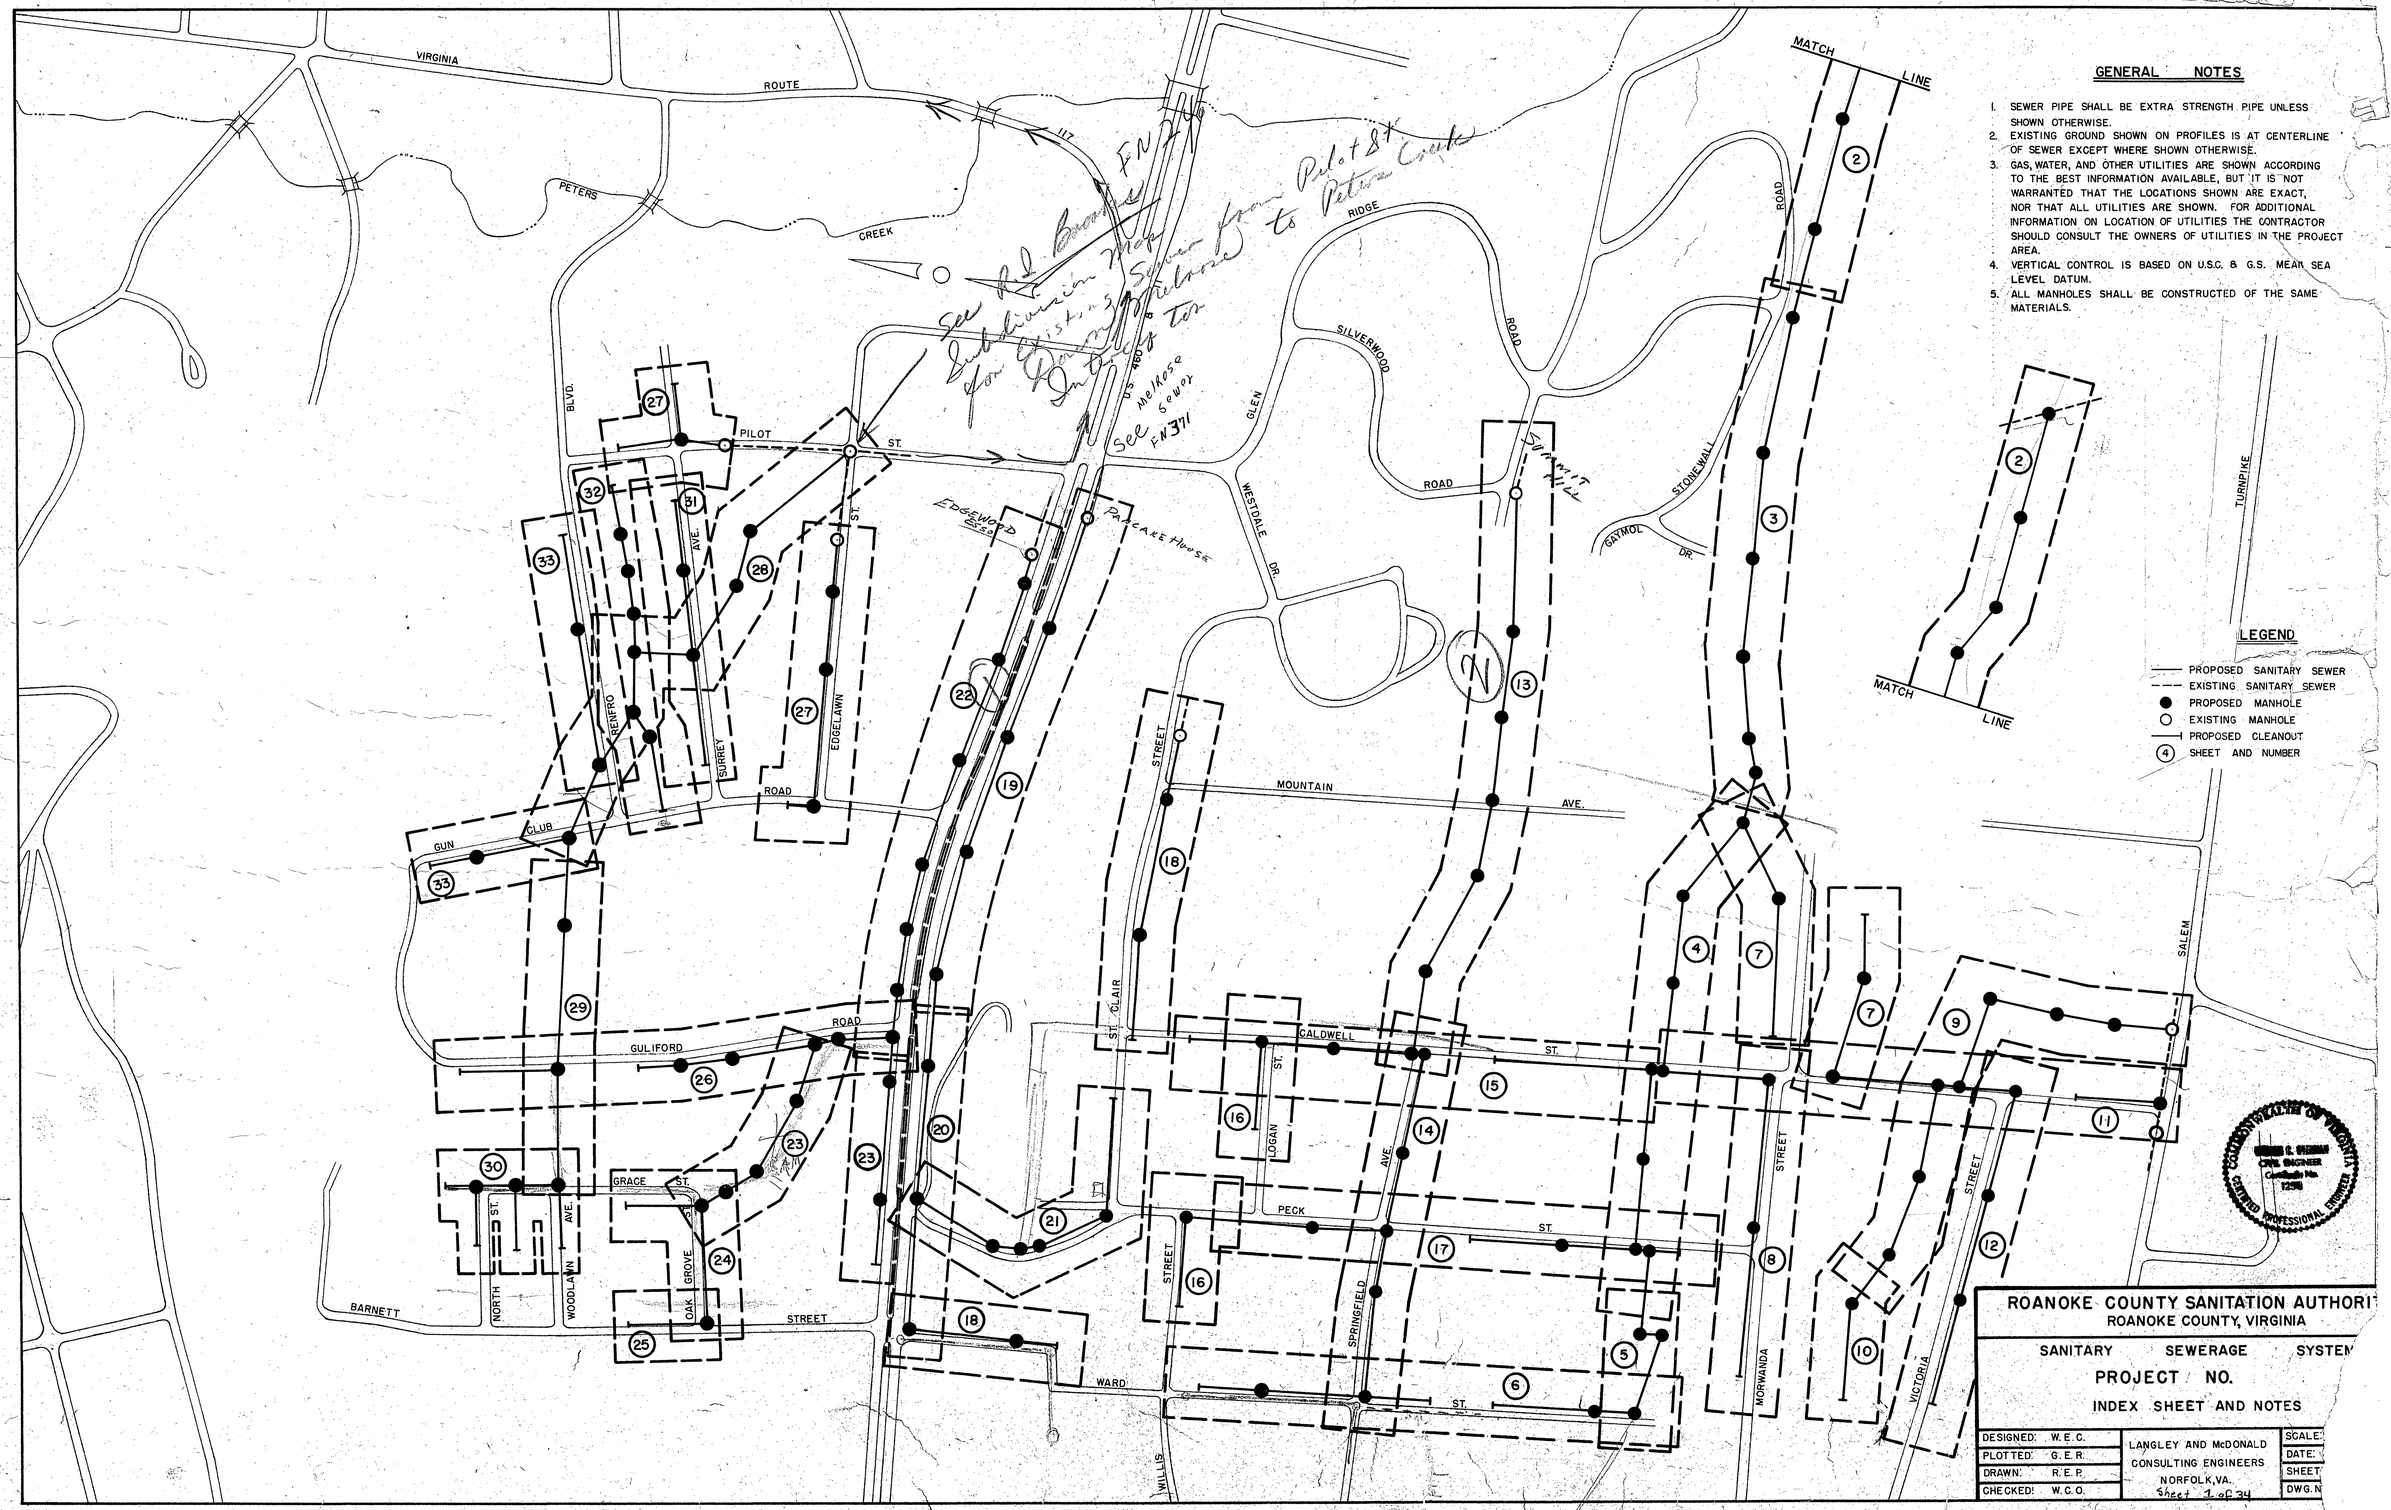

GENERAL NOTES

1. SEWER PIPE SHALL BE EXTRA STRENGTH PIPE UNLESS SHOWN OTHERWISE.
2. EXISTING GROUND SHOWN ON PROFILES IS AT CENTERLINE OF SEWER EXCEPT WHERE SHOWN OTHERWISE.
3. GAS, WATER, AND OTHER UTILITIES ARE SHOWN ACCORDING TO THE BEST INFORMATION AVAILABLE, BUT IT IS NOT WARRANTED THAT THE LOCATIONS SHOWN ARE EXACT, NOR THAT ALL UTILITIES ARE SHOWN. FOR ADDITIONAL INFORMATION ON LOCATION OF UTILITIES THE CONTRACTOR SHOULD CONSULT THE OWNERS OF UTILITIES IN THE PROJECT AREA.
4. VERTICAL CONTROL IS BASED ON U.S.C. & G.S. MEAN SEA LEVEL DATUM.
5. ALL MANHOLES SHALL BE CONSTRUCTED OF THE SAME MATERIALS.

LEGEND

- PROPOSED SANITARY SEWER
- EXISTING SANITARY SEWER
- PROPOSED MANHOLE
- EXISTING MANHOLE
- PROPOSED CLEANOUT
- (4) SHEET AND NUMBER

COMMONWEALTH OF VIRGINIA
CERTIFIED PROFESSIONAL ENGINEER

ROANOKE COUNTY SANITATION AUTHORITY
ROANOKE COUNTY, VIRGINIA

SANITARY SEWERAGE SYSTEM

PROJECT NO.

INDEX SHEET AND NOTES

DESIGNED: W.E.C.	LANGLEY AND McDONALD CONSULTING ENGINEERS NORFOLK, VA.	SCALE:	
PLOTTED: G.E.R.		DATE:	
DRAWN: R.E.P.		SHEET	
CHECKED: W.C.O.	Sheet 1 of 34	DWG. N	