



PLAN	DATE
SURVEYED	10/23/64
NOTE BOOK	10/23/64
RT. OF WAY CHECKED	
NO.	

PROFILE	DATE
SURVEYED	10/23/64
NOTE BOOK	10/23/64
GRADES CHECKED	
B. M. NOTED	
STRUCTURE NOTATIONS	

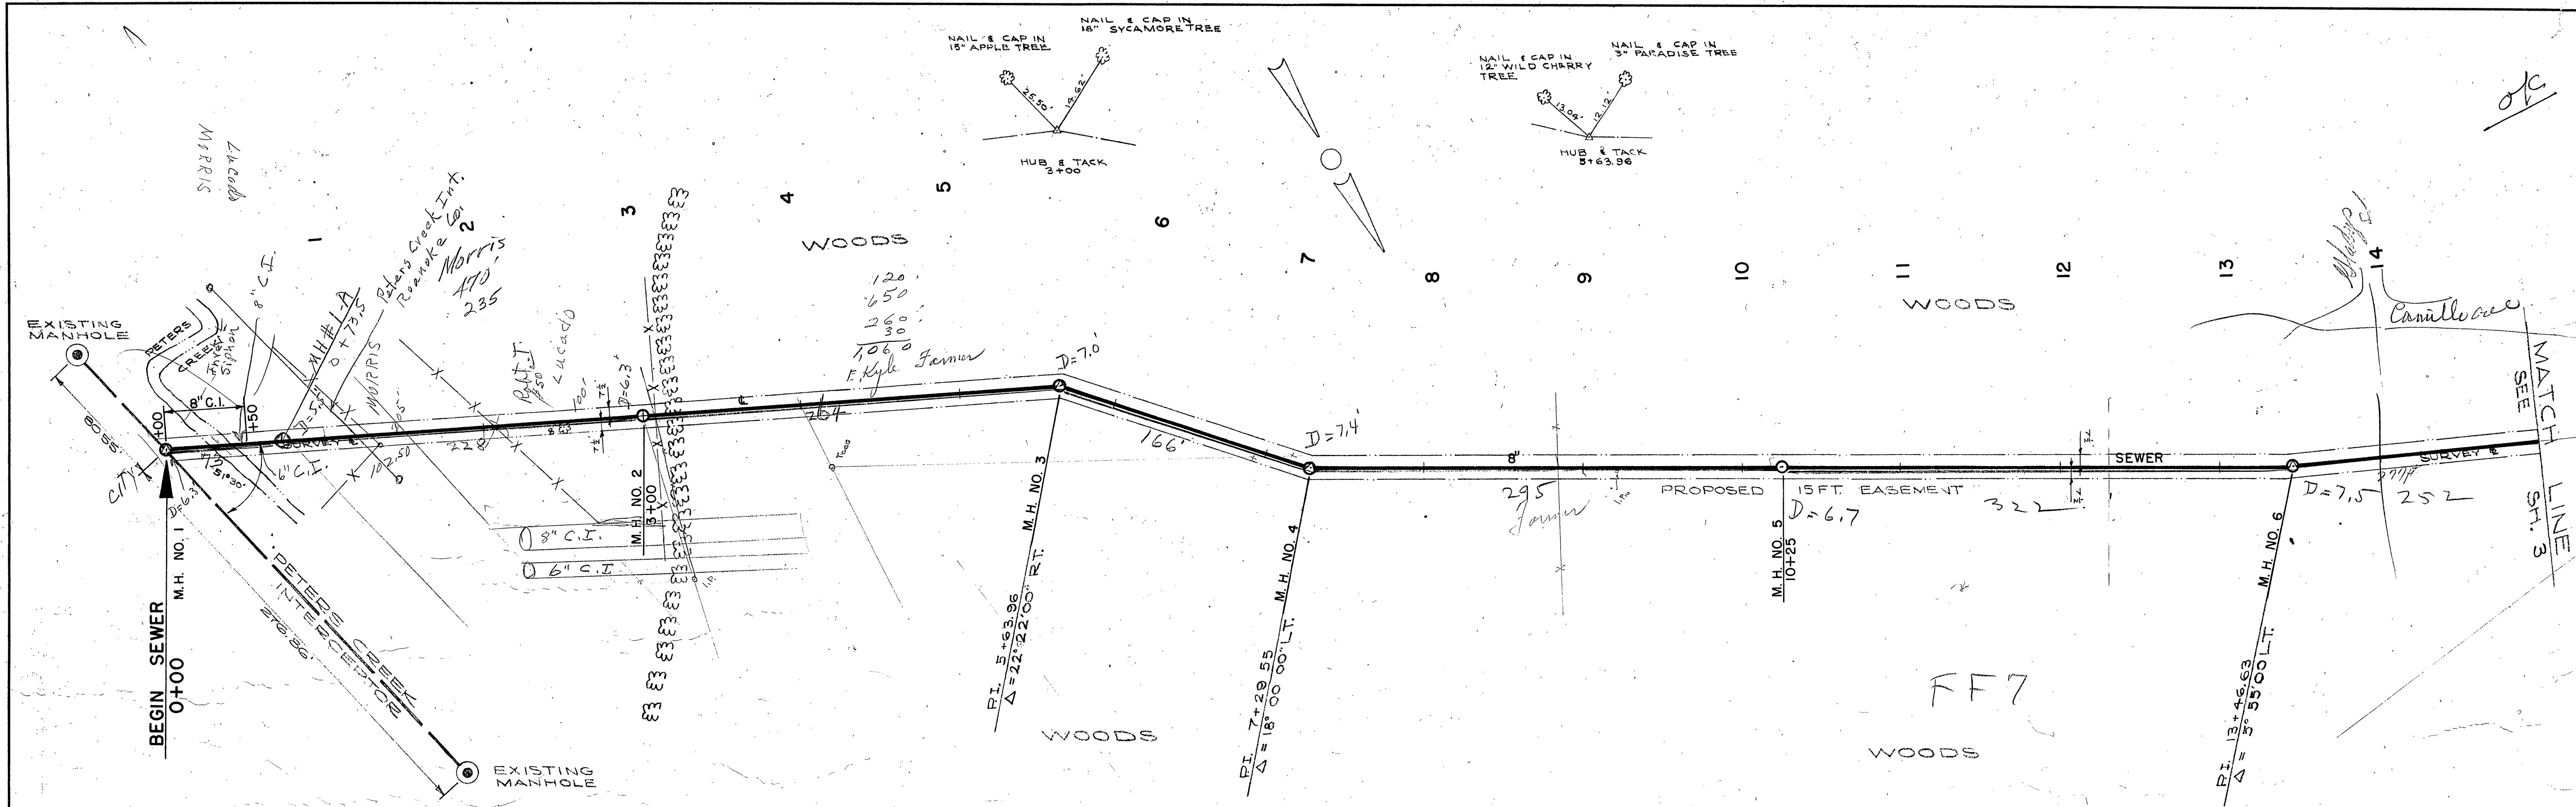

SCALE: 1 IN. = 50 FT.

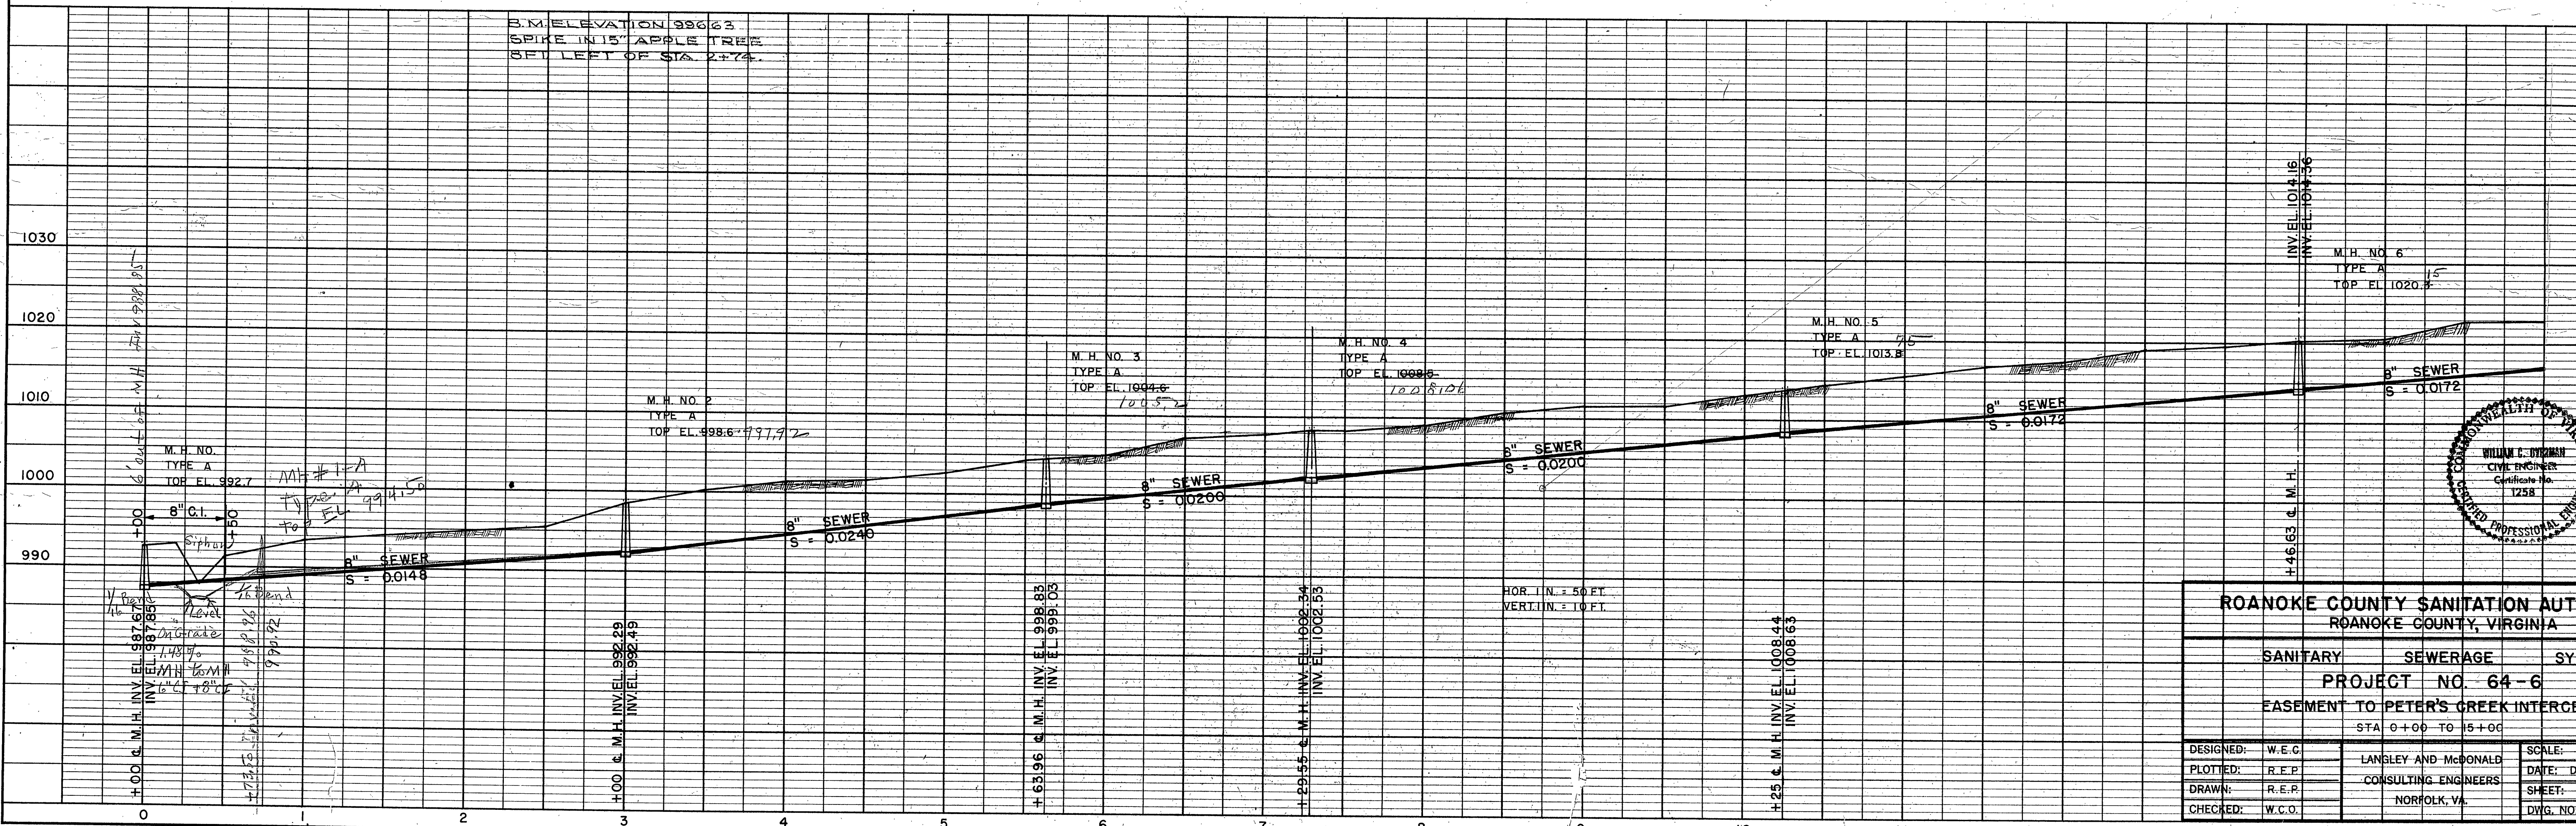

ROANOKE COUNTY SANITATION AUTHORITY ROANOKE COUNTY, VIRGINIA		
SANITARY	SEWERAGE	SYSTEM
PROJECT NO. 64-6		
EASEMENT TO PETER'S CREEK INTERCEPTOR		
STA 0+00 TO 15+00		
DESIGNED: W.E.C.	LANSLEY AND McDONALD	SCALE: AS SHOWN
PLOTTED: R.E.P.	CONSULTING ENGINEERS	DATE: DEC. 1, 1964
DRAWN: R.E.P.	NORFOLK, VA.	SHEET: 2 OF 34
CHECKED: W.C.O.		DWG. NO.: 6161175