
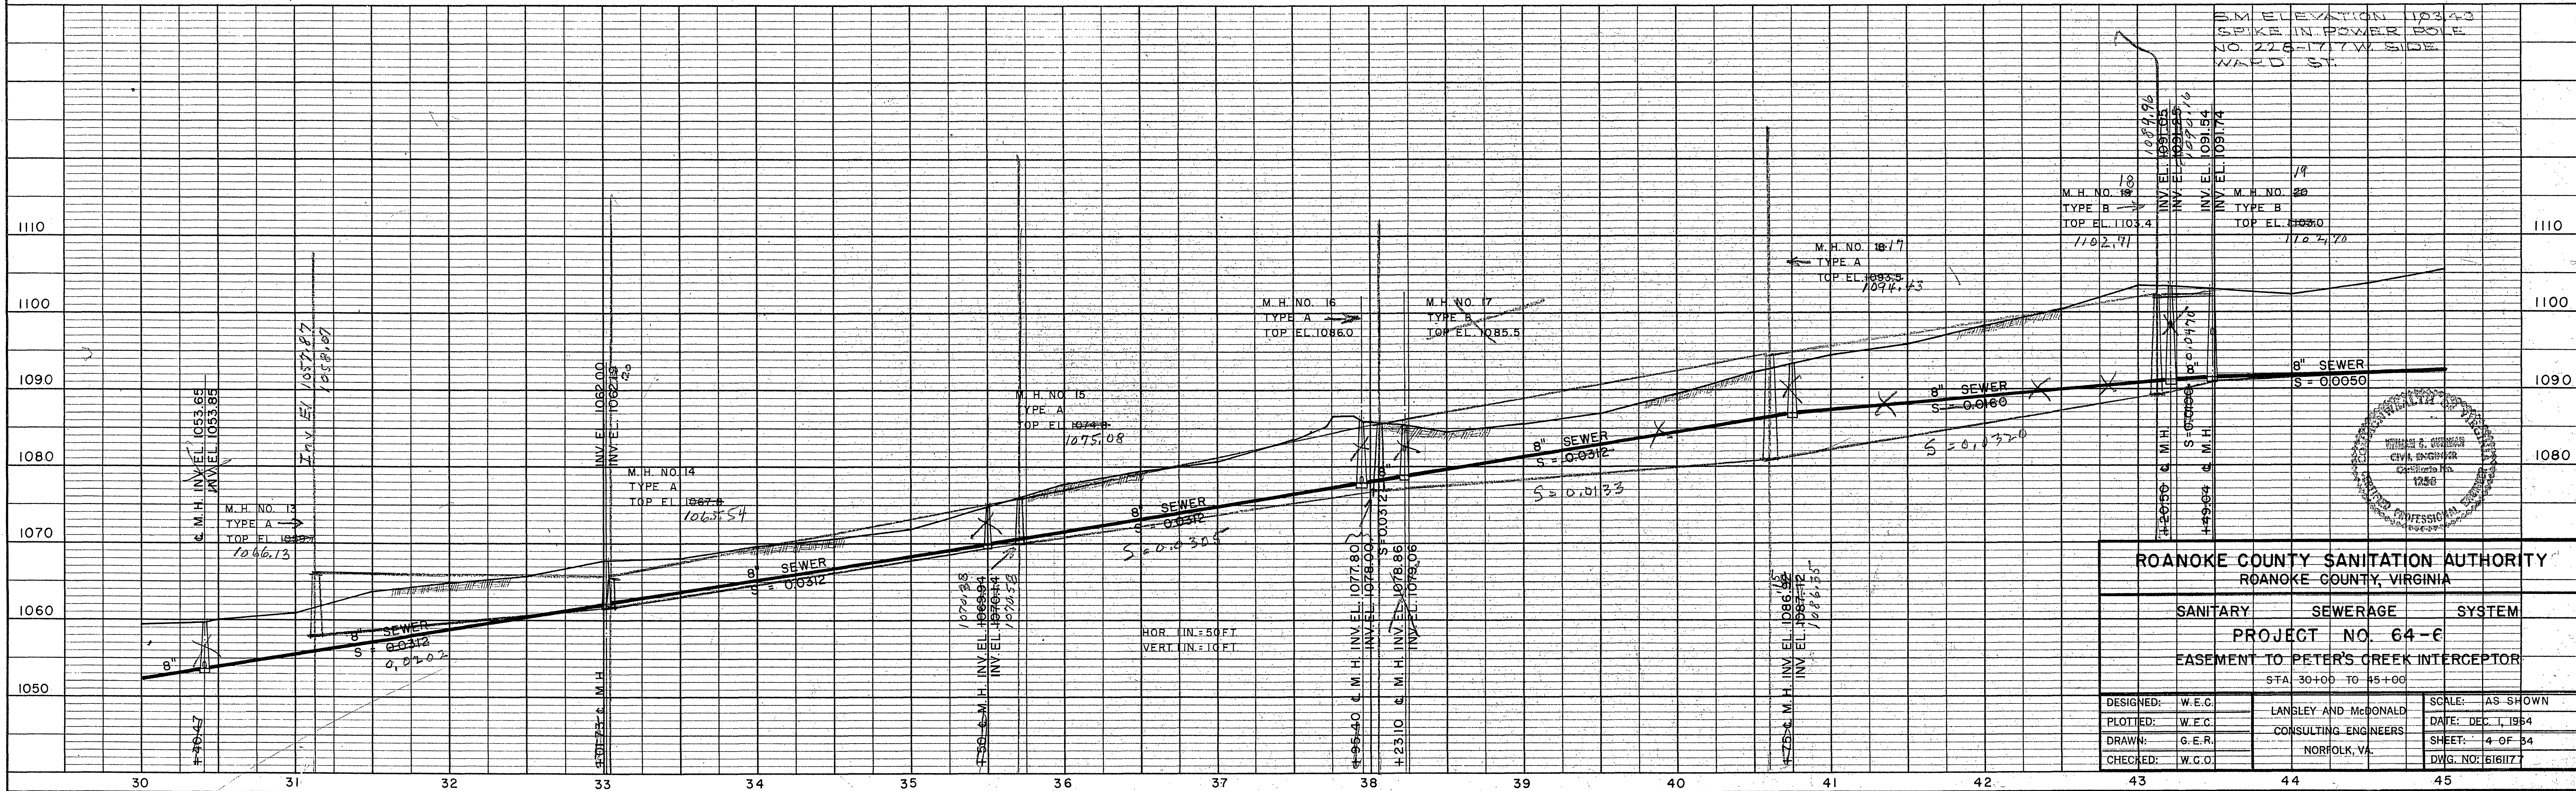


PLAN	DATE	BY	CHECKED
SURVEYED	10/15/54	W.E.C.	W.E.C.
PLOTTED	11/17/54	W.E.C.	W.E.C.
NOTE BOOK			
NO.			

PROFILE	DATE	BY	CHECKED
SURVEYED	10/15/54	W.E.C.	W.E.C.
PLOTTED	11/17/54	W.E.C.	W.E.C.
NOTE BOOK			
NO.			

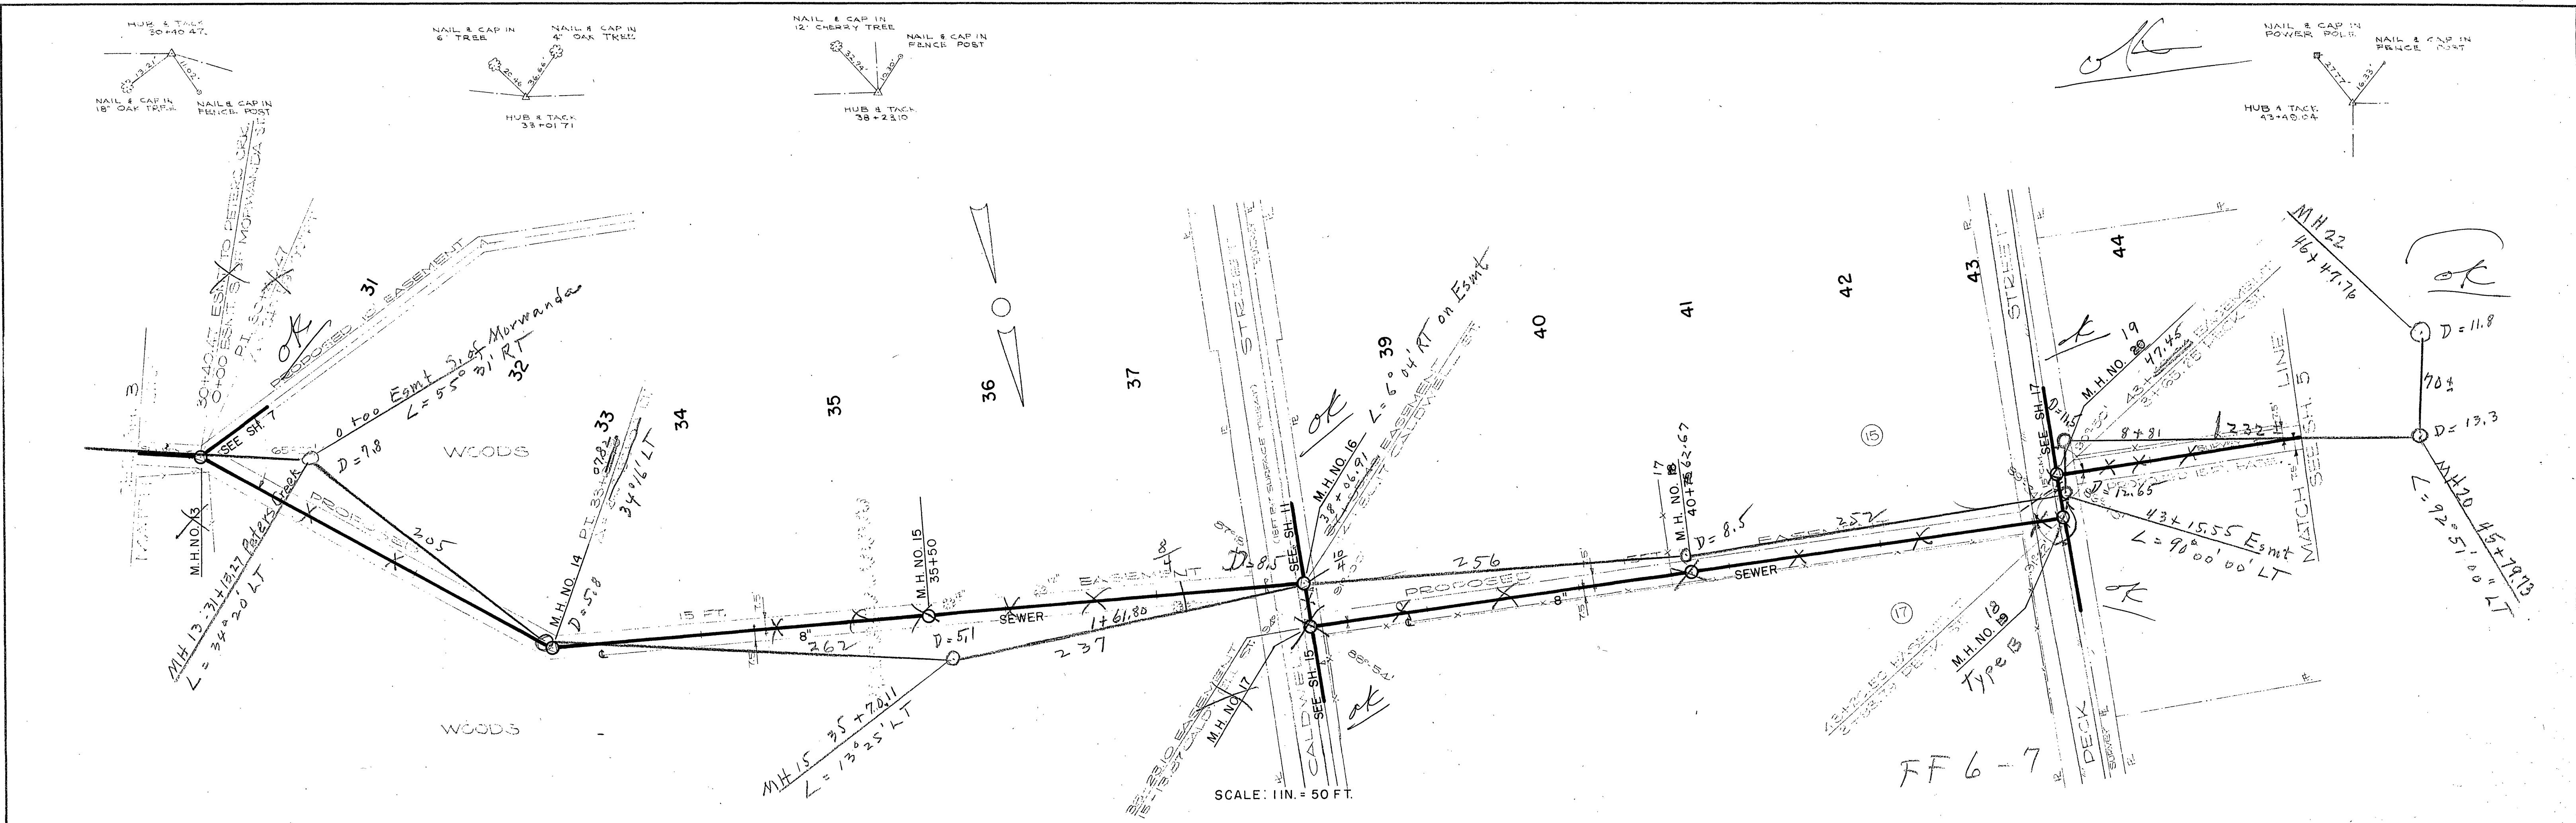

ROANOKE COUNTY SANITATION AUTHORITY ROANOKE COUNTY, VIRGINIA		
SANITARY	SEWERAGE	SYSTEM
PROJECT NO. 64-6		
EASEMENT TO PETER'S CREEK INTERCEPTOR		
STA. 30+00 TO 45+00		
DESIGNED: W.E.C.	LANSLY AND McDONALD	SCALE: AS SHOWN
PLOTTED: W.E.C.	CONSULTING ENGINEERS	DATE: DEC. 1, 1954
CHECKED: W.E.C.	NORFOLK, VA.	SHEET: 4 OF 54
		DWG. NO. 516117