

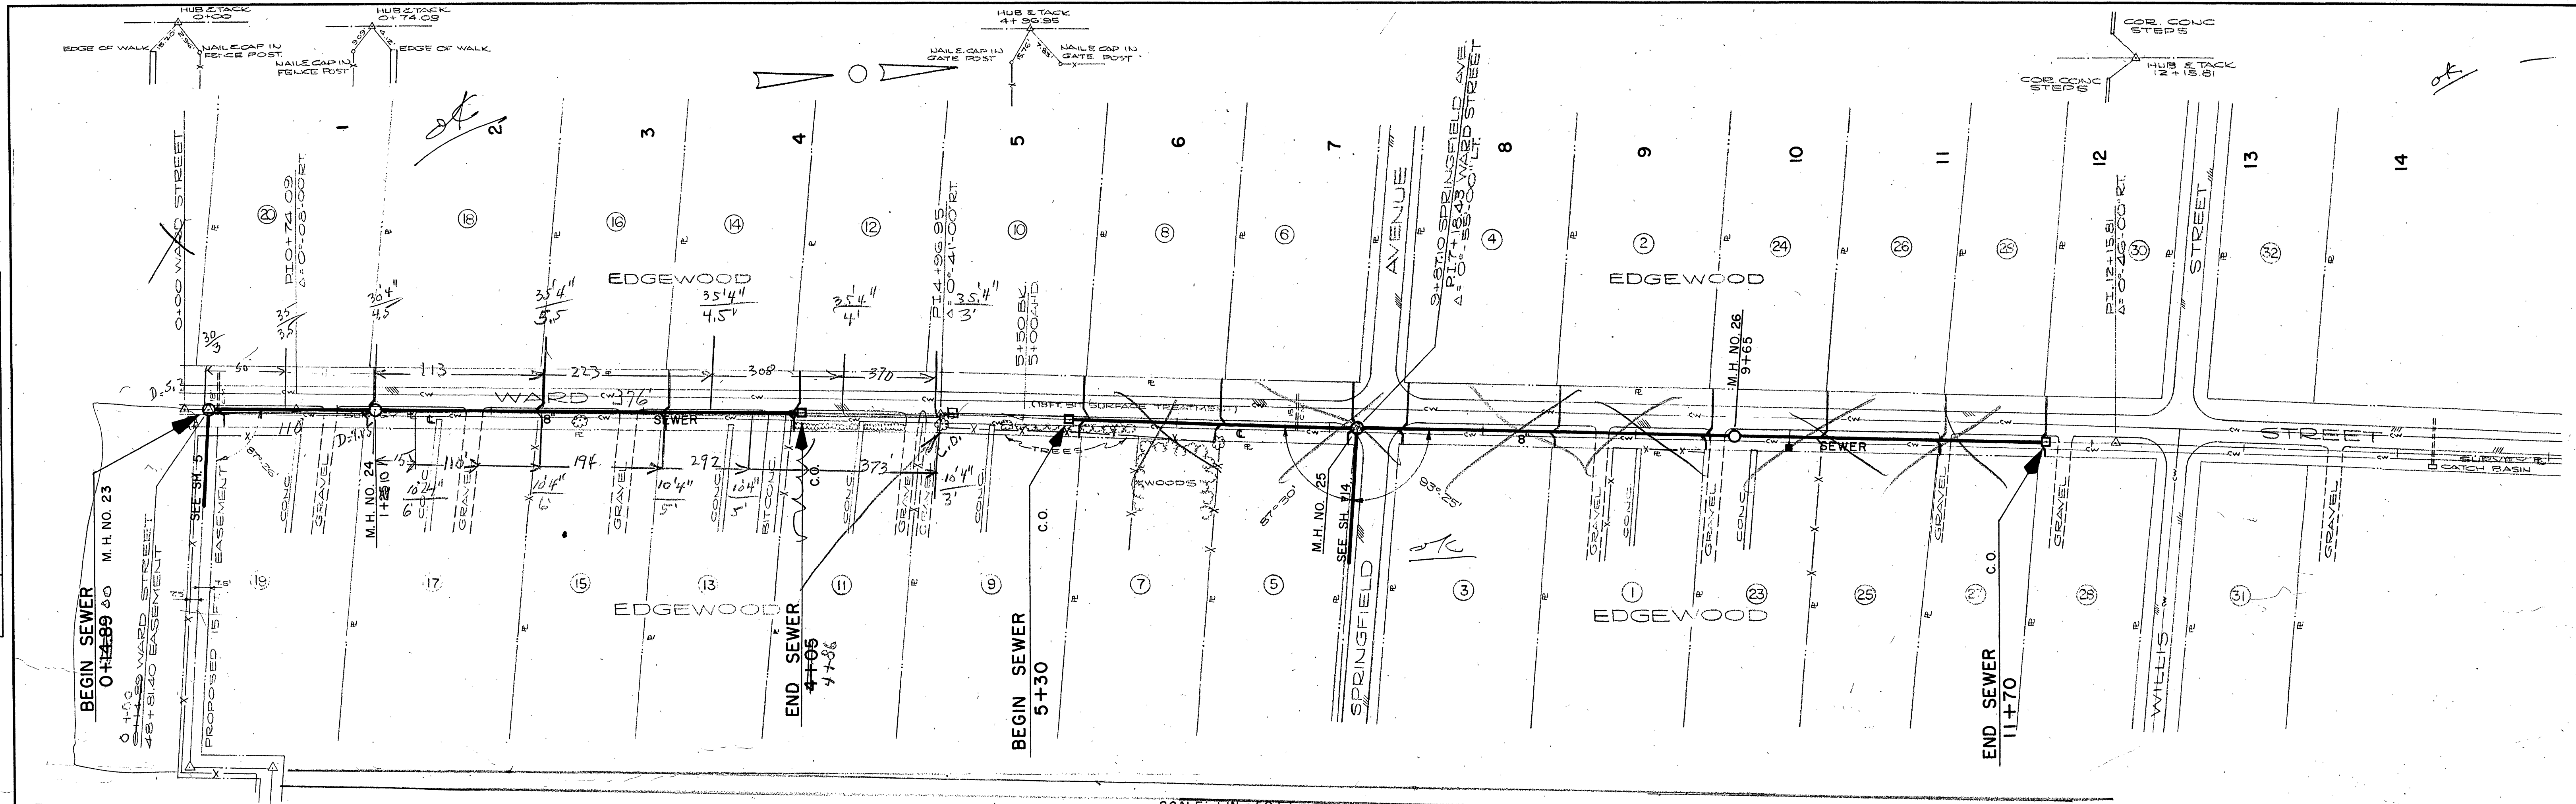


PLAN	DATE
SURVEYED	10-13-64
NOTED	10-13-64
NOTE BOOK	
NO.	

PROFILE	DATE
SURVEYED	10-13-64
NOTED	10-13-64
NOTE BOOK	
NO.	

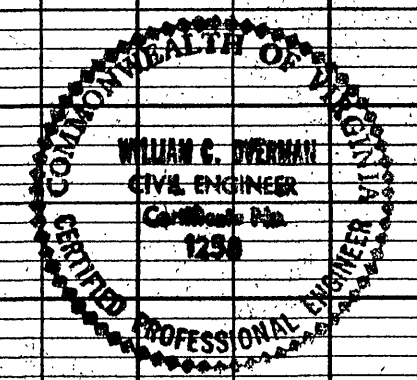

SCALE: 1 IN. = 50 FT.

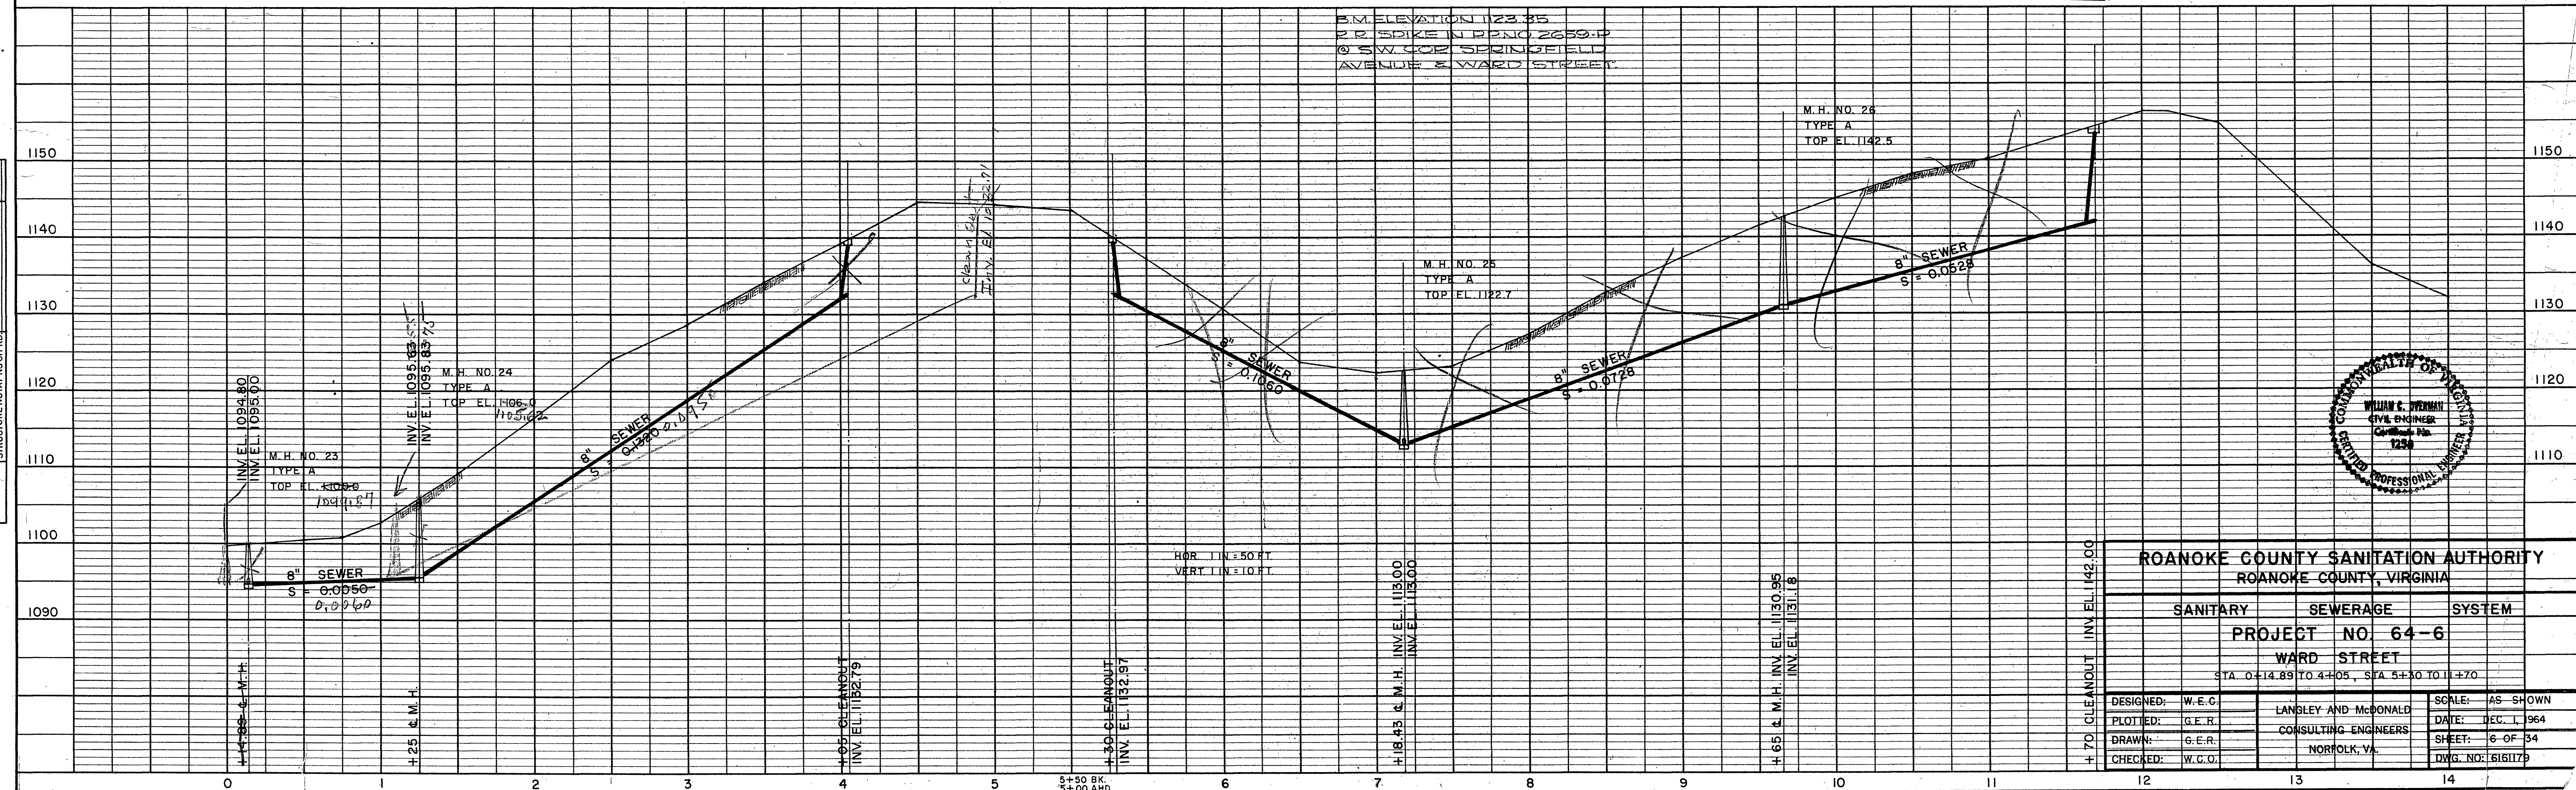

ROANOKE COUNTY SANITATION AUTHORITY ROANOKE COUNTY, VIRGINIA		
SANITARY	SEWERAGE	SYSTEM
PROJECT NO. 64-6		
WARD STREET		
STA. 0+14.89 TO 4+05, STA. 5+30 TO 11+70		
DESIGNED: W.E.C.	LANGLEY AND McDONALD	SCALE: AS SHOWN
PLOTTED: G.E.R.	CONSULTING ENGINEERS	DATE: DEC. 1, 1964
DRAWN: G.E.R.	NORFOLK, VA.	SHEET: 6 OF 34
CHECKED: W.C.O.		DWG. NO: 6161179