
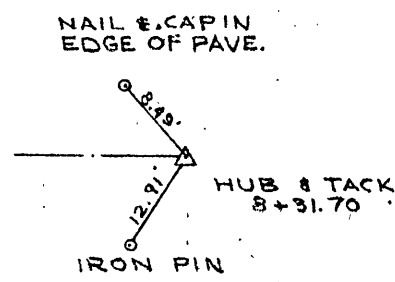




PLAN	DATE
SURVEYED BY J.G.B.	9/27/64
NOTED BY J.G.B.	9/27/64
NOTE BOOK NO.	

PROFILE	DATE
SURVEYED BY J.G.B.	9/27/64
NOTED BY J.G.B.	9/27/64
NOTE BOOK NO.	

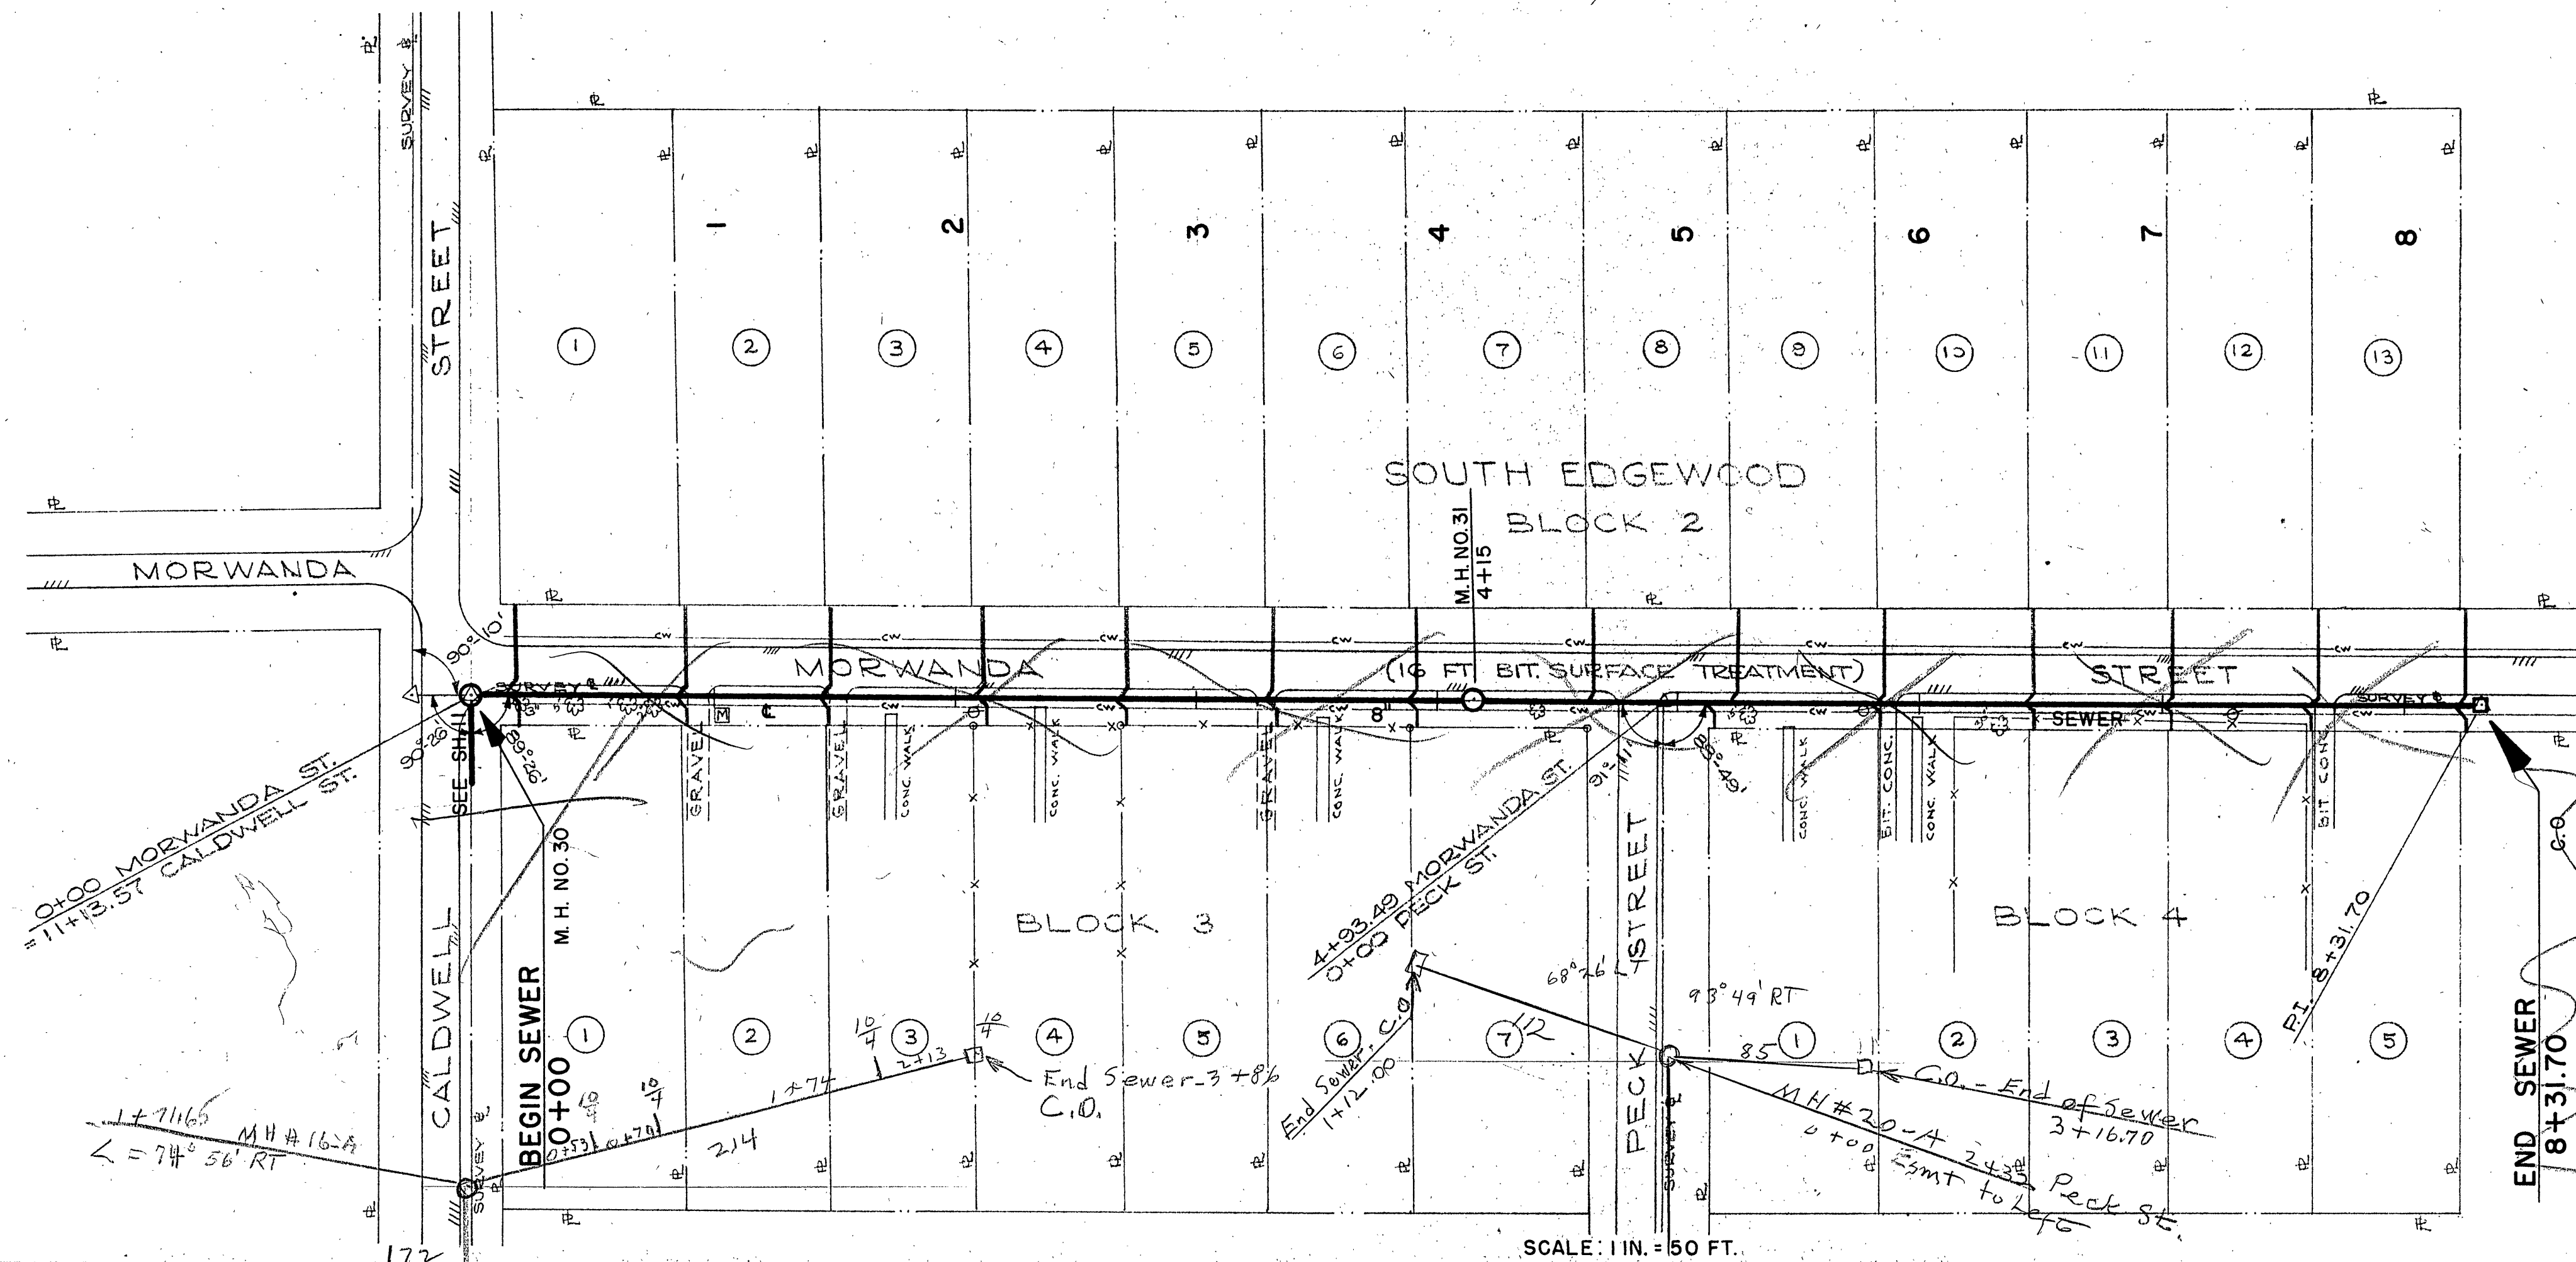

1.72
1.72
2.14
5.58

FF 6

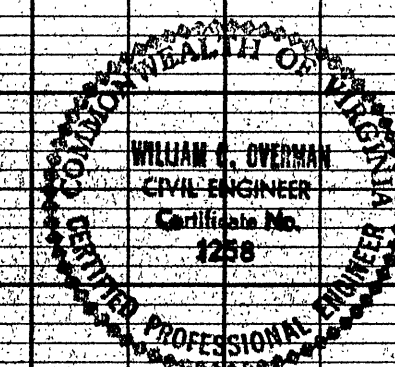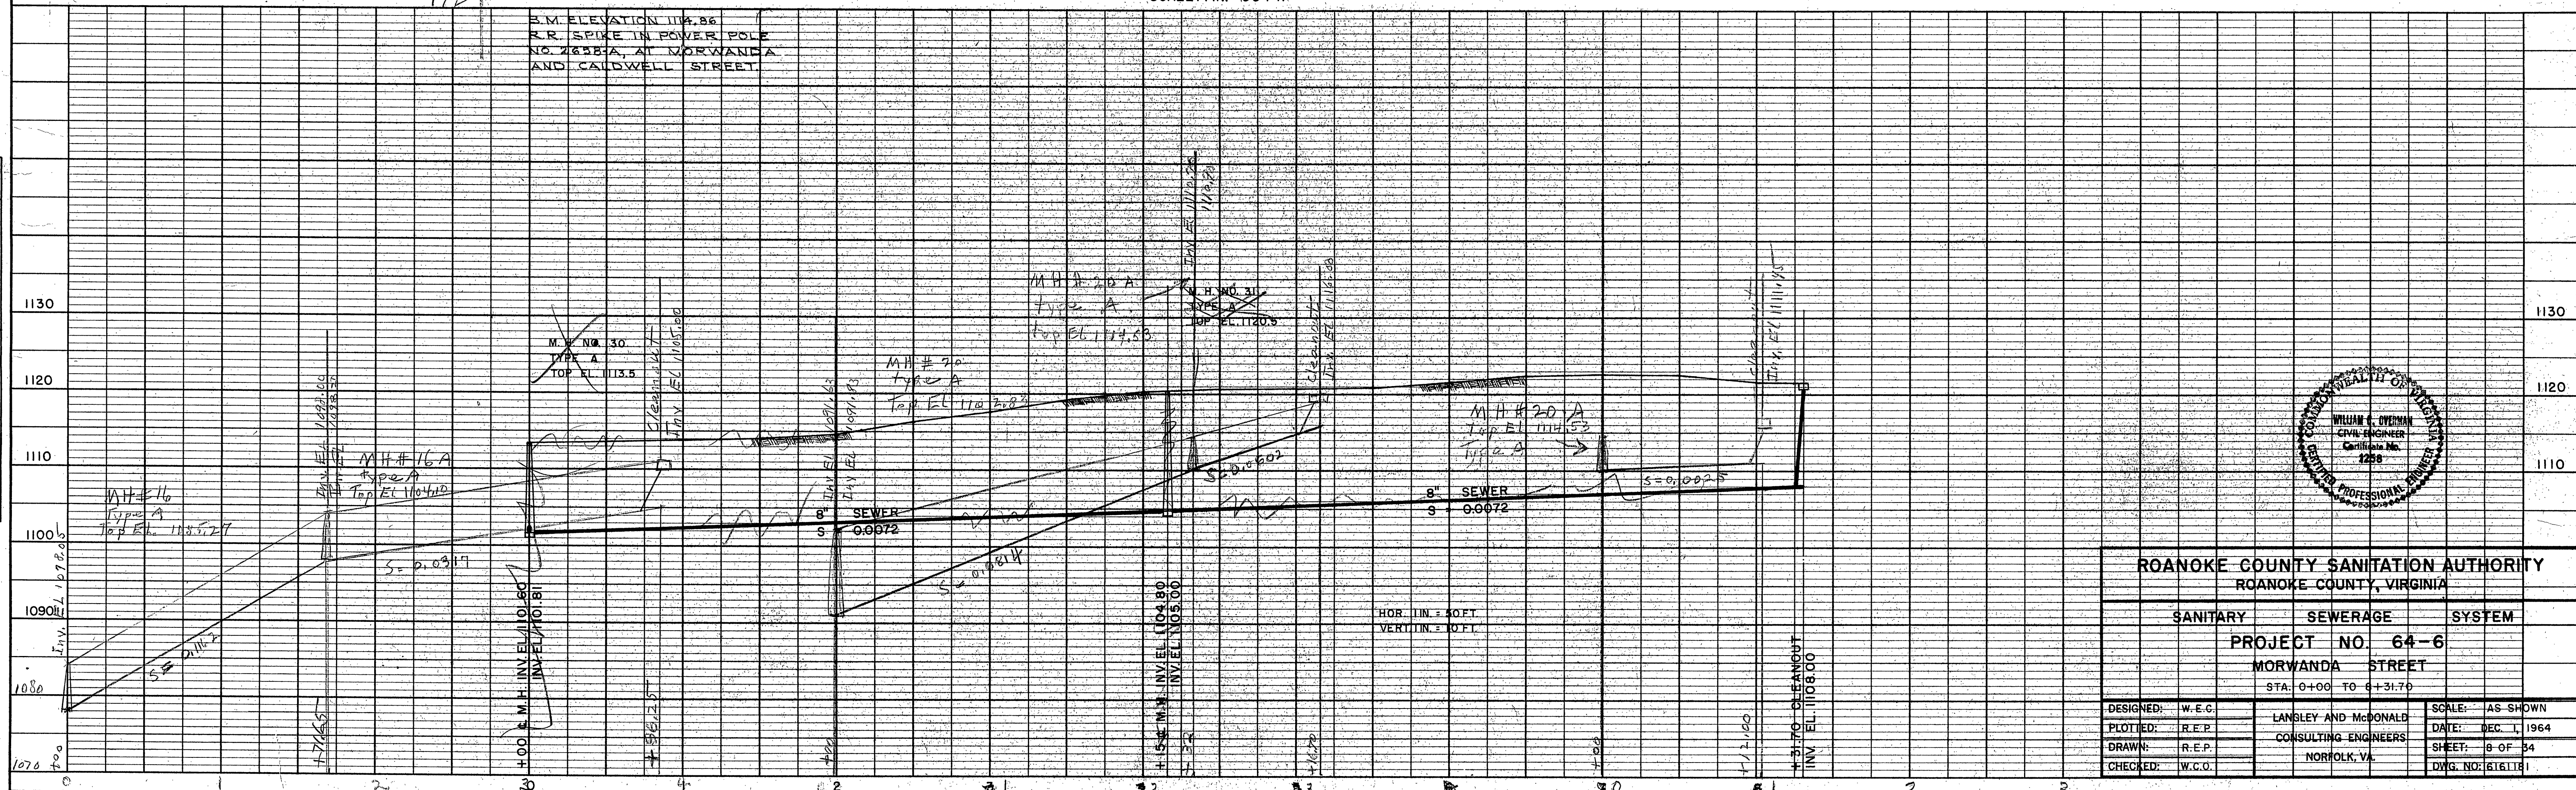

ROANOKE COUNTY SANITATION AUTHORITY ROANOKE COUNTY, VIRGINIA		
SANITARY	SEWERAGE	SYSTEM
PROJECT NO. 64-6 MORWANDA STREET		
STA. 0+00 TO 8+31.70		
DESIGNED: W.E.C.	LANGLEY AND McDONALD	SCALE: AS SHOWN
PLOTTED: R.E.P.	CONSULTING ENGINEERS	DATE: DEC. 1, 1964
DRAWN: R.E.P.	NORFOLK, VA.	SHEET: 8 OF 34
CHECKED: W.C.O.		DWG. NO: 616118