

NO.	B. M. NOTED	DATE
NOTE BOOK	GRADES CHECKED	11/17/64
PROFILE	SURVEYED	11/15/64
	BY	
	J.G.B.	
	R.E.B.	

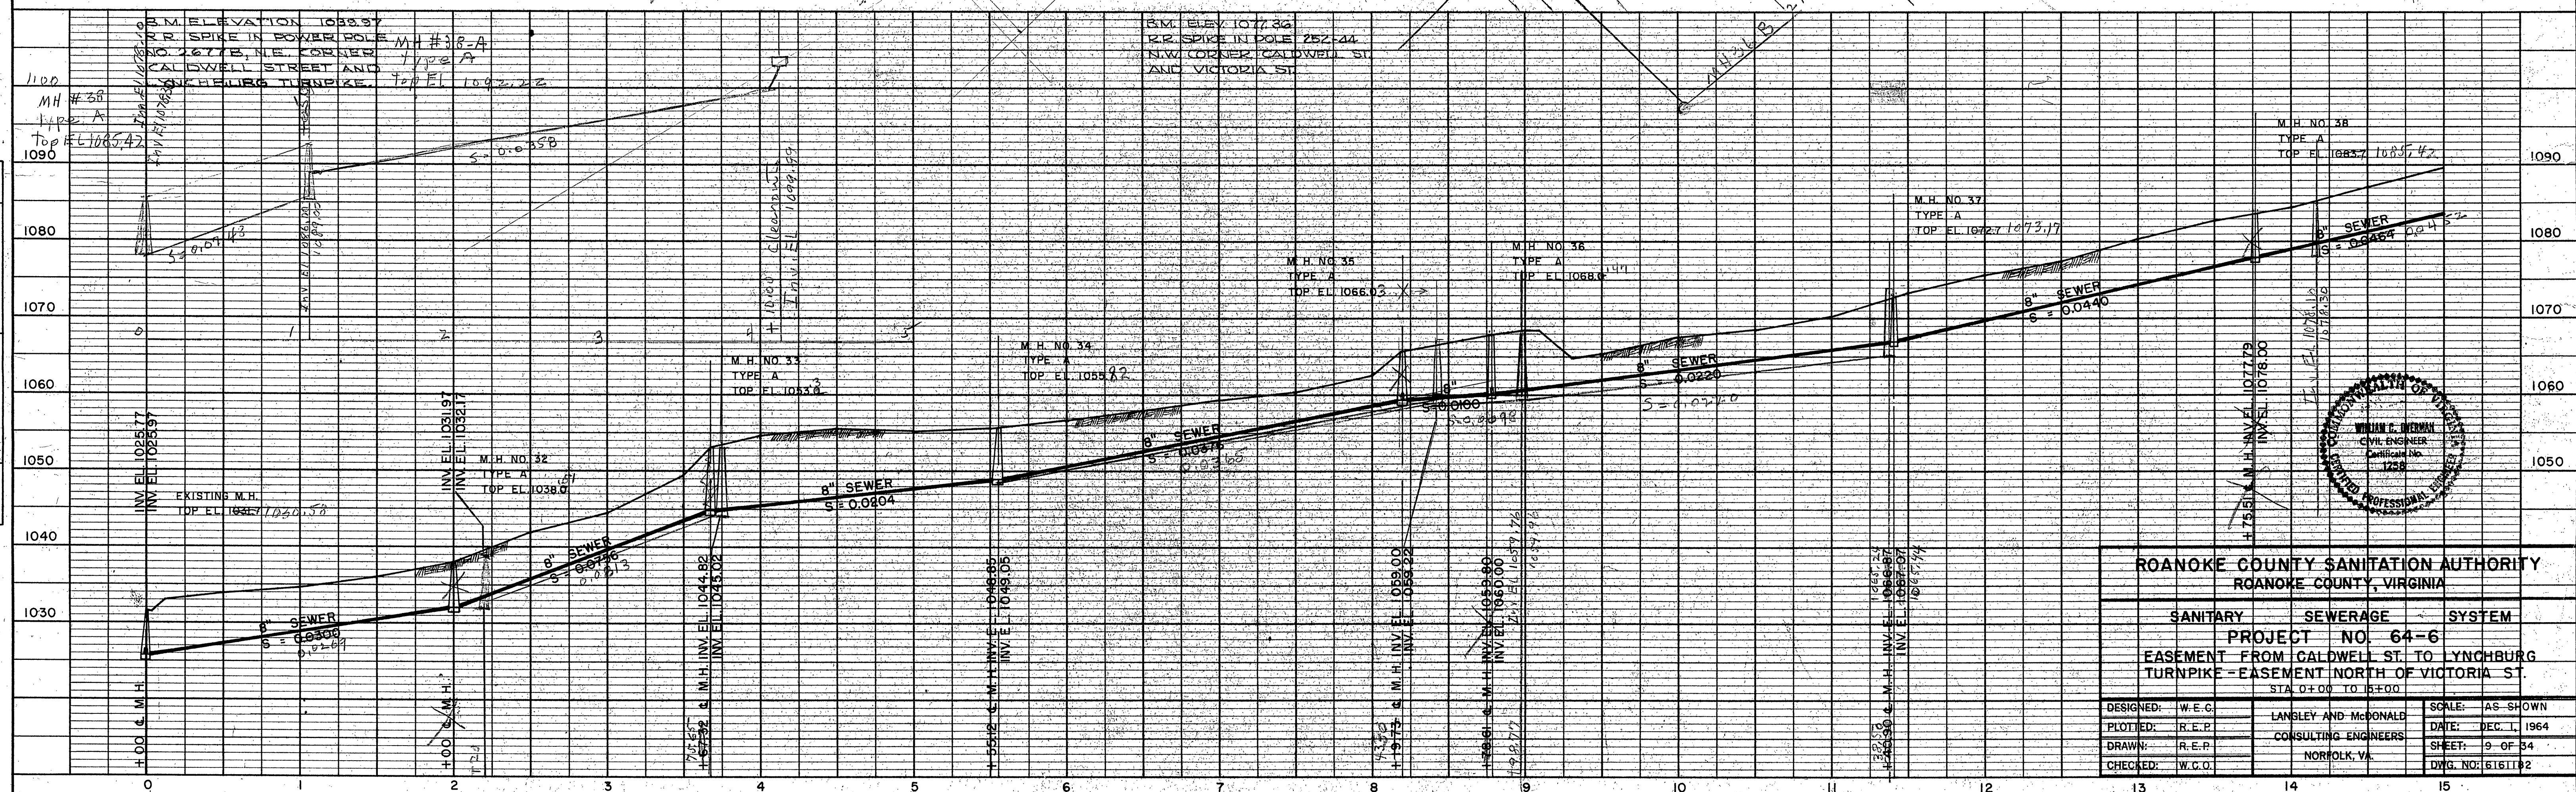


PLATE 1 - PLAN - PROFILE O. P. R. & R. E. STANDARD
OGILVIE PRESS, INC., BROOKLYN 17, N. Y.