
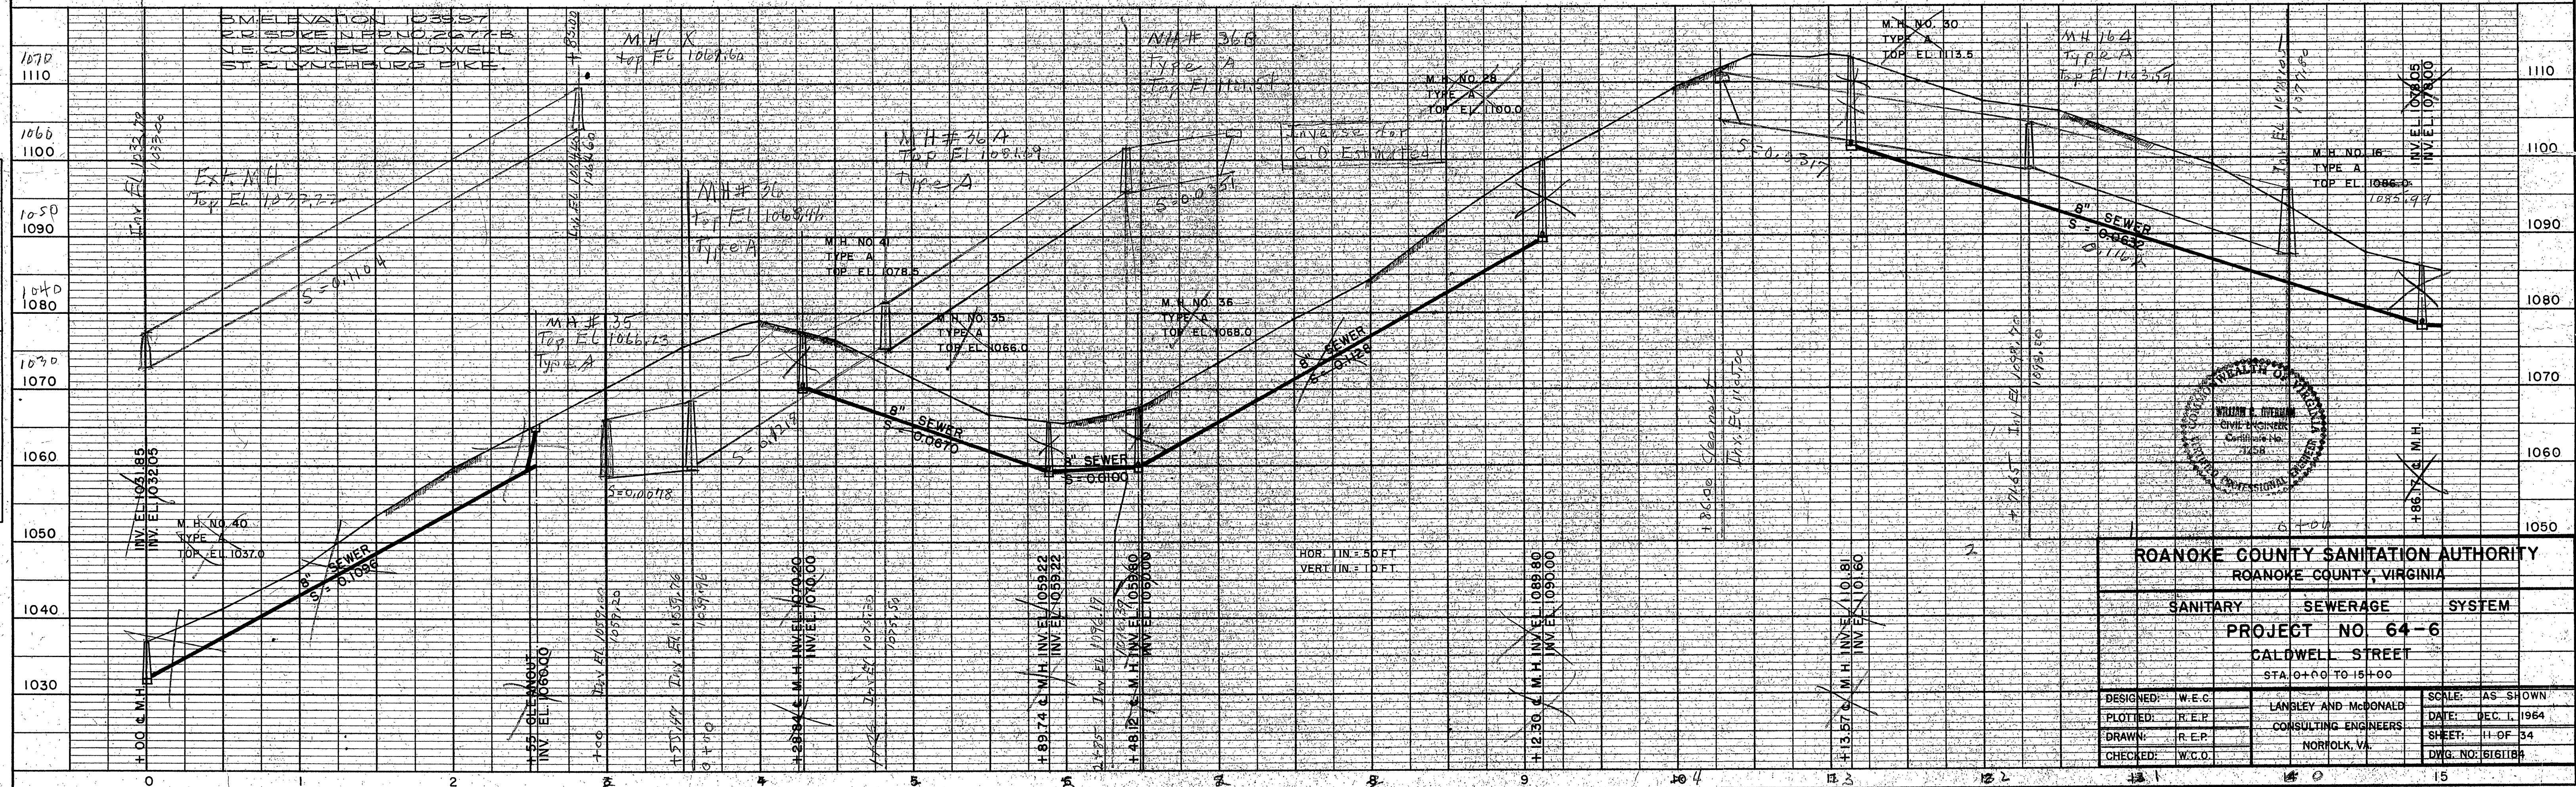


PLAN	DATE	BY
SURVEYED	5/14/44	W.E.C.
NOTED	5/14/44	W.E.C.
PLOTTED	5/14/44	W.E.C.
ALIGNMENT CHECKED		
RT. OF WAY CHECKED		
NO.		

PROFILE	DATE	BY
SURVEYED	5/14/44	W.E.C.
NOTED	5/14/44	W.E.C.
PLOTTED	5/14/44	W.E.C.
GRADES CHECKED		
B. M. NOTED		
STRUCTURE NOTATIONS (HFO)		
NO.		

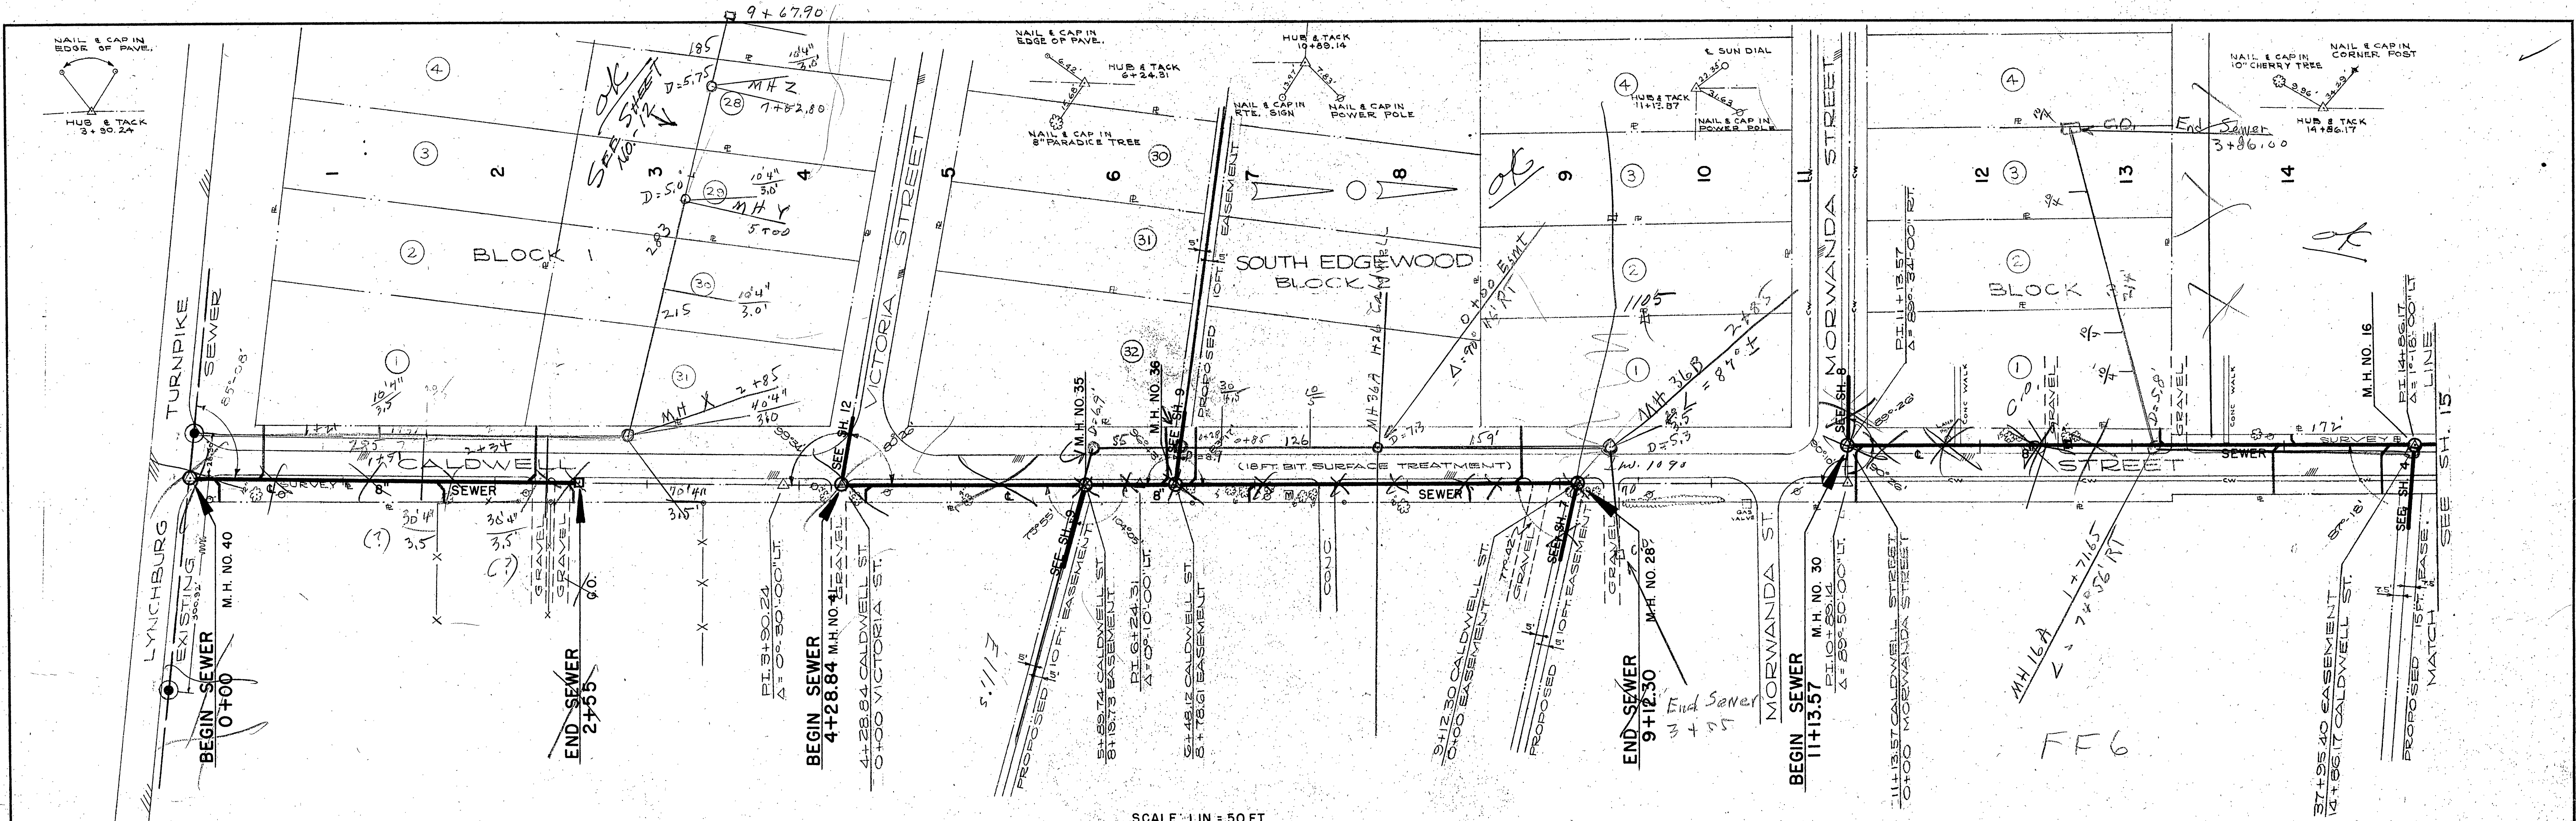

ROANOKE COUNTY SANITATION AUTHORITY		
ROANOKE COUNTY, VIRGINIA		
SANITARY	SEWERAGE	SYSTEM
PROJECT NO. 64-6		
CALDWELL STREET		
STA. 0+00 TO 15+00		
DESIGNED: W.E.C.	LANBLEY AND McDONALD	SCALE: AS SHOWN
PLOTTED: R.E.P.	CONSULTING ENGINEERS	DATE: DEC. 1, 1964
DRAWN: R.E.P.	NORFOLK, VA.	SHEET: 11 OF 34
CHECKED: W.C.O.		DWG. NO. 161618