

|                |                           |          |         |
|----------------|---------------------------|----------|---------|
| <b>PROFILE</b> | SURVIVED                  | BY ..... | DATE    |
| NOTE BOOK:     | GRADES CHECKED            | RGB      | 9/15/74 |
| NO.            | B. M. NOTED               | RGB      | 9/18/74 |
|                | STRUCTURE NOTATIONS CH'KO |          |         |

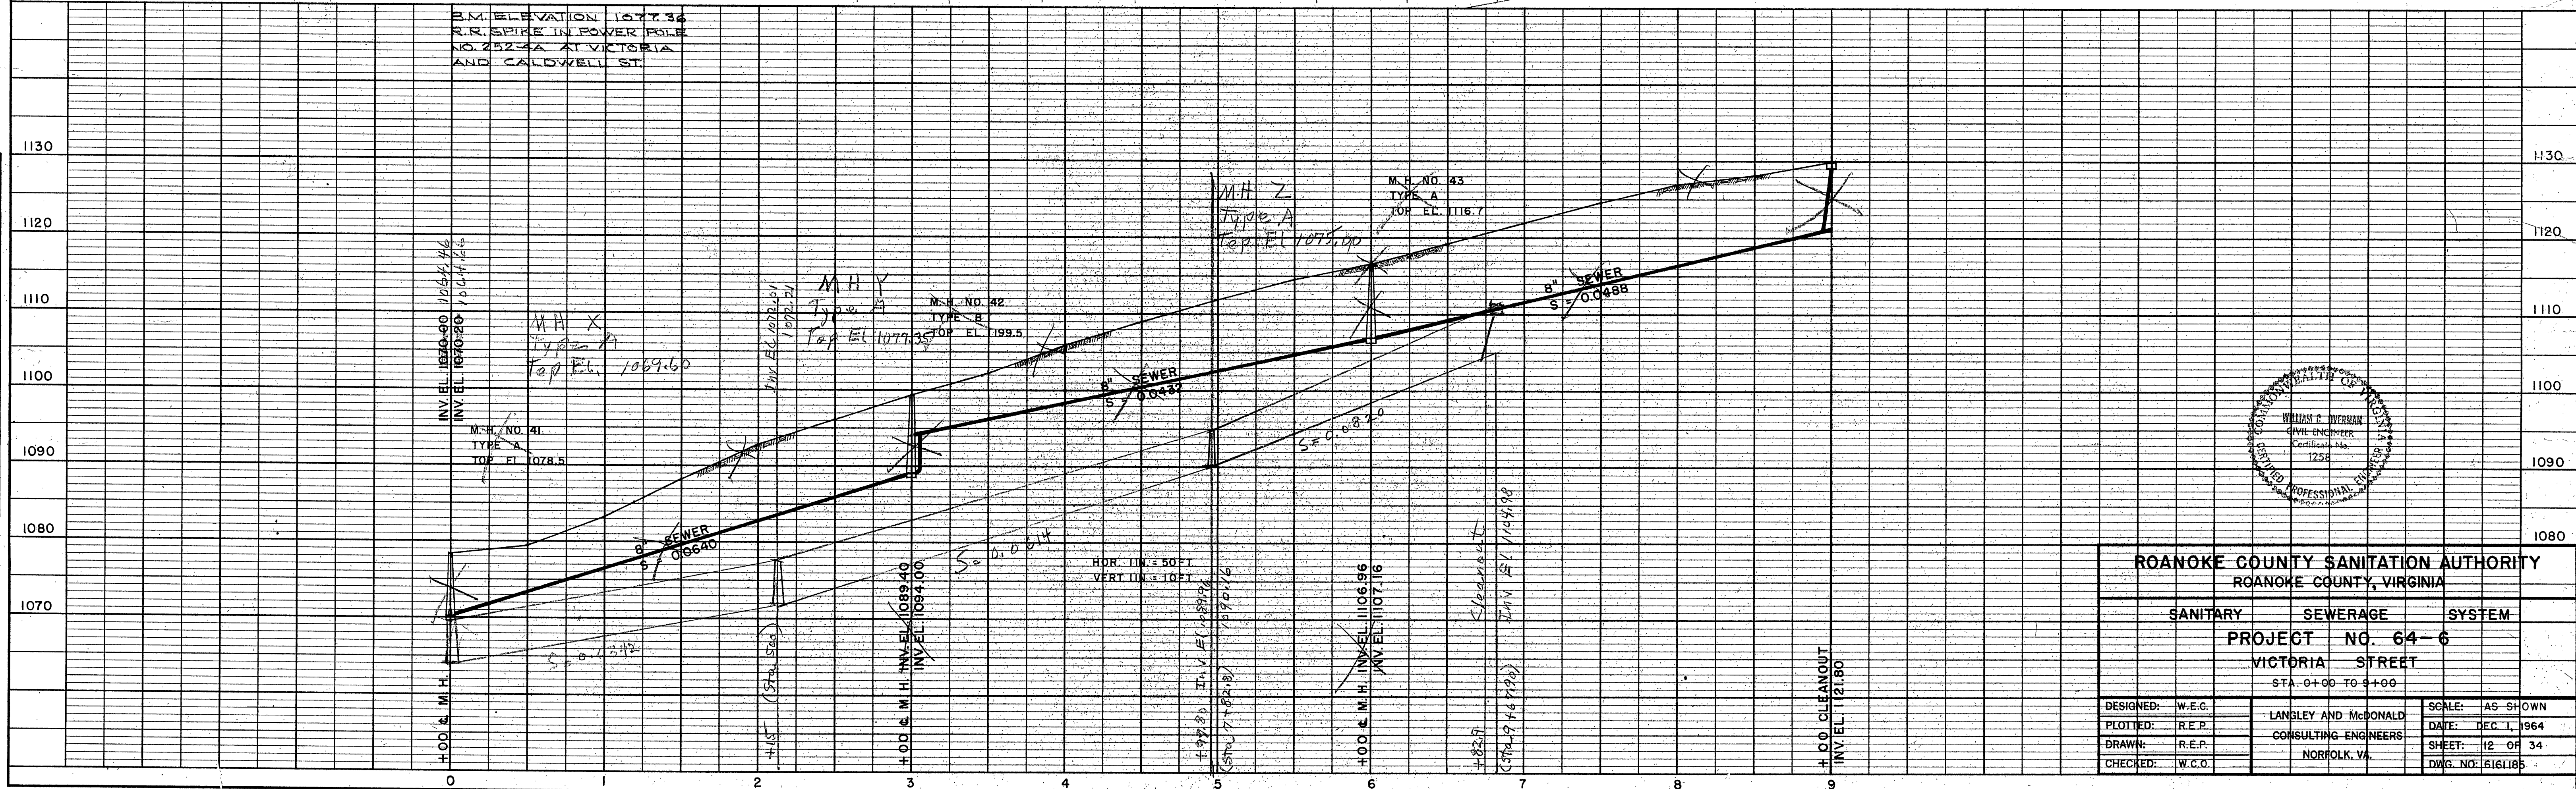


PLATE 1 - PLAN - PROFILE O. P. R. & R. E. STANDARD  
OGILVIE PRESS, INC., BROOKLYN 17, N. Y.