

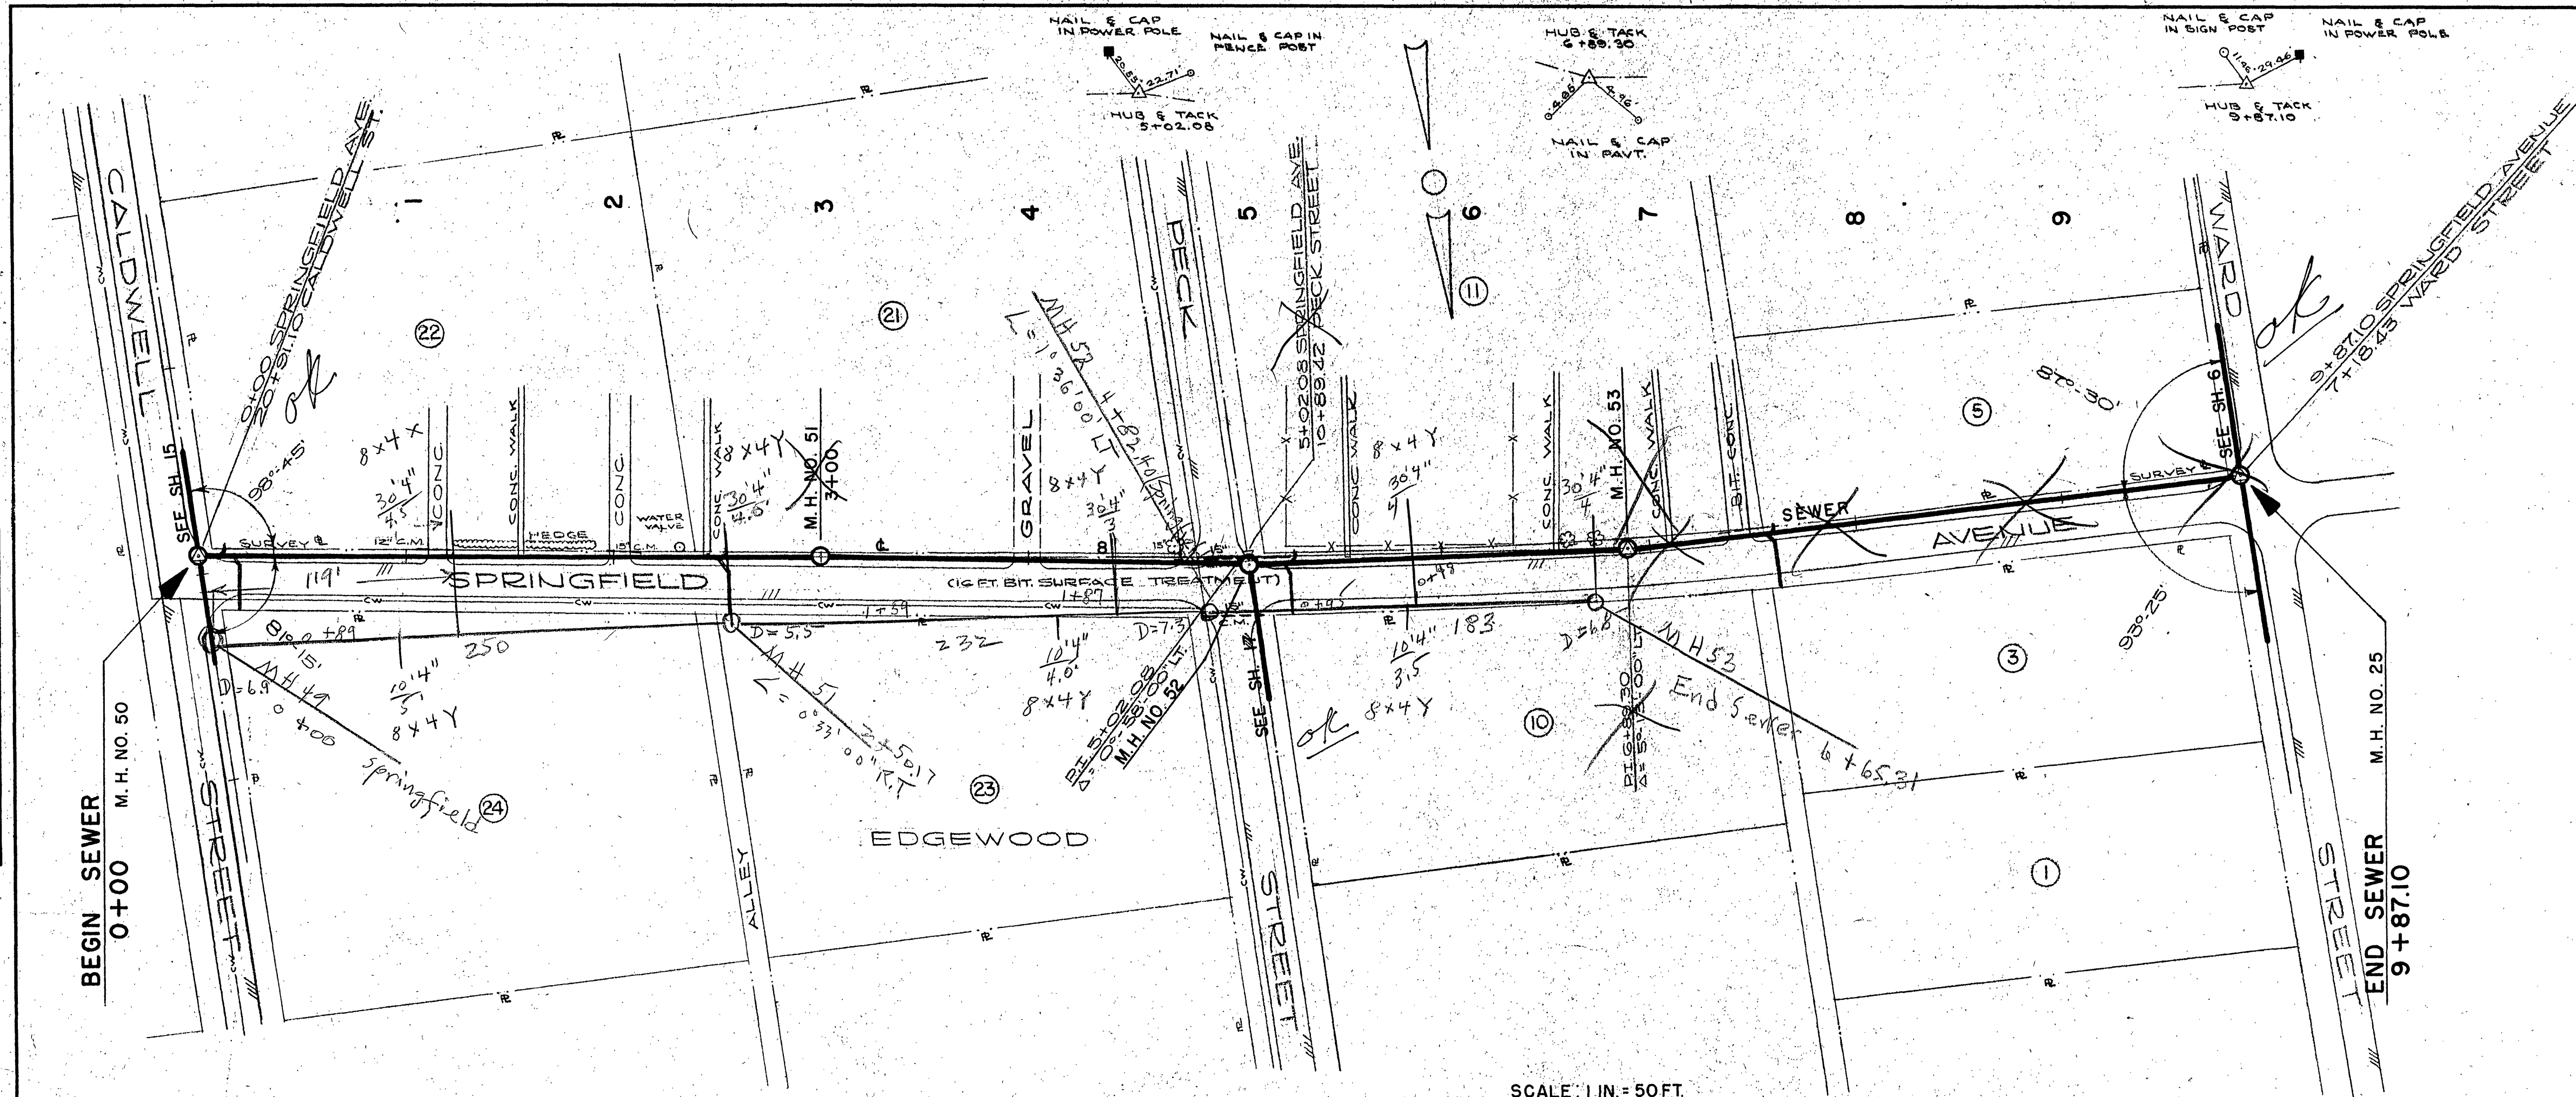


PLAN	DATE	BY
SURVEYED	9/23/64	W.B.
PLOTTED	10/1/64	T.D.H.
NOTE BOOK	GRADES CHECKED	
NO.	STRUCTURE NOTATIONS CHK'D	

PROFILE	DATE	BY
SURVEYED	9/23/64	W.B.
PLOTTED	10/1/64	T.D.H.
NOTE BOOK	GRADES CHECKED	
NO.	STRUCTURE NOTATIONS CHK'D	

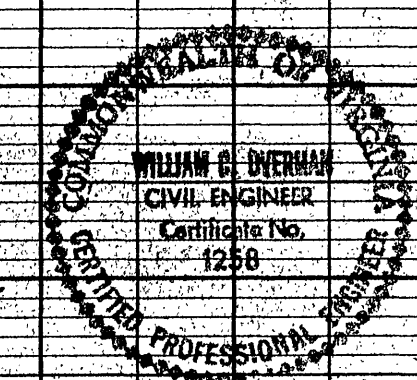

SCALE: 1" = 50 FT.

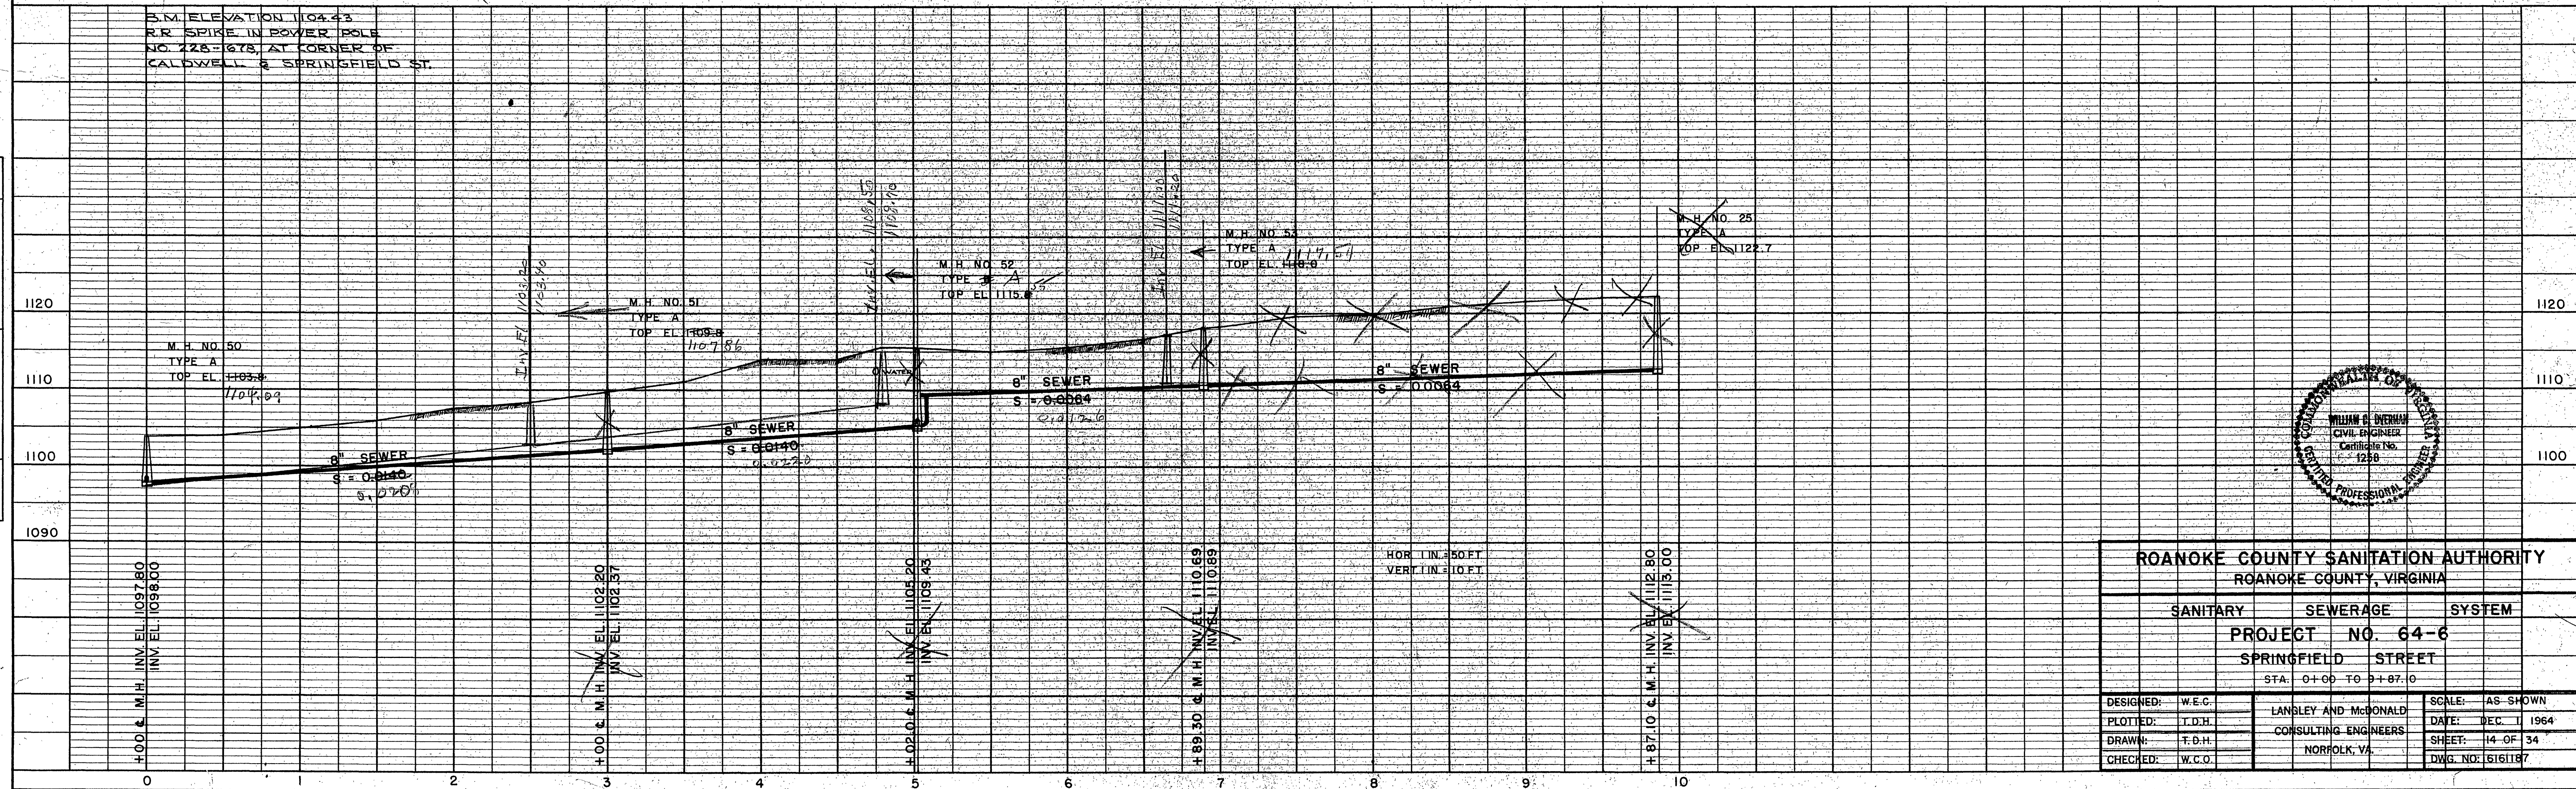

ROANOKE COUNTY SANITATION AUTHORITY ROANOKE COUNTY, VIRGINIA		
SANITARY	SEWERAGE	SYSTEM
PROJECT NO. 64-6 SPRINGFIELD STREET STA. 0+00 TO 9+87.10		
DESIGNED: W.E.C.	LANDLEY AND McDONALD	SCALE: AS SHOWN
PLOTTED: T.D.H.	CONSULTING ENGINEERS	DATE: DEC. 1 1964
DRAWN: T.D.H.	NORFOLK, VA.	SHEET: 14 OF 34
CHECKED: W.C.O.		DWG. NO: 5161187