
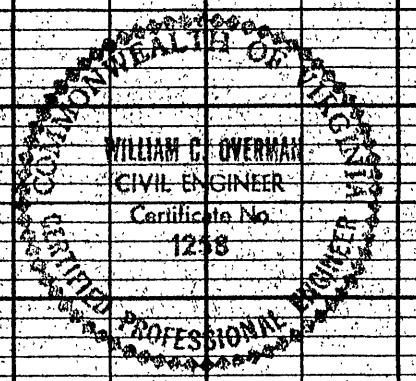
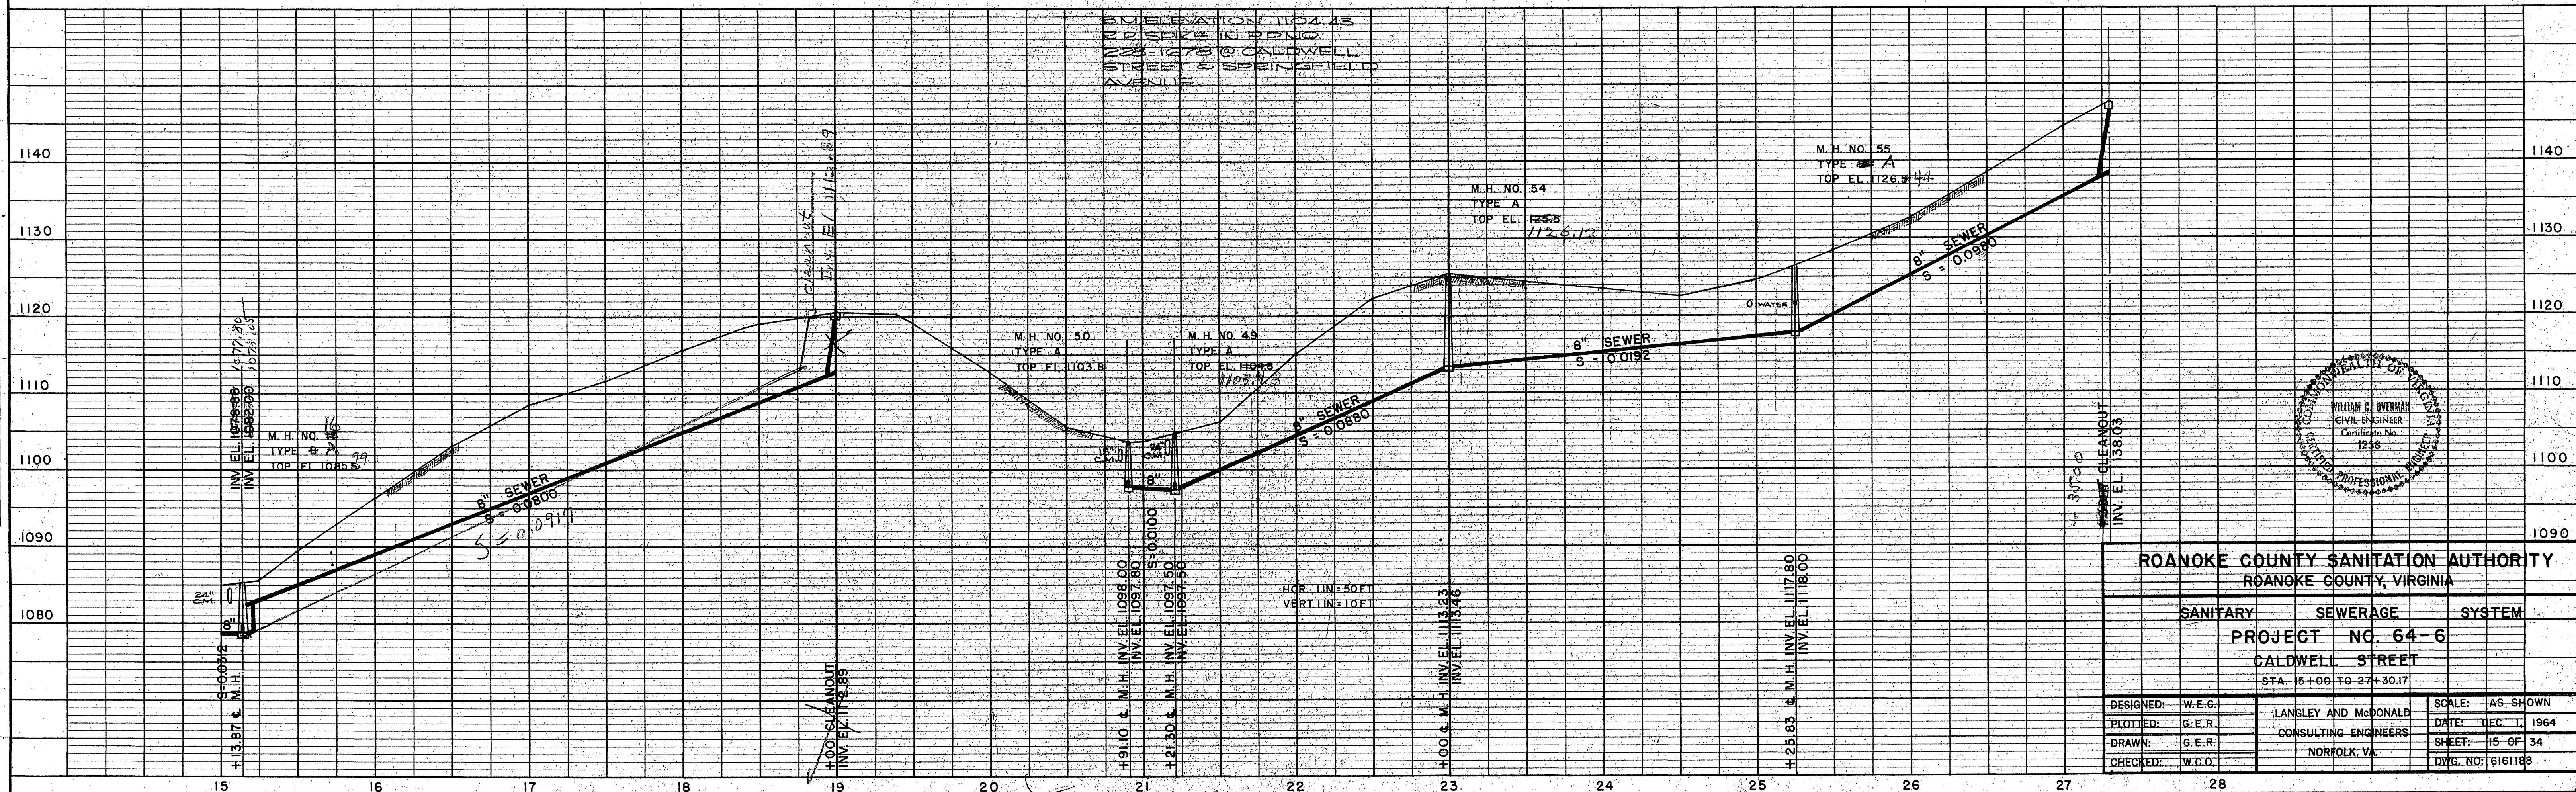


PLAN	DATE	BY
SURVEYED	5/15/64	J.G.B.
PLOTTED	5/23/64	G.E.R.
NOTE BOOK		
NO.		

PROFILE	DATE	BY
SURVEYED	5/15/64	J.G.B.
PLOTTED	5/23/64	G.E.R.
NOTE BOOK		
NO.		

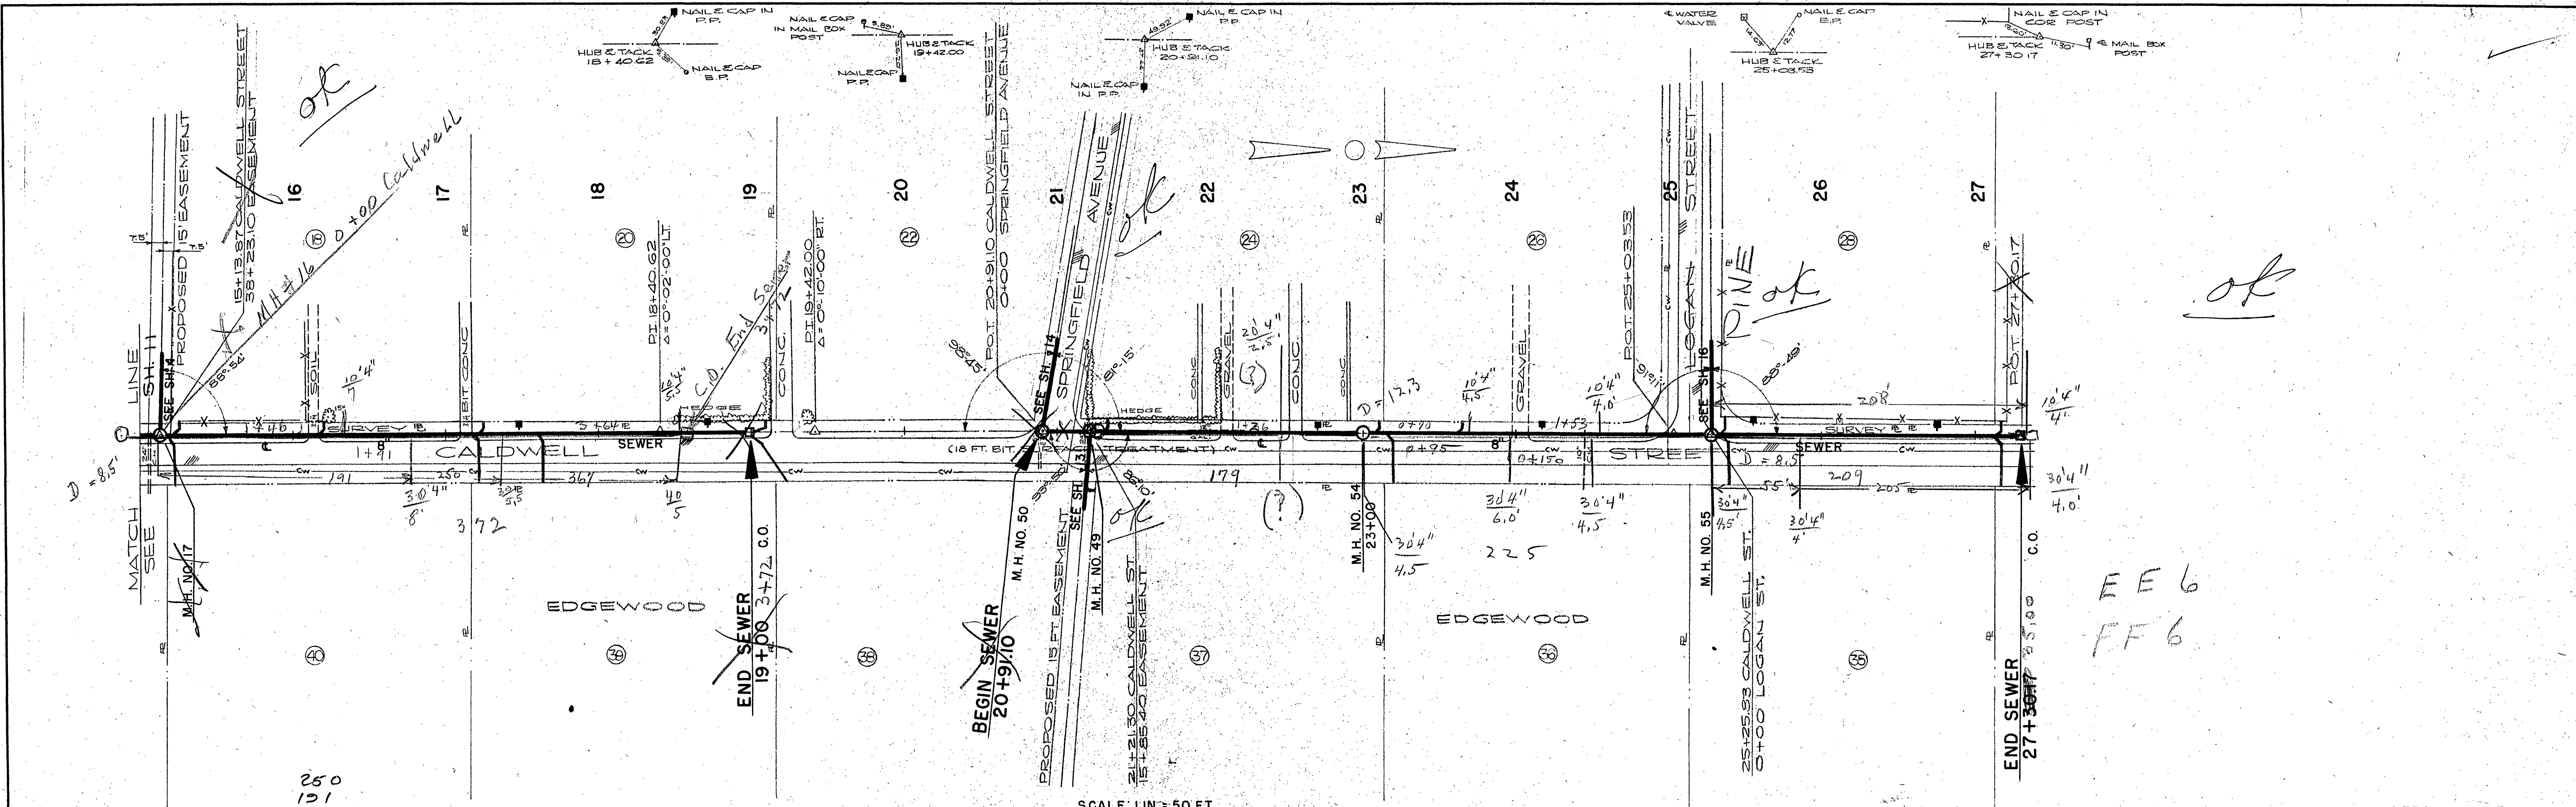

ROANOKE COUNTY SANITATION AUTHORITY ROANOKE COUNTY, VIRGINIA		
SANITARY	SEWERAGE	SYSTEM
PROJECT NO. 64-6		
CALDWELL STREET		
STA. 15+00 TO 27+30.17		
DESIGNED: W.E.G.	LANGLEY AND McDONALD	SCALE: AS SHOWN
PLOTTED: G.E.R.	CONSULTING ENGINEERS	DATE: DEC. 1, 1964
DRAWN: G.E.R.	NORFOLK, VA.	SHEET: 15 OF 34
CHECKED: W.C.O.		DWG. NO: 6161188